

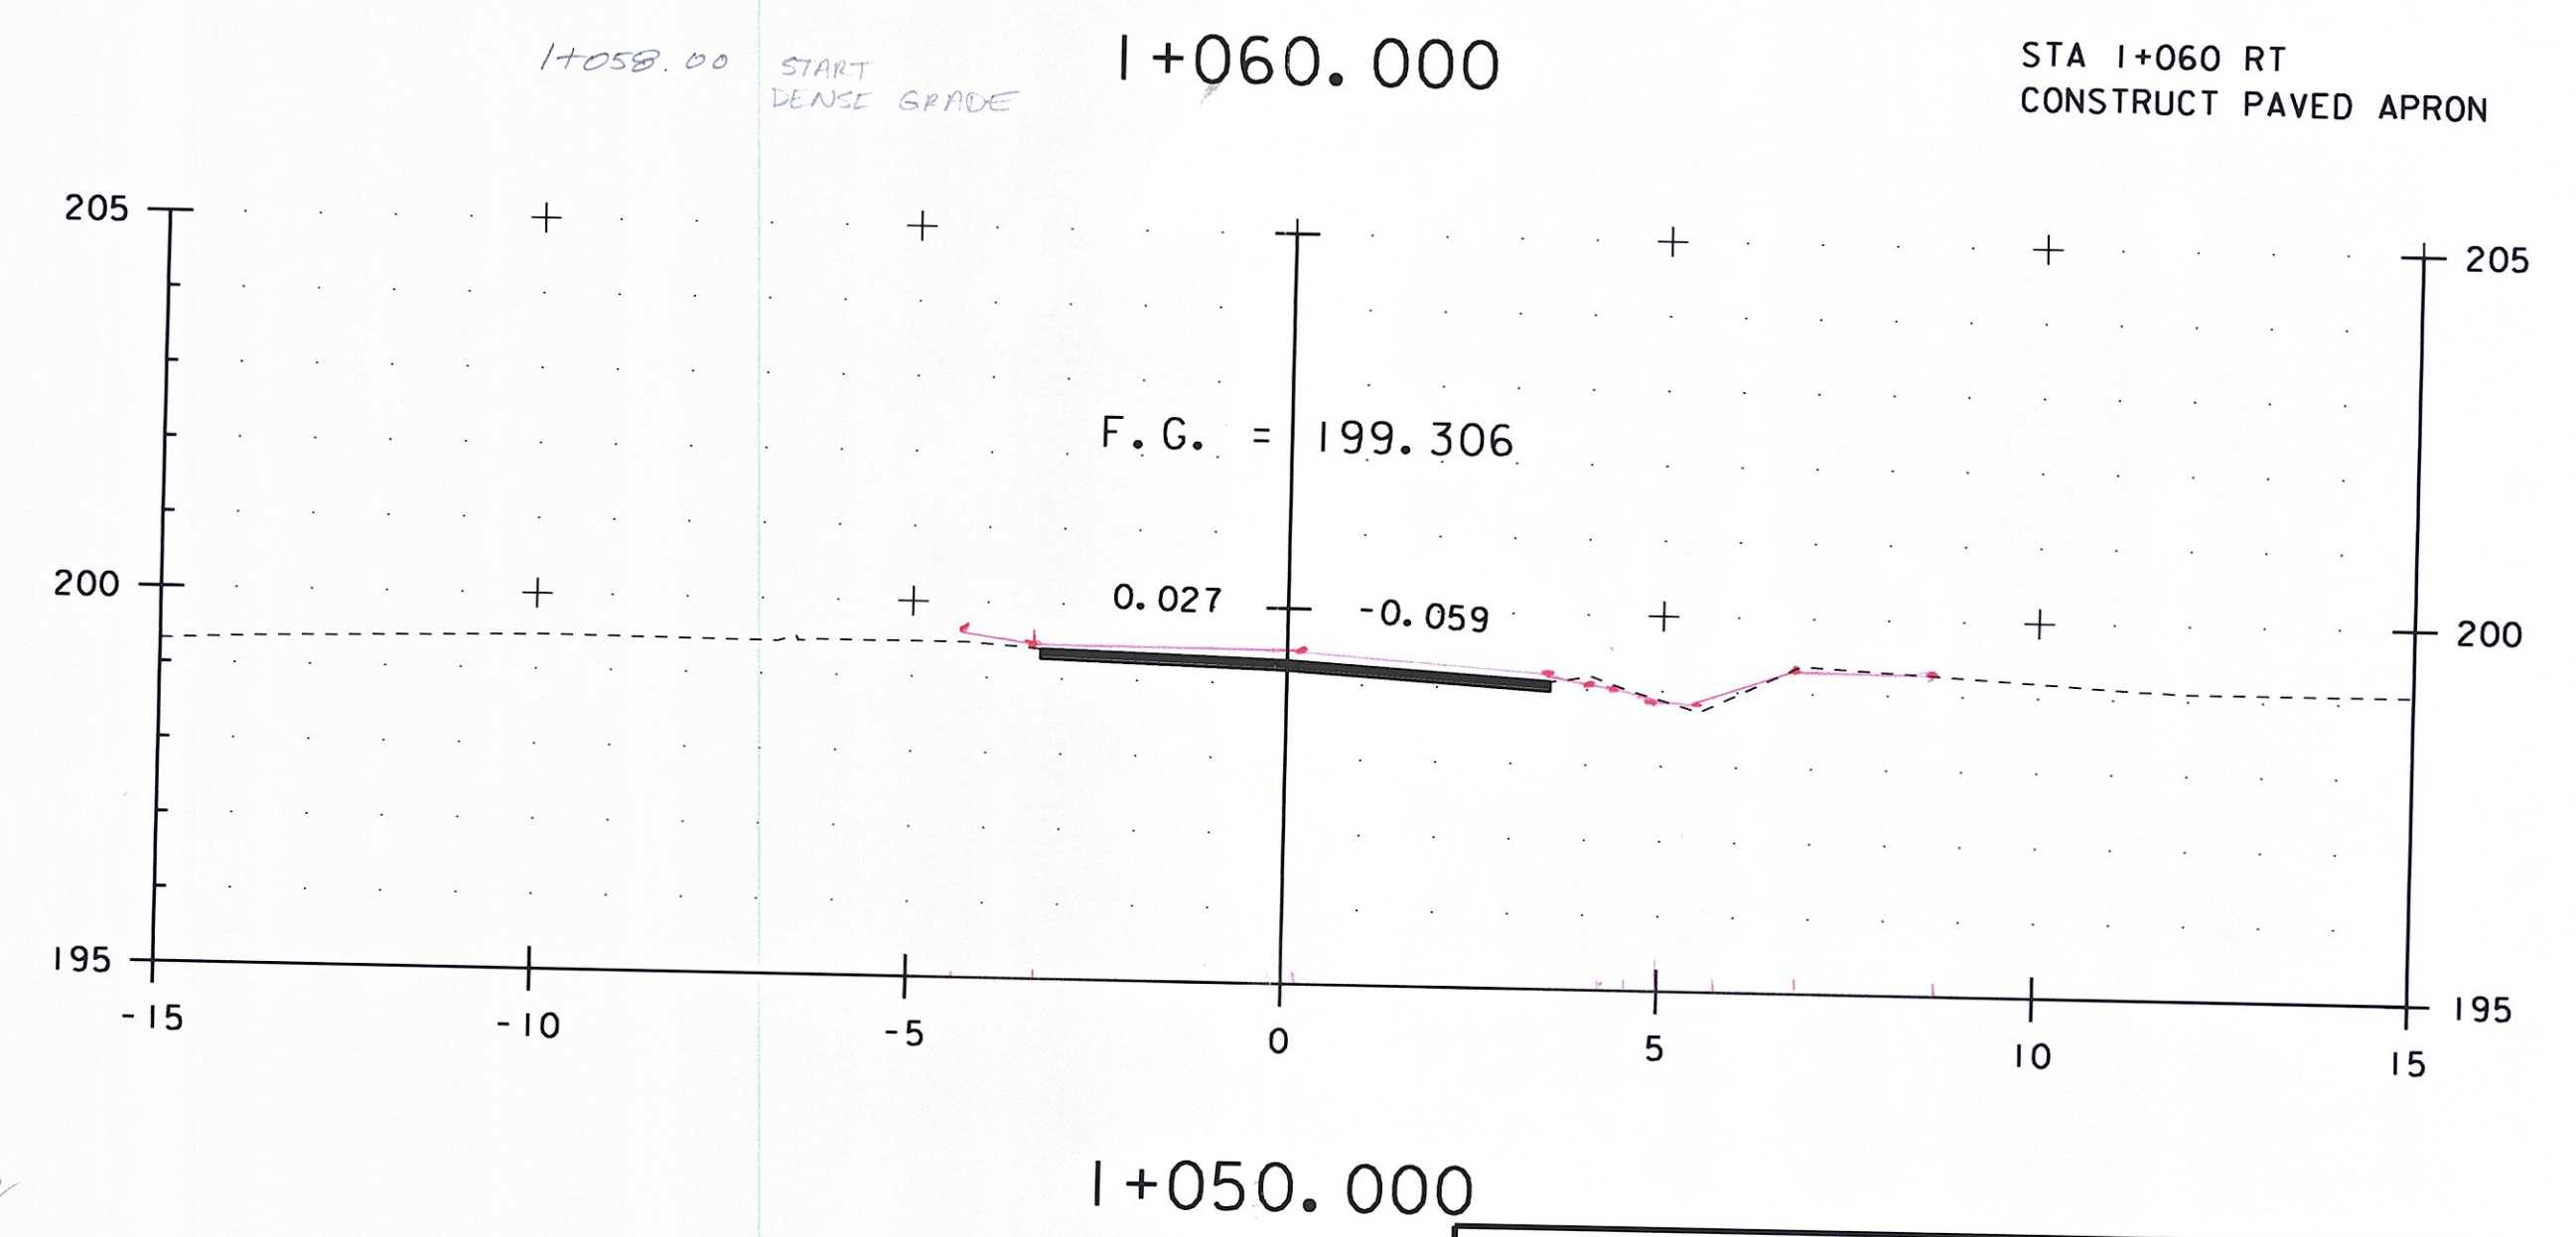
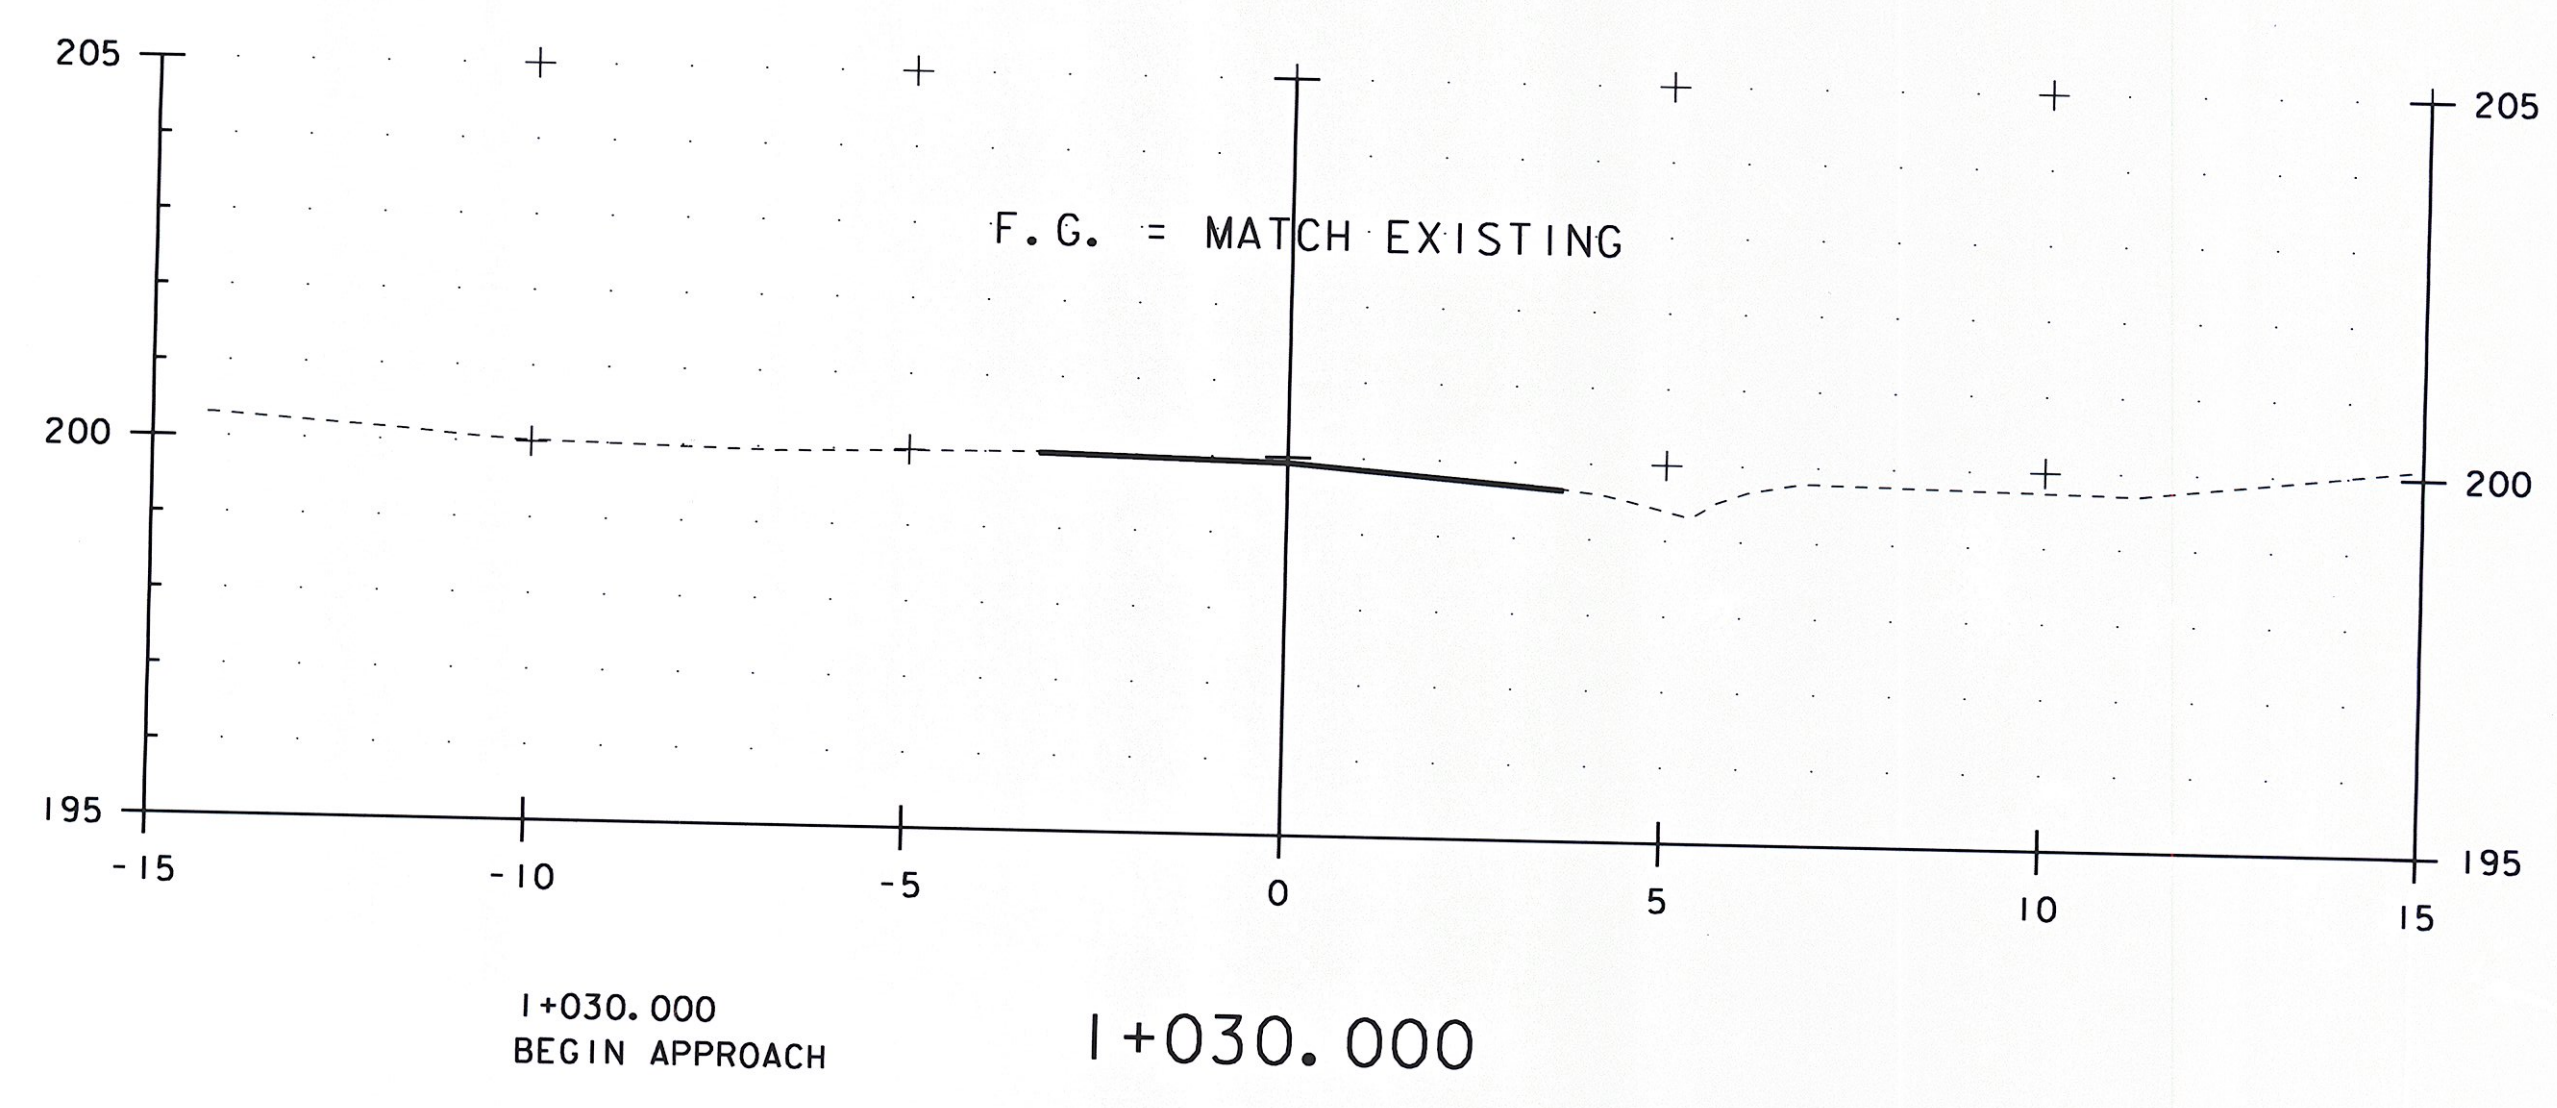


40 TYPE IV  
 40 TYPE IV  
 75 TYPE II

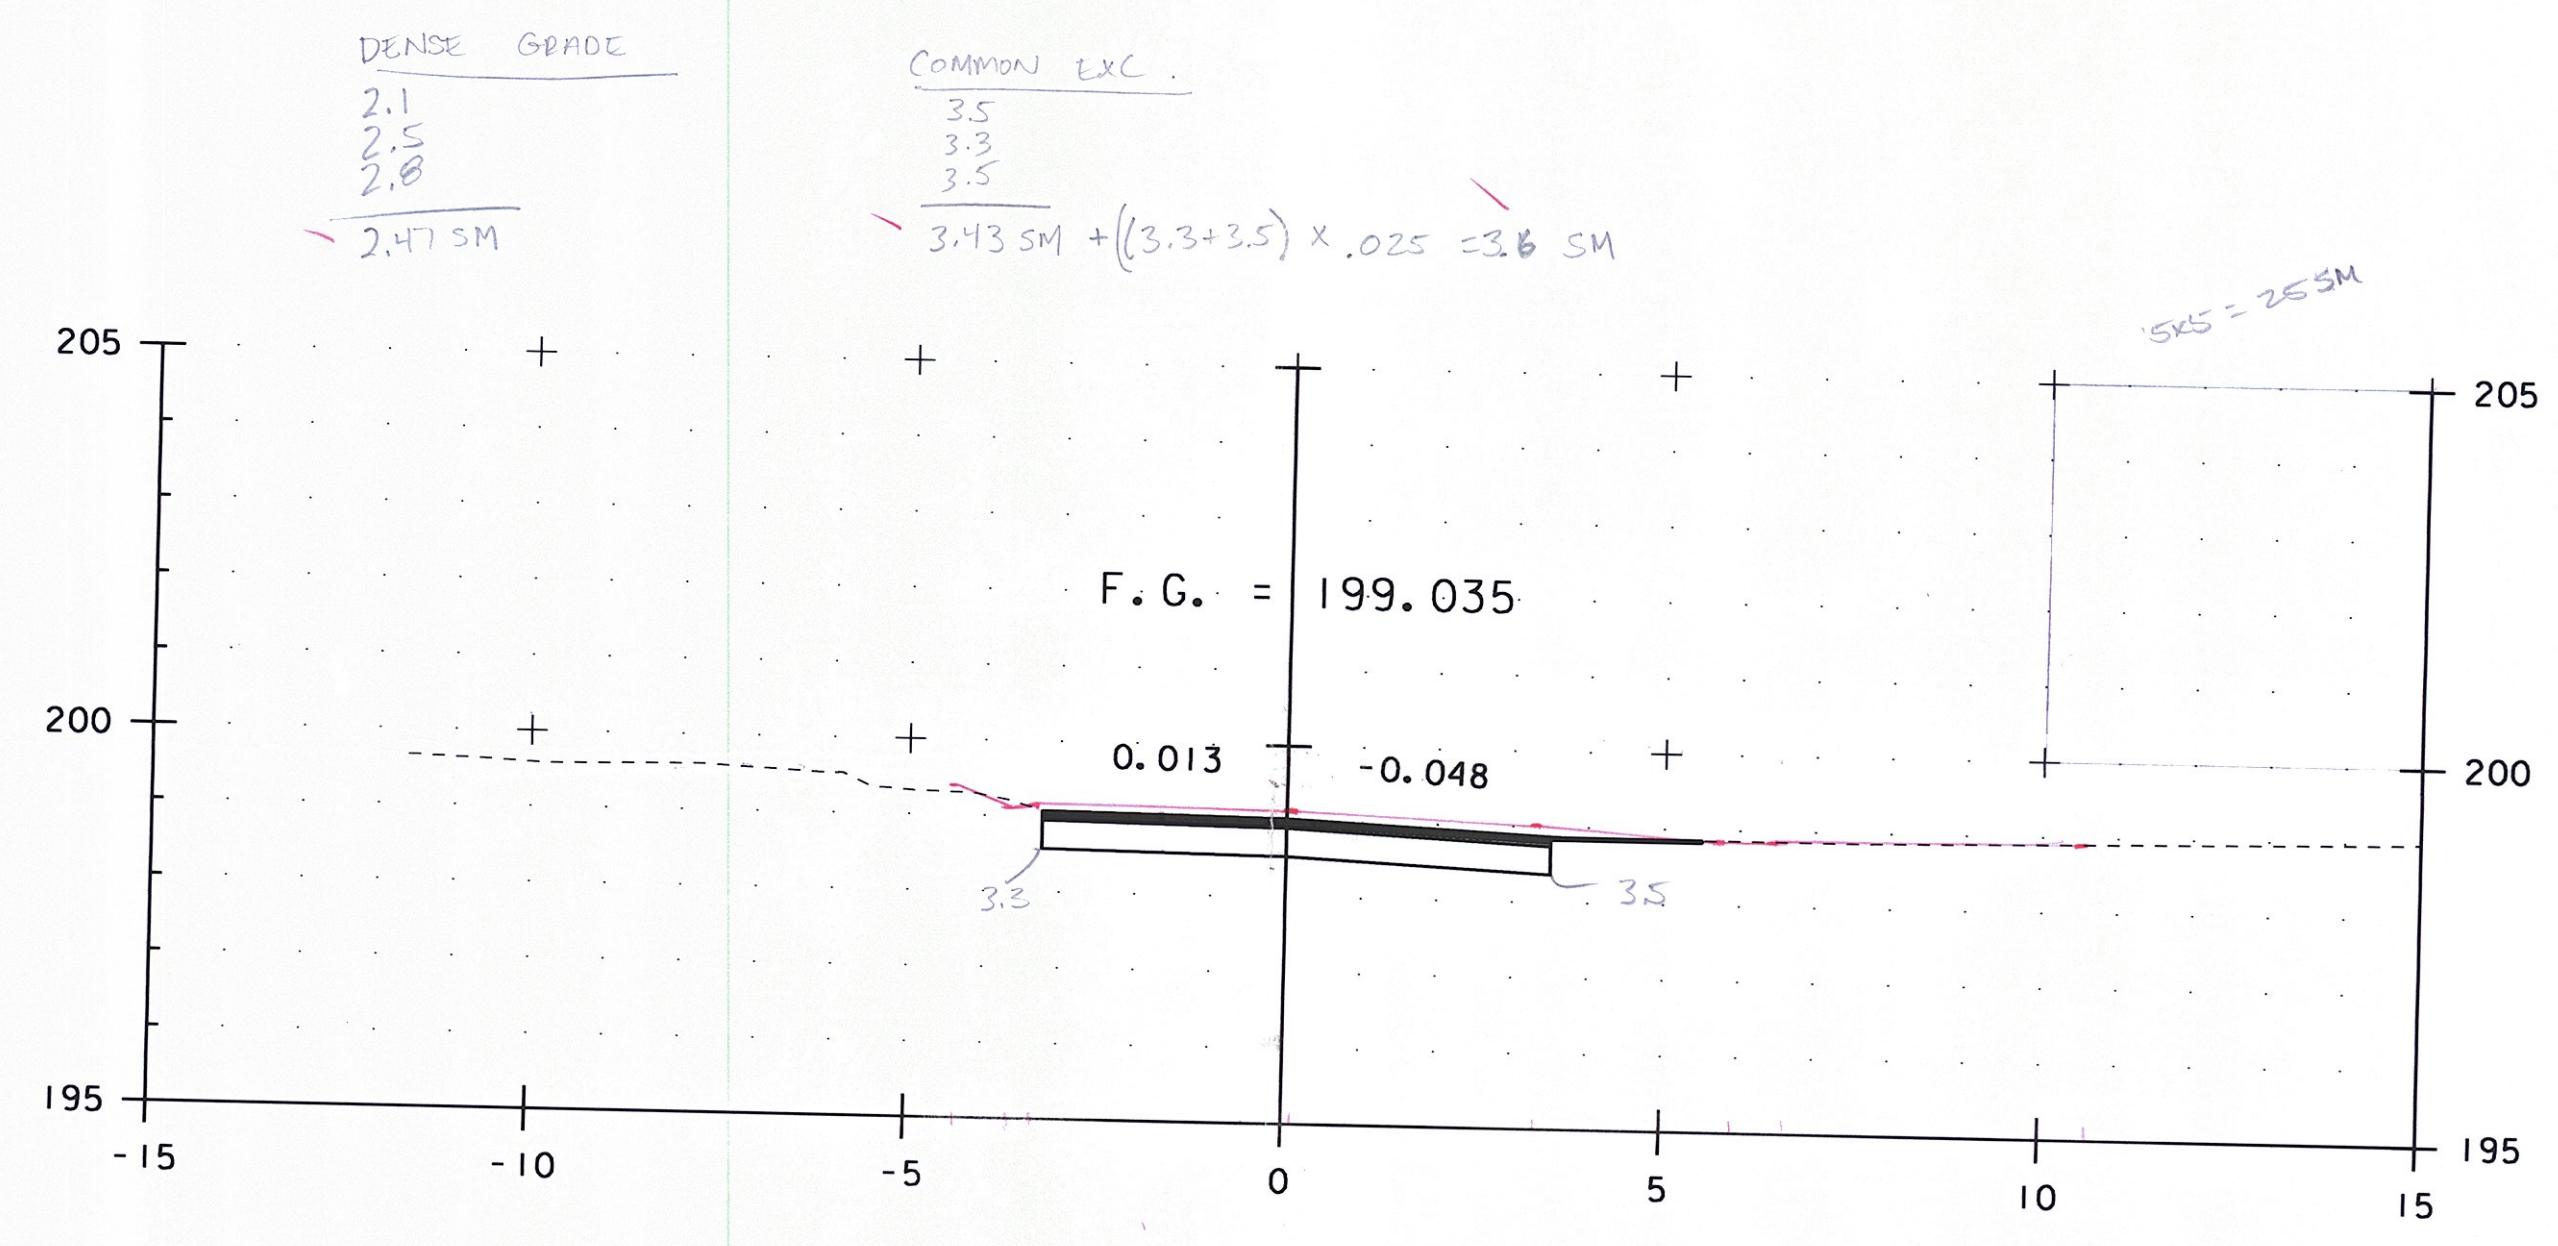

\* ADD 25 mm x width of cut to common excavation to account for added pavement depth.  
 Dense grade and sand stay the same

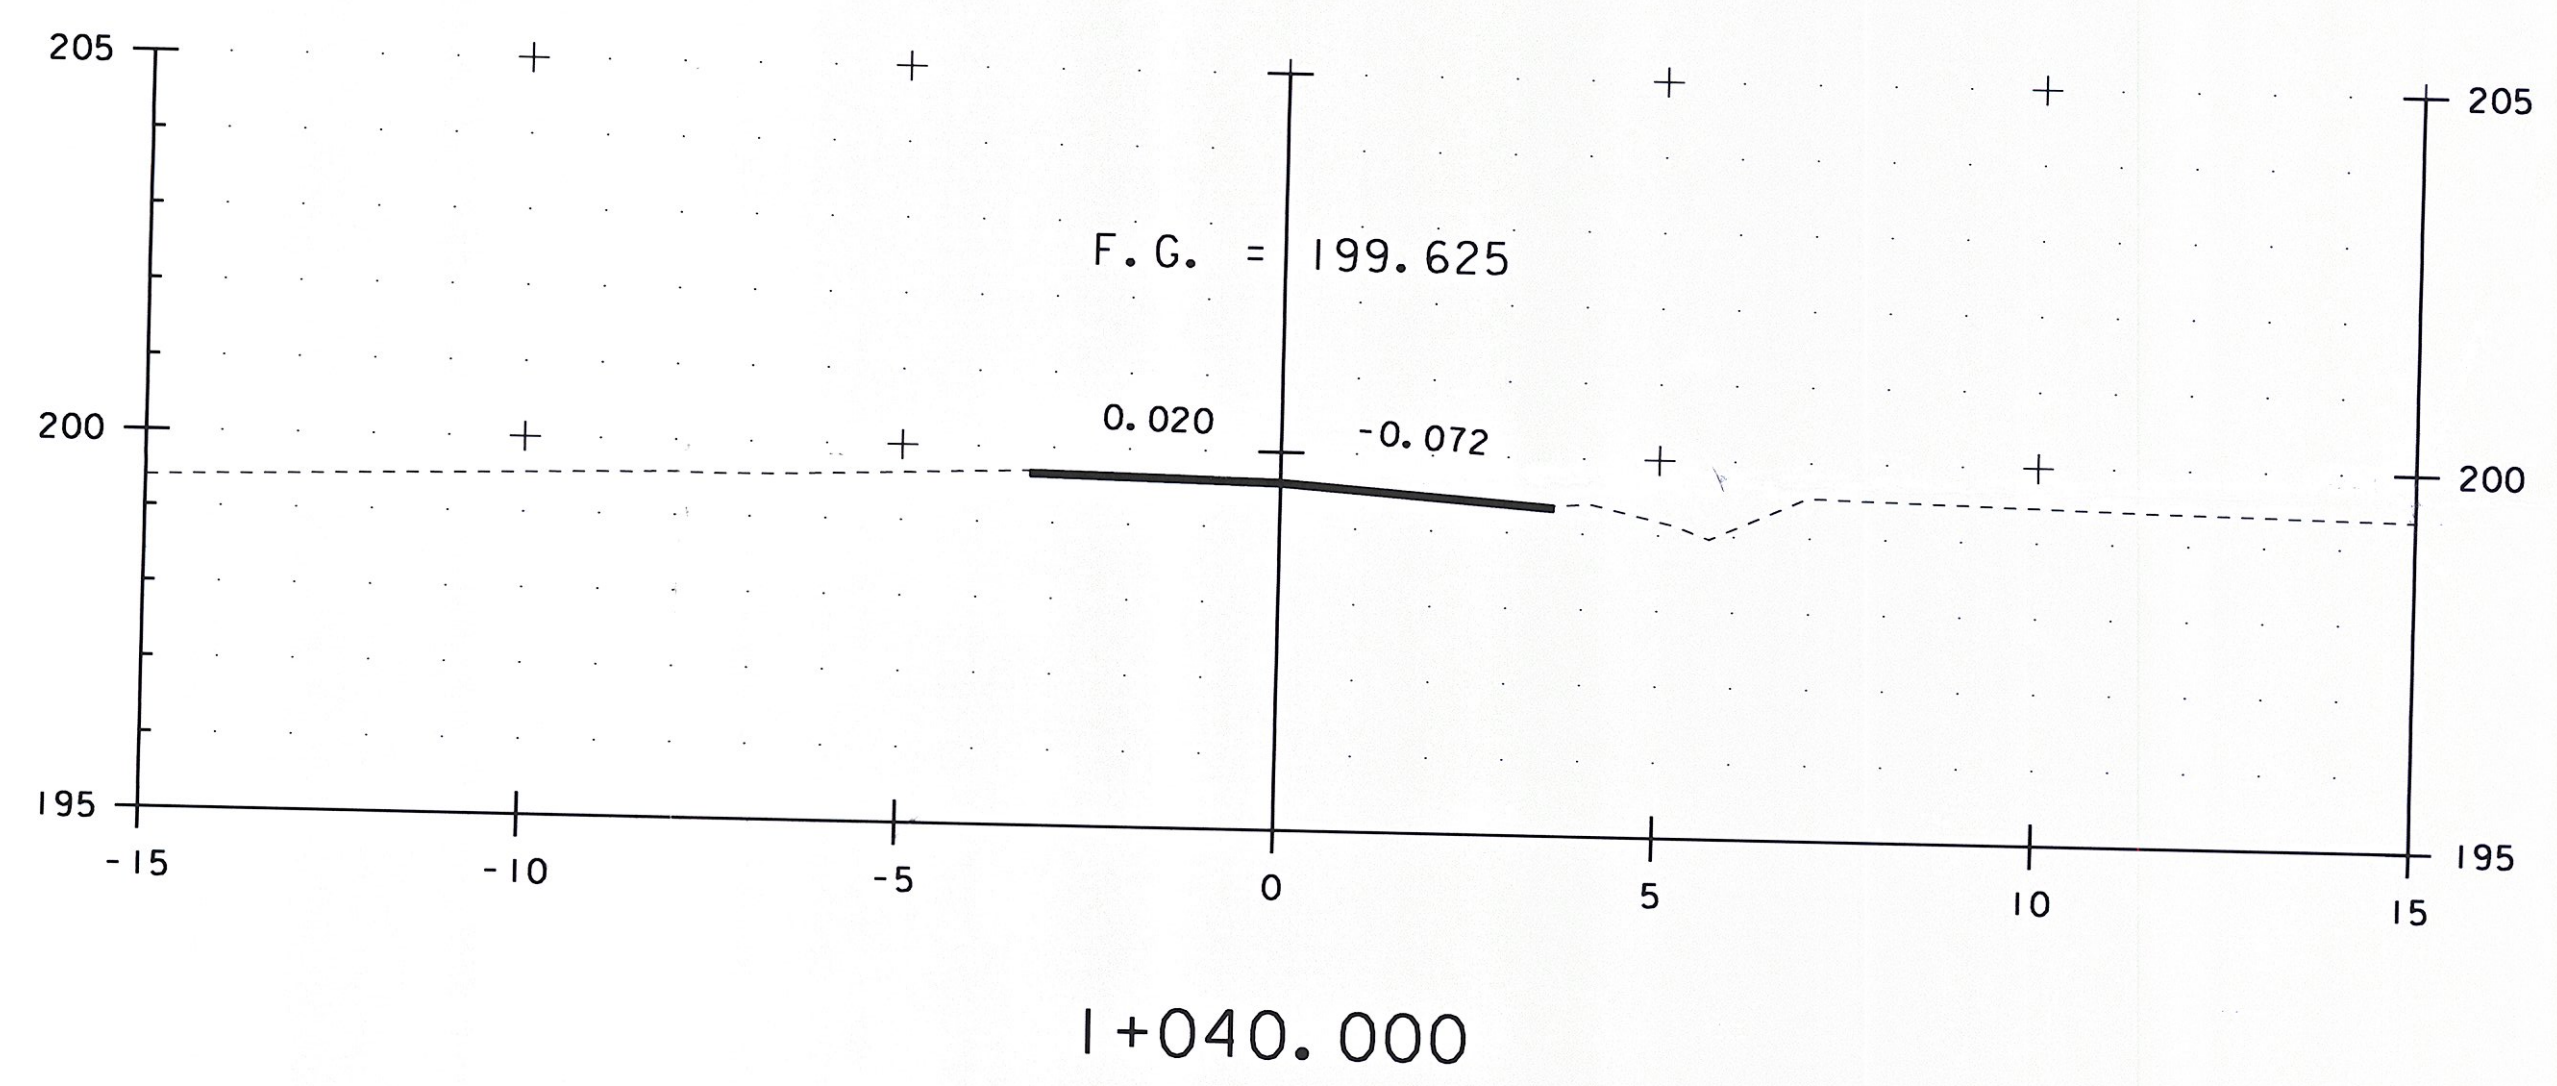

CHK  
 3/18/13

MTL  
 12/6/12

STA. 1+030 TO STA. 1+060

PROJECT NAME:	NEWFANE	PLOT DATE:	22-OCT-2012
PROJECT NUMBER:	BRF 0106 (3)S	DRAWN BY:	C. MOONEY
FILE NAME:	s95j280xs.dgn	CHECKED BY:	G. SWEENEY
PROJECT MANAGER:	C. CARLSON	ROADWAY CROSS SECTIONS I	SHEET 47 OF 70
DESIGNED BY:	T. LACKEY		