



I+130.000

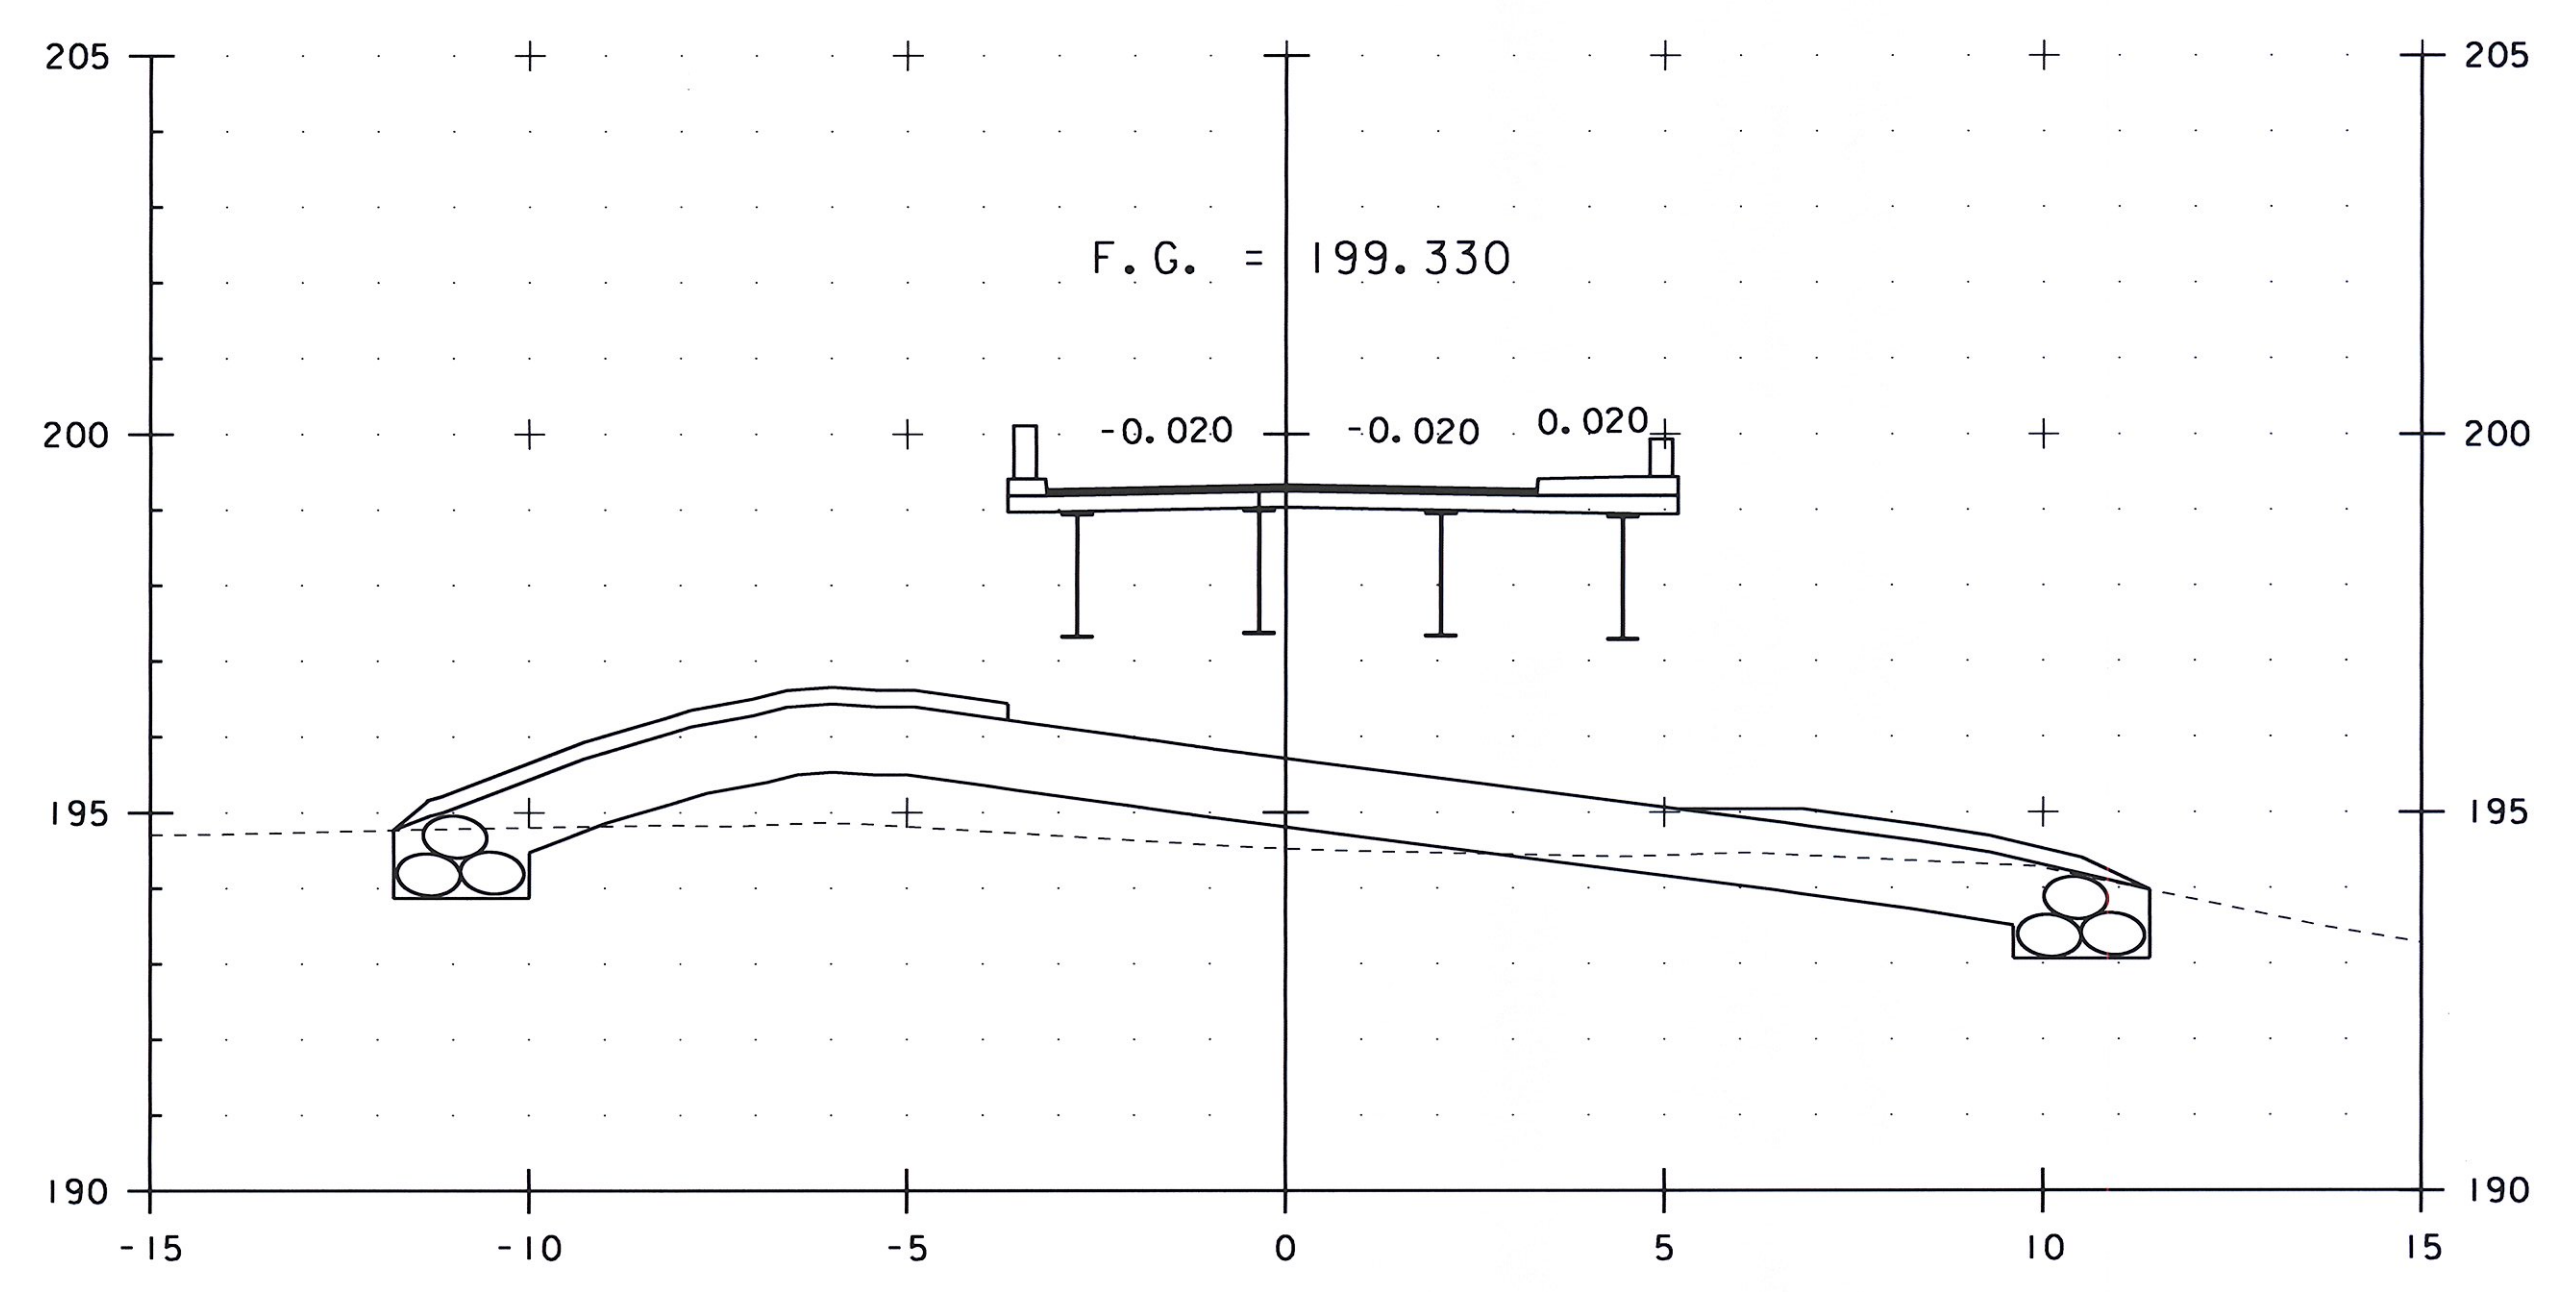

I+120.000

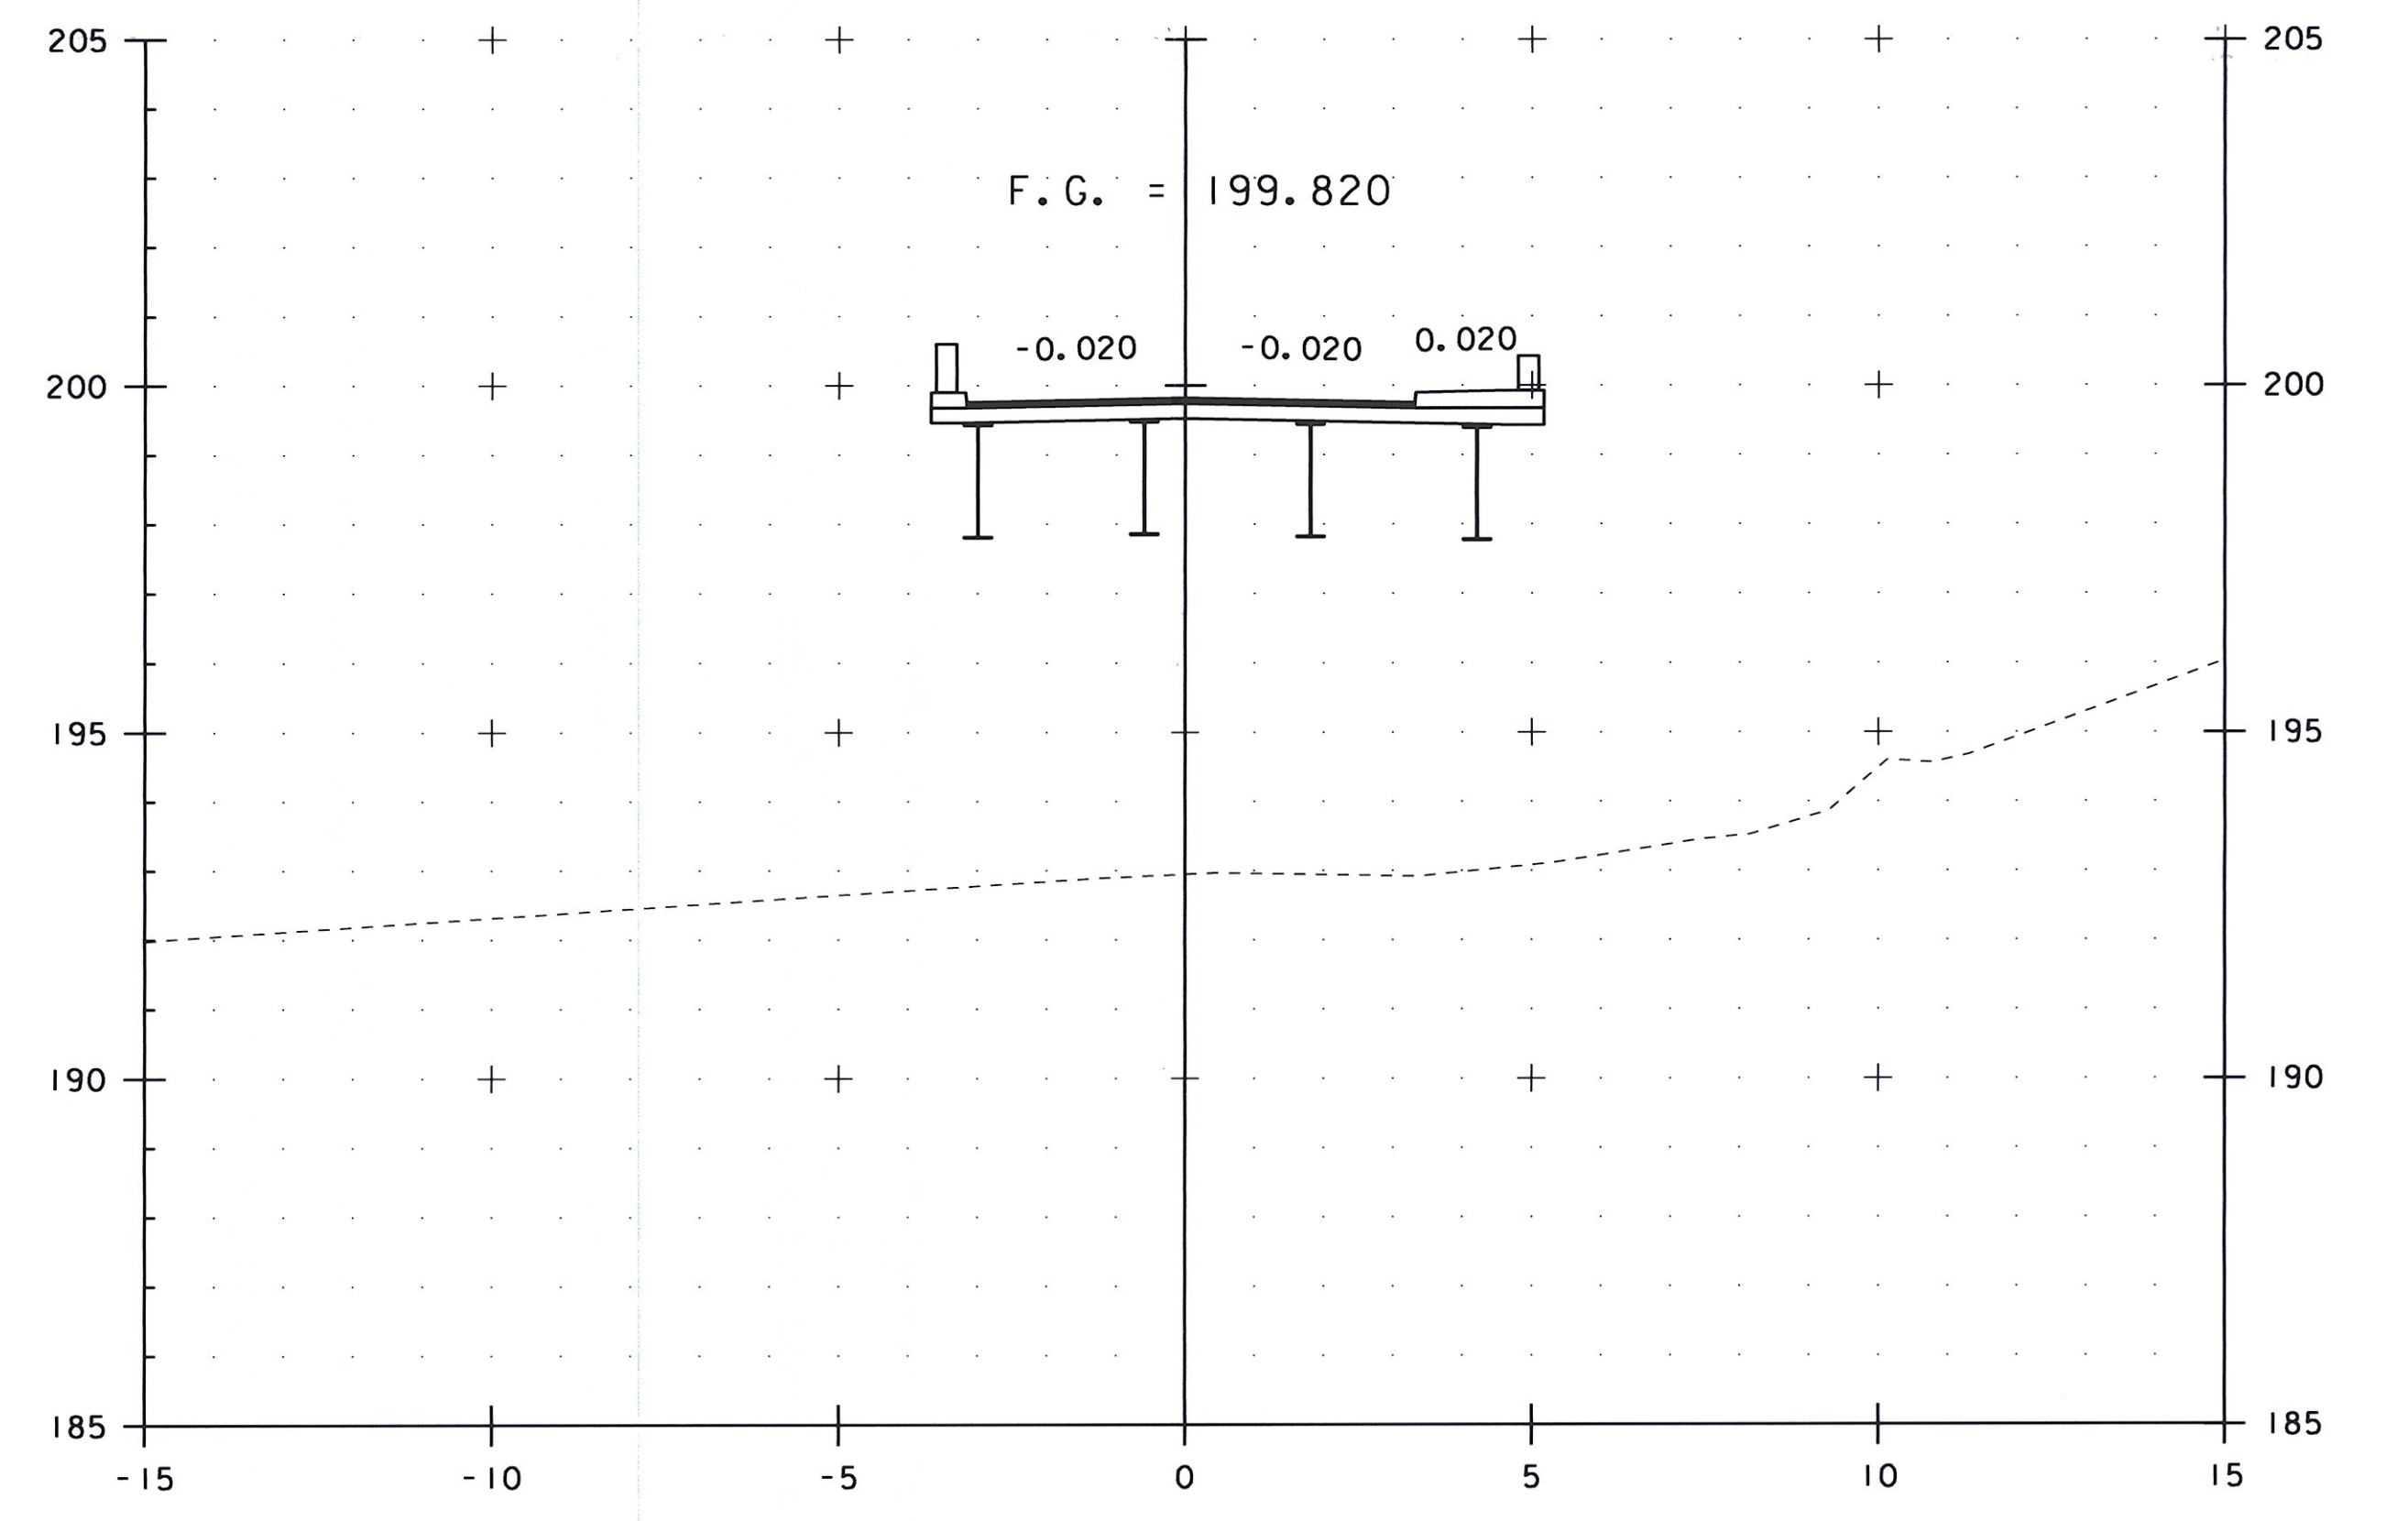

I+140.000

STA. I+120 TO STA. I+140

PROJECT NAME:	NEWFANE	PLOT DATE:	22-OCT-2012
PROJECT NUMBER:	BRF 0106 (3)S	DRAWN BY:	C. MOONEY
FILE NAME:	s95j280xs.dgn	DESIGNED BY:	T. LACKEY
PROJECT MANAGER:	C. CARLSON	ROADWAY CROSS SECTIONS	4
CHECKED BY:	G. SWEENEY	SHEET	50 OF 70