



MTZ
12/6/12

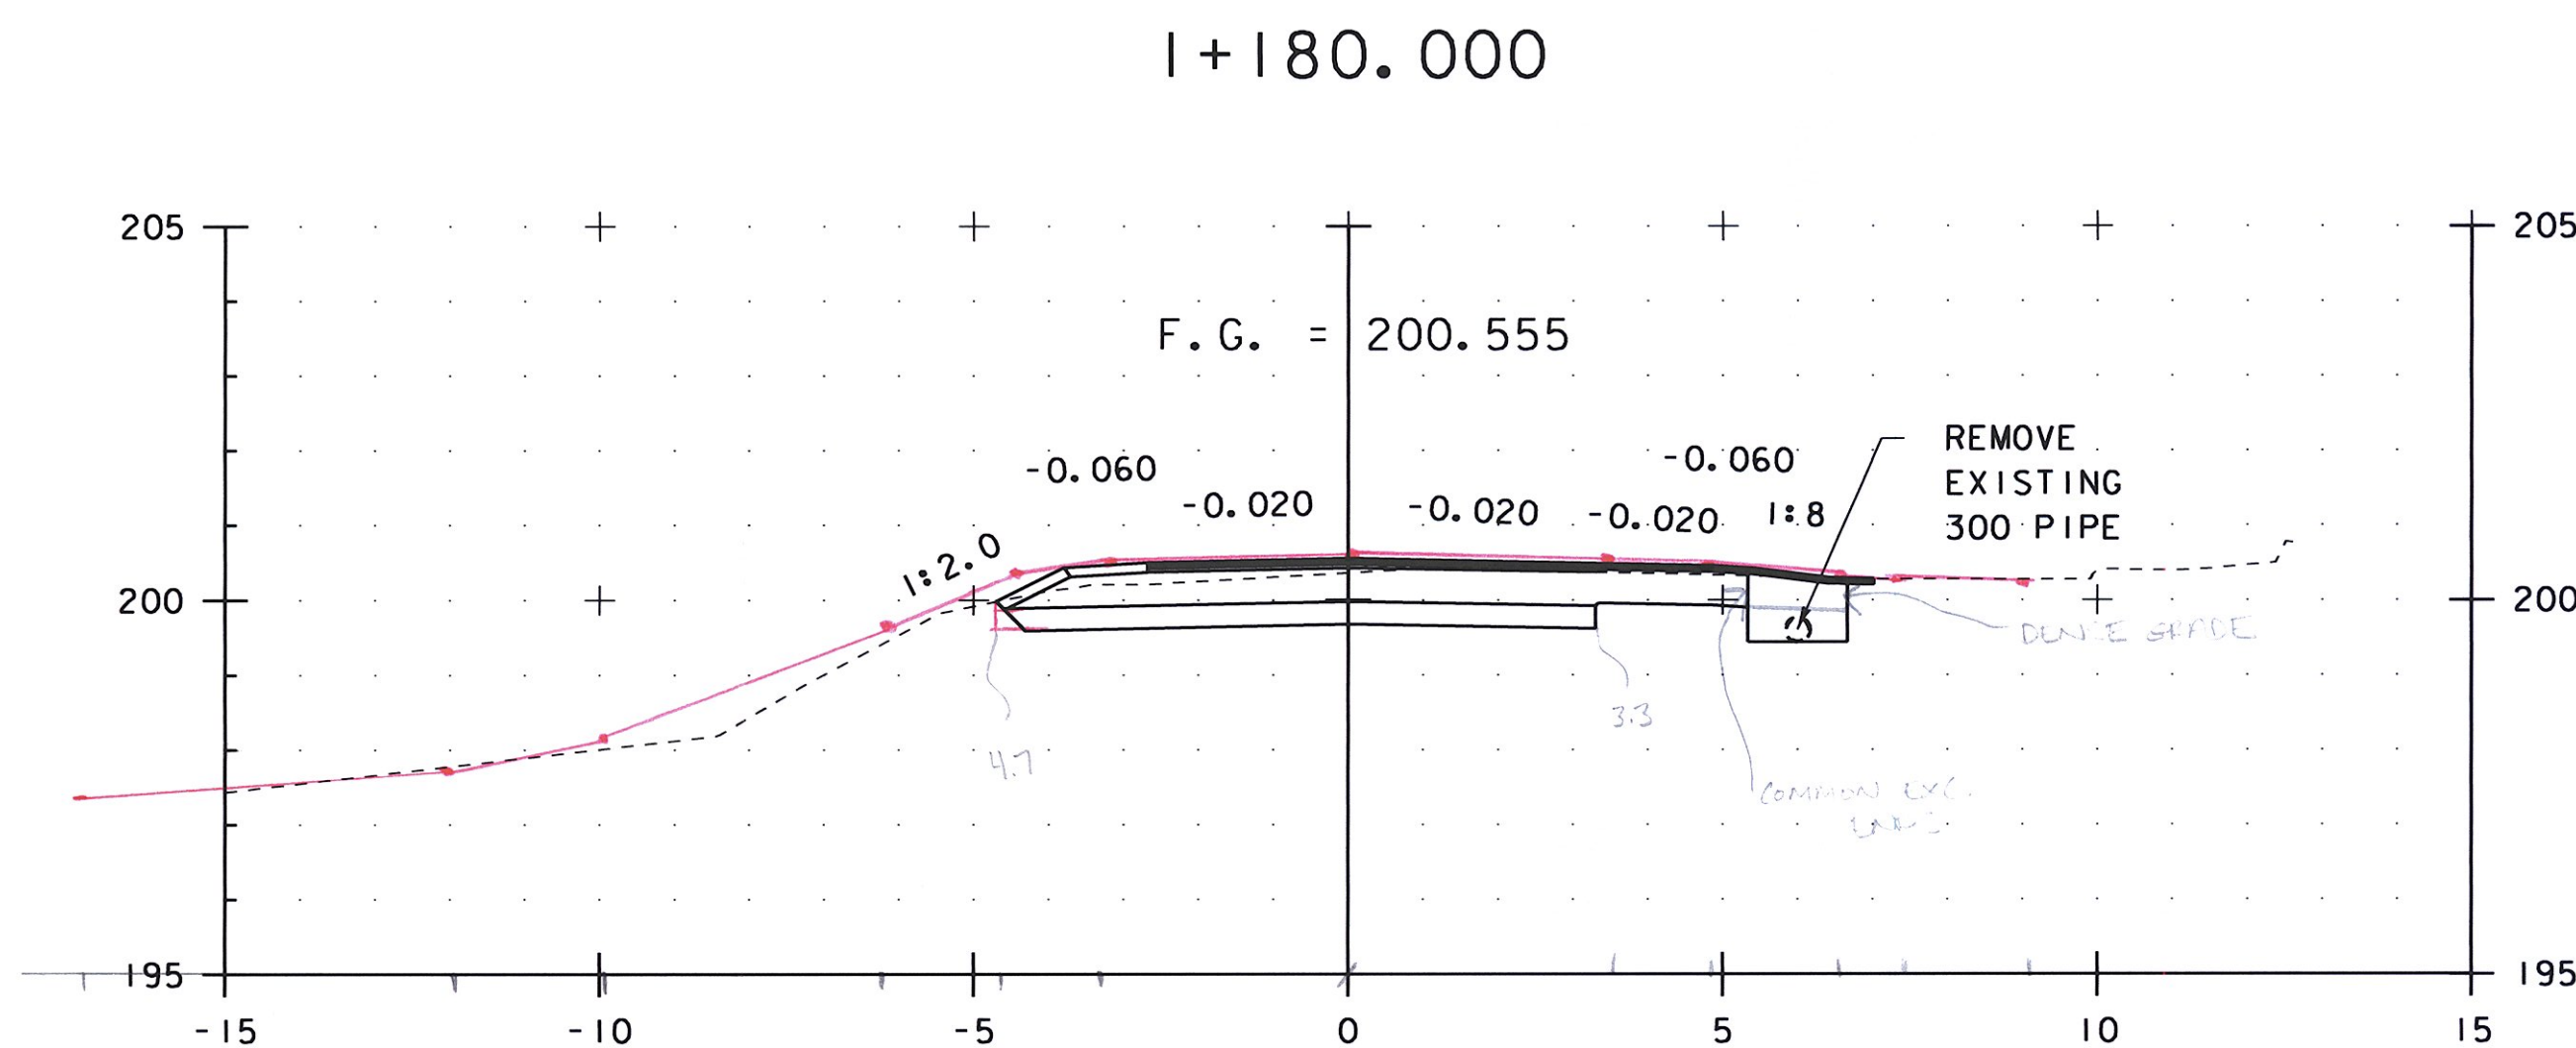

CG
3/17/13

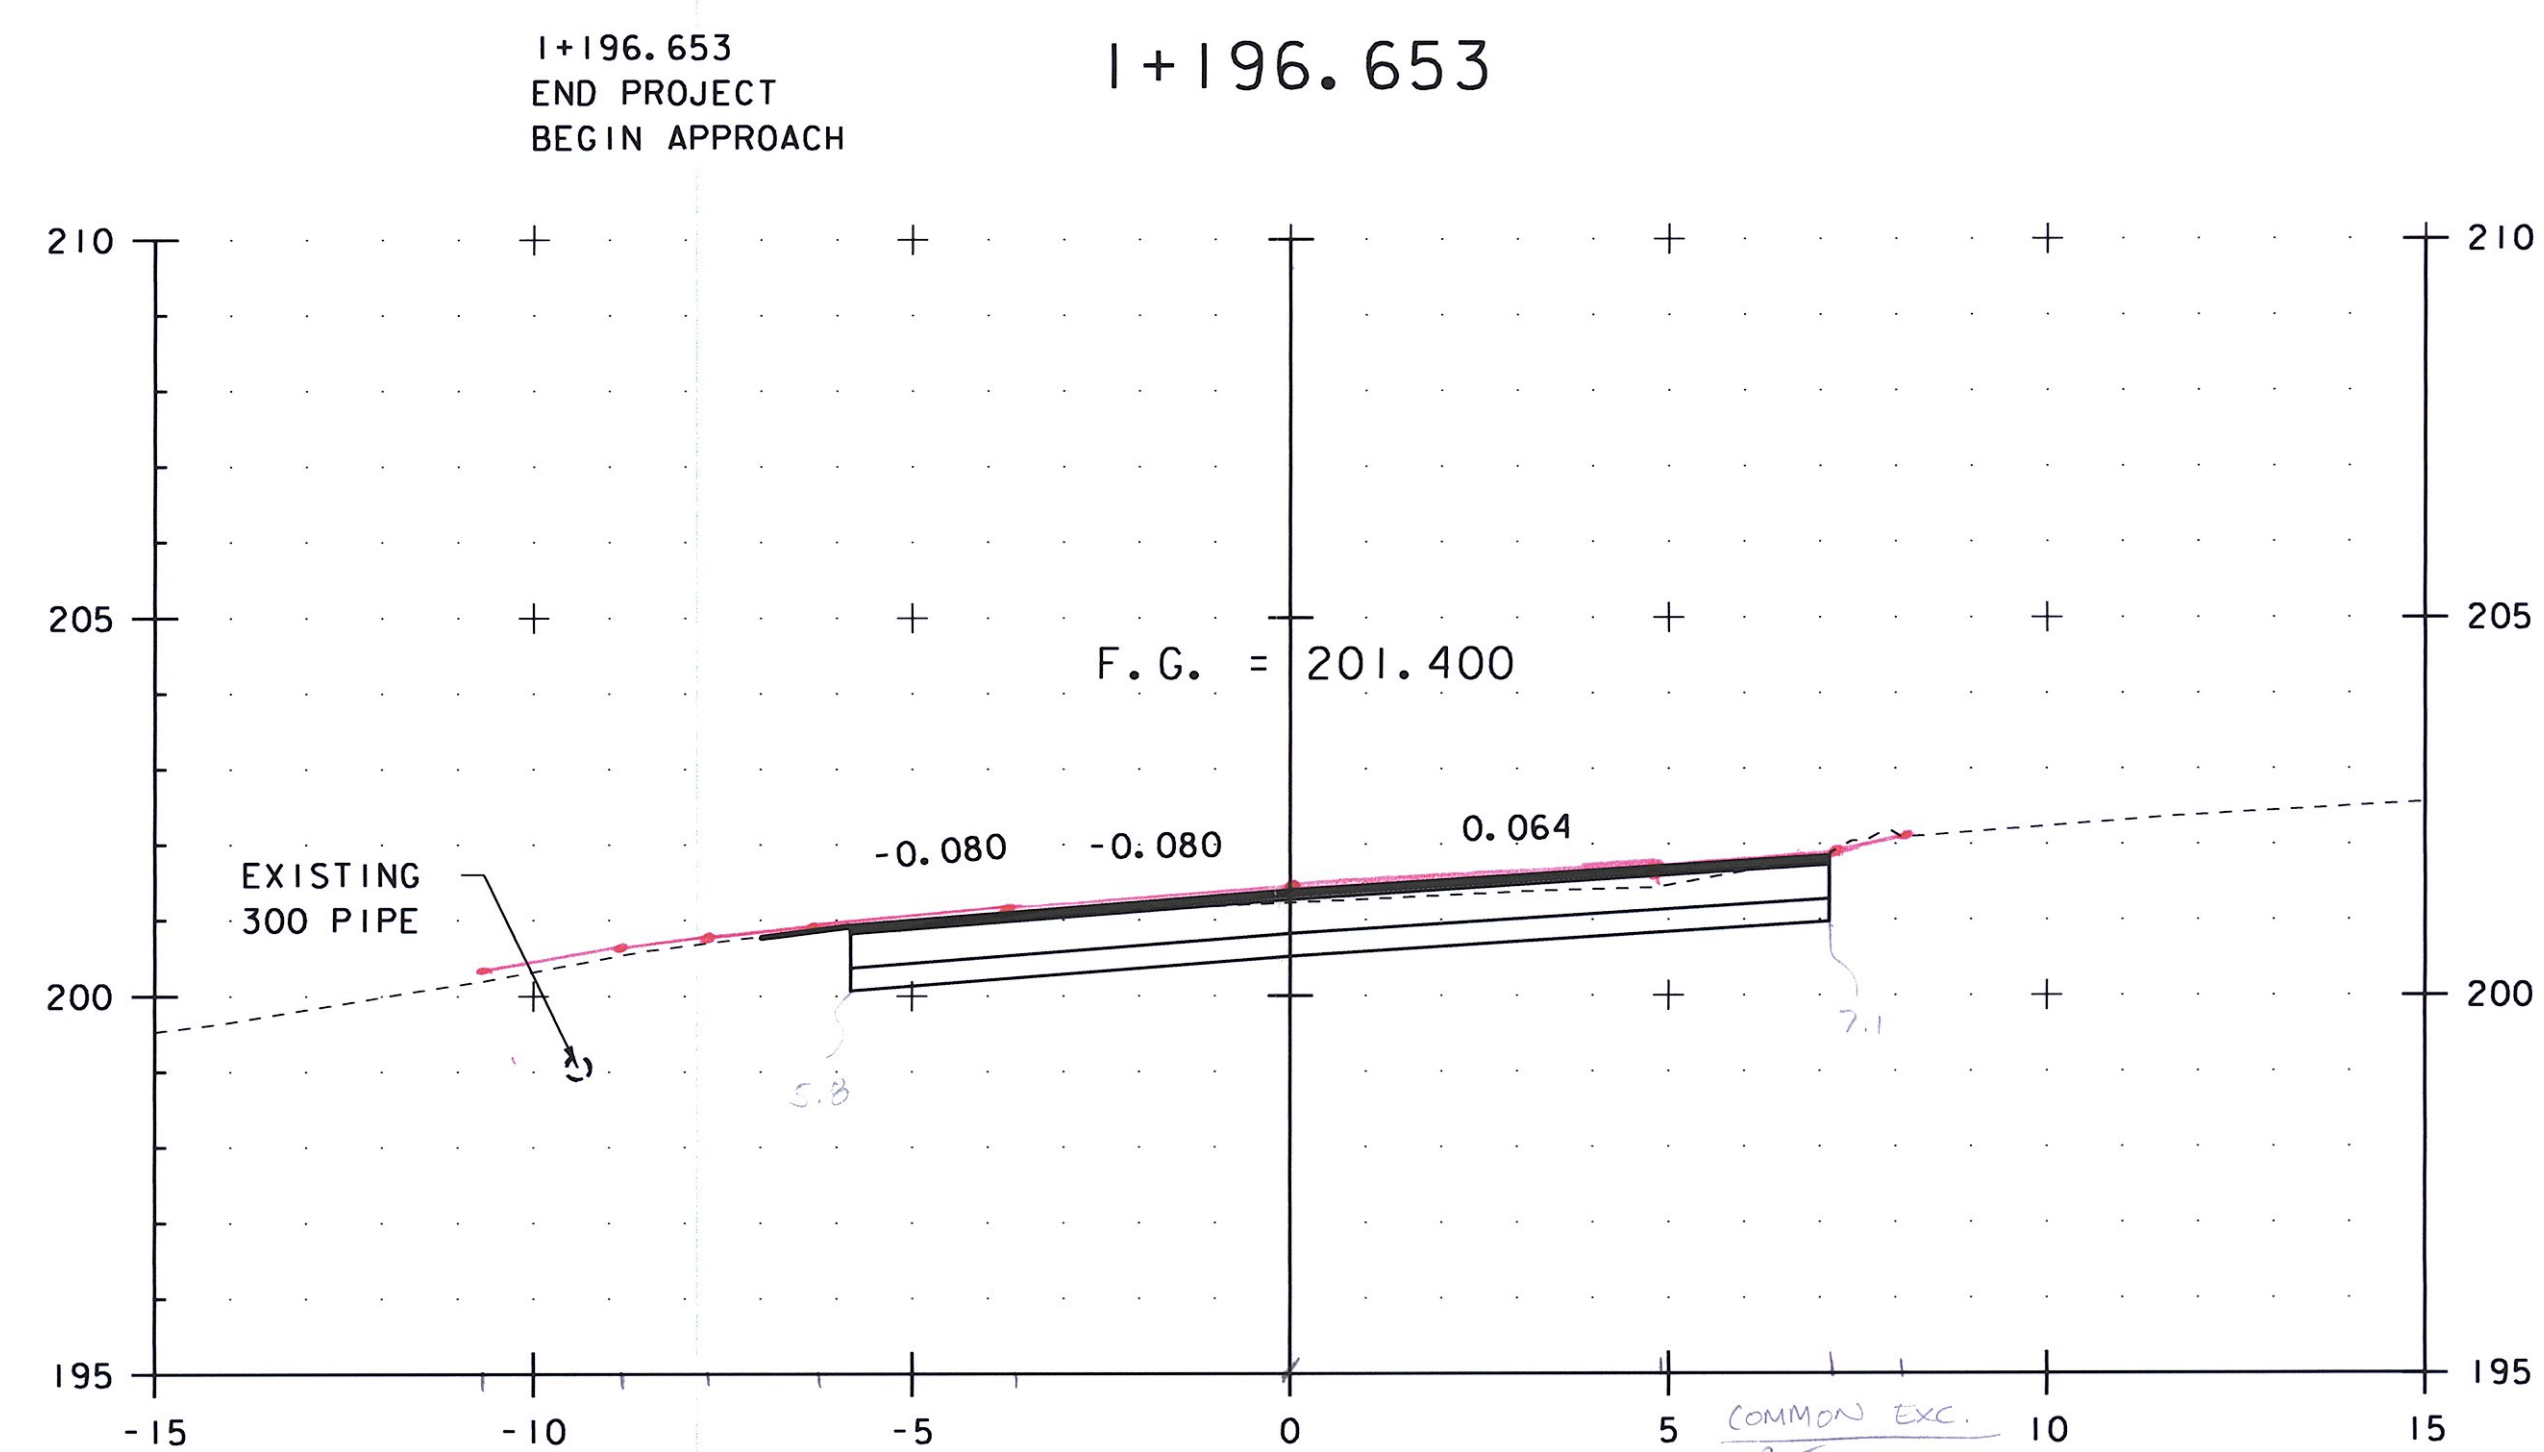

STA. I+170 TO STA. I+197

PROJECT NAME:	NEWFANE	PLOT DATE:	22-OCT-2012
PROJECT NUMBER:	BRF 0106 (3)S	DRAWN BY:	C. MOONEY
FILE NAME:	s95J280xs.dgn	CHECKED BY:	G. SWEENEY
PROJECT MANAGER:	C. CARLSON	ROADWAY CROSS SECTIONS	6
DESIGNED BY:	T. LACKEY	SHEET	52 OF 70