


I+211.731 22.043 LT
 END VERTICAL GRANITE CURB
 END APPROACH

SAND
 .8
 .9
 .8
 .47 SM

DENSE GRADE
 .8
 .9
 .8
 .83 SM


COMMON EXC.
 1.4
 1.5
 1.6
 $1.5 + ((10.1 - 8.0) \times .025) = 1.53 \text{ SM}$

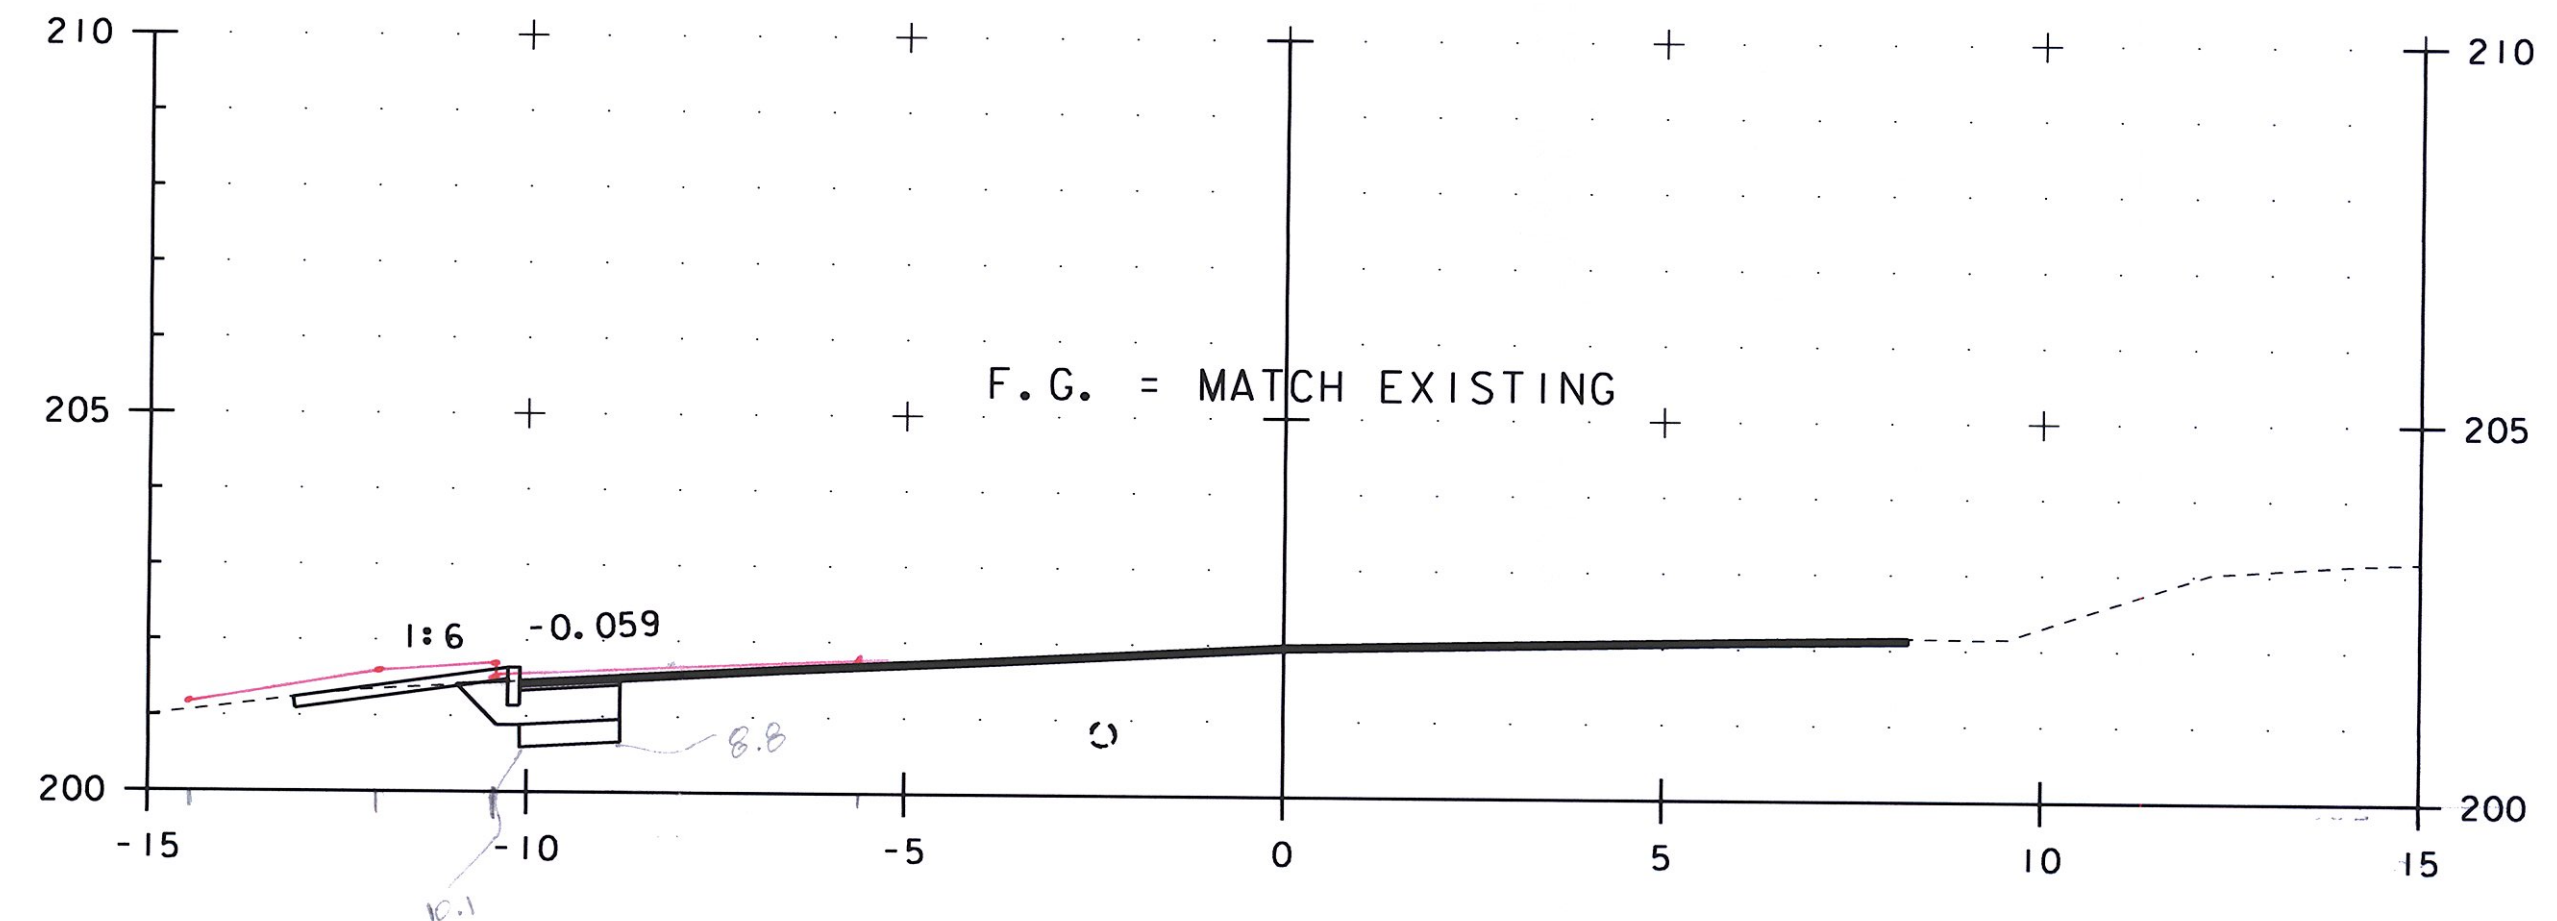

I+202.081

MTL
 12/8/12

OFF
 3/19/13

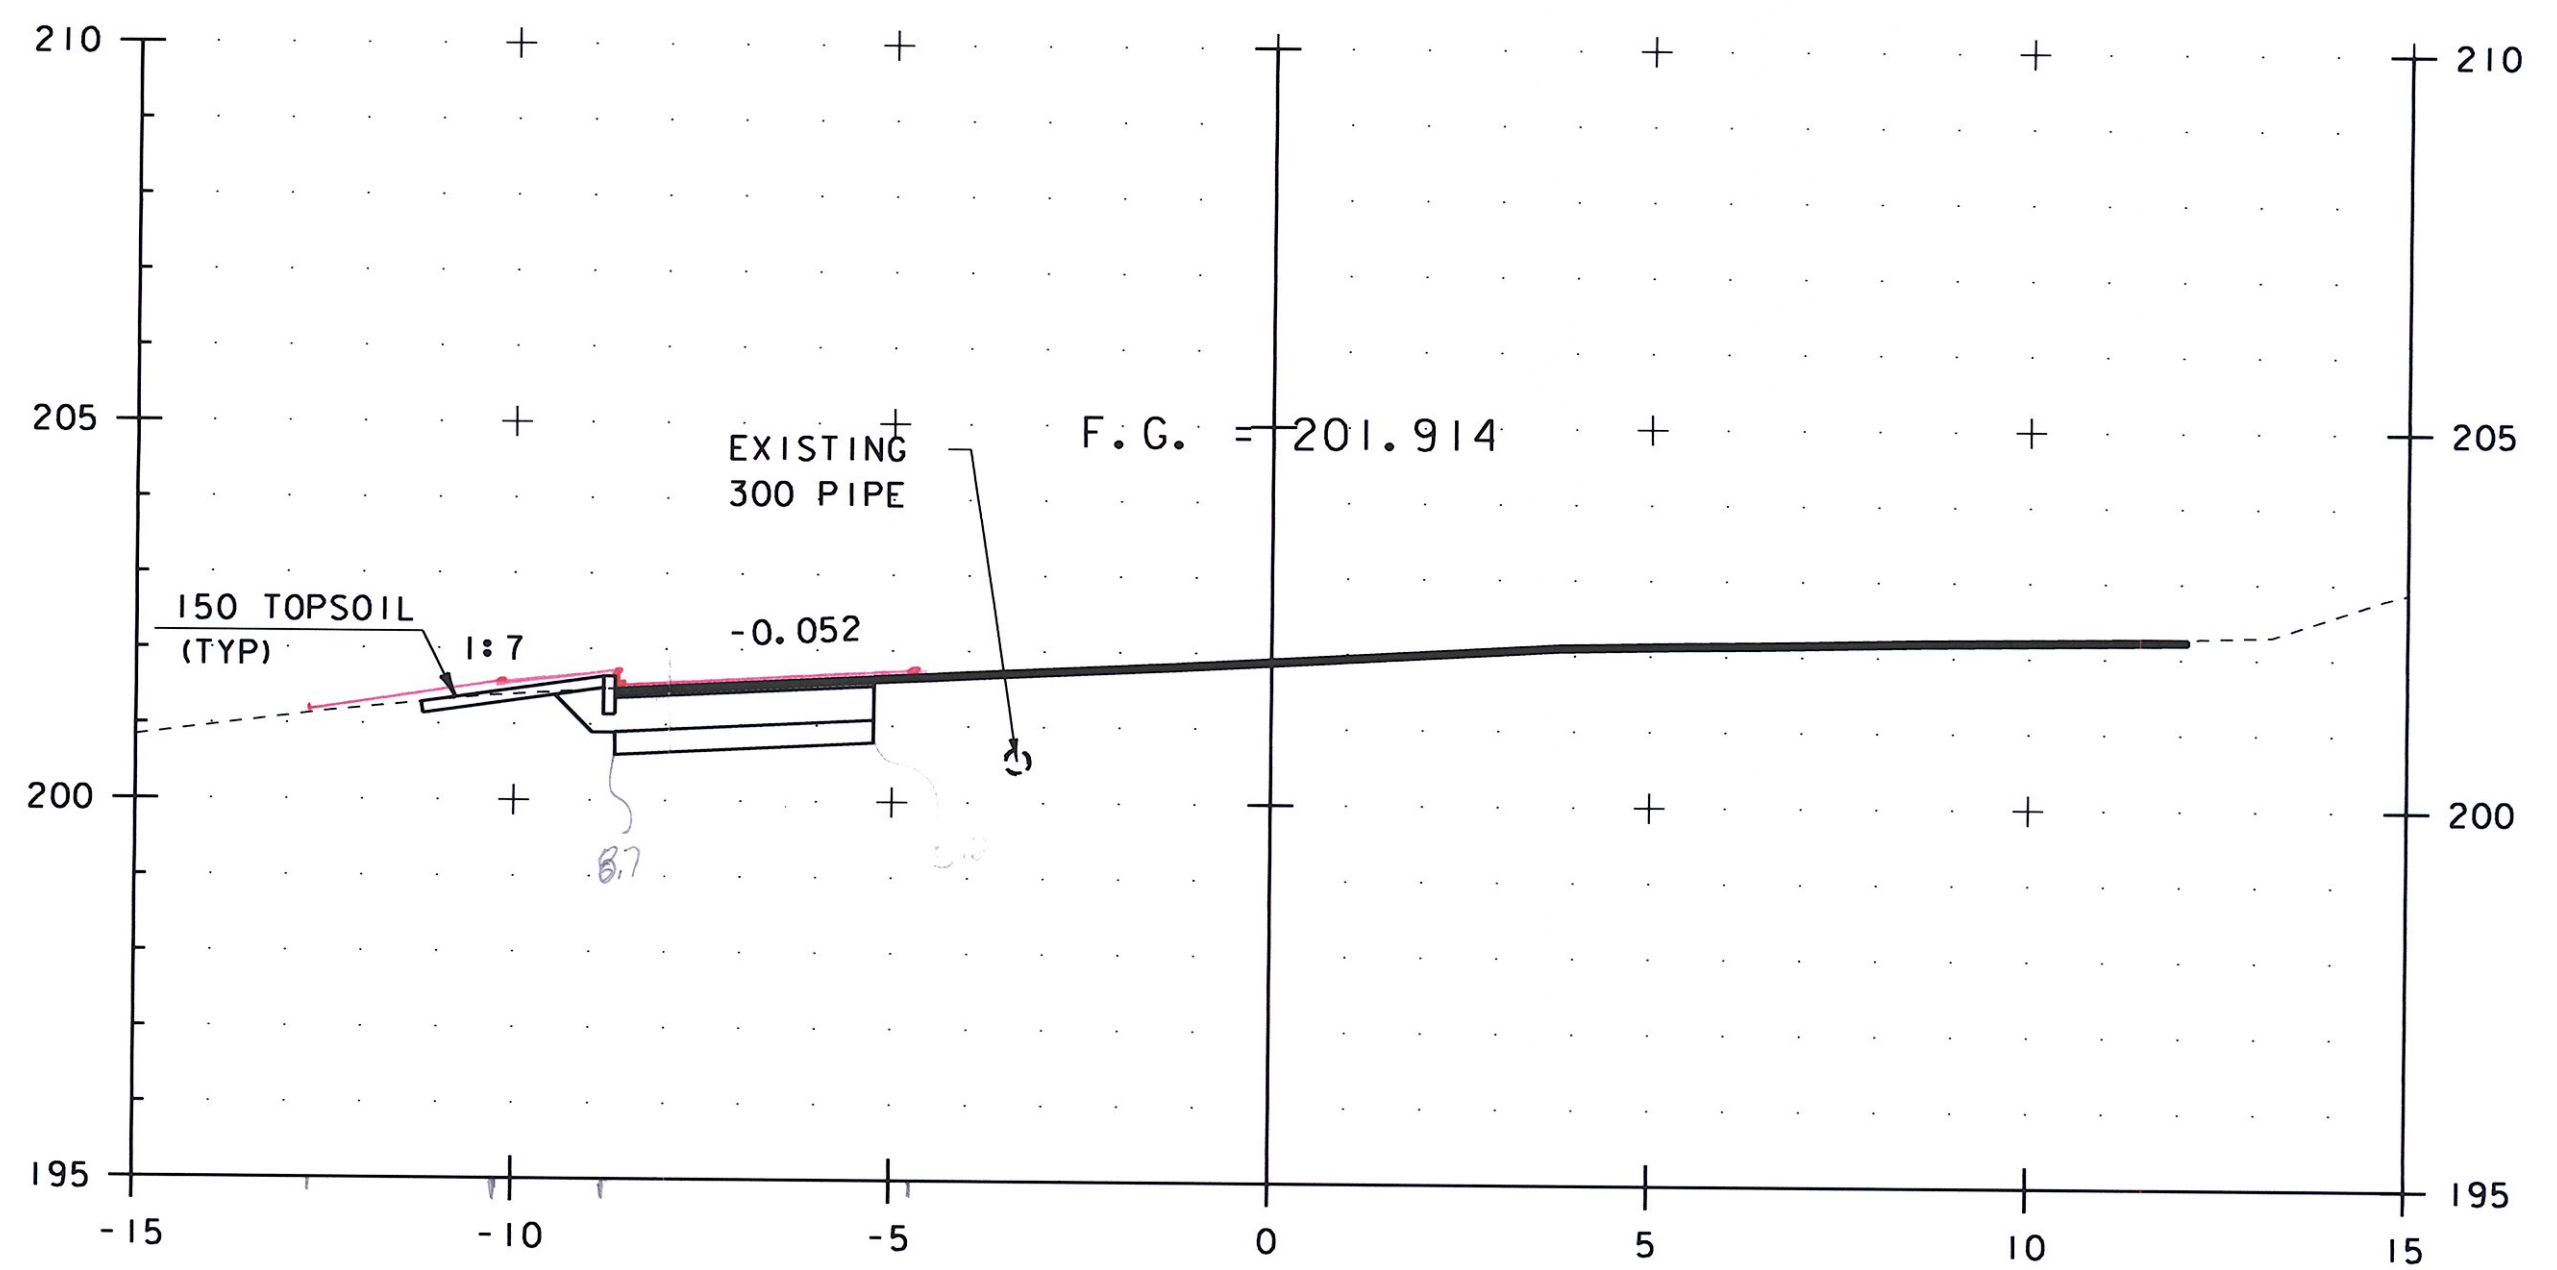

I+200.000

SAND
 .9
 1.1
 .9
 .97 SM

DENSE GRADE
 1.7
 1.8
 1.8
 1.77 SM

COMMON EXC.
 3.4
 3.1
 3.2
 $3.23 + ((8.7 - 5.0) \times .025) = 3.30 \text{ SM}$

PROJECT NAME: NEWFANE	PLOT DATE: 22-OCT-2012
PROJECT NUMBER: BR 0106 (3)S	DRAWN BY: C. MOONEY
FILE NAME: s95j280xs.dgn	CHECKED BY: G. SWEENEY
PROJECT MANAGER: C. CARLSON	SHEET 53 OF 70
DESIGNED BY: T. LACKEY	ROADWAY CROSS SECTIONS 7