


2+033 LT
BEGIN STONE FILL, TYPE I

2+032 LT
BEGIN UNCLASSIFIED CHANNEL EXCAVATION
BEGIN STONE FILL, TYPE III
BEGIN GEOTEXTILE UNDER STONE FILL
BEGIN GRUBBING MATERIAL

2+035.00

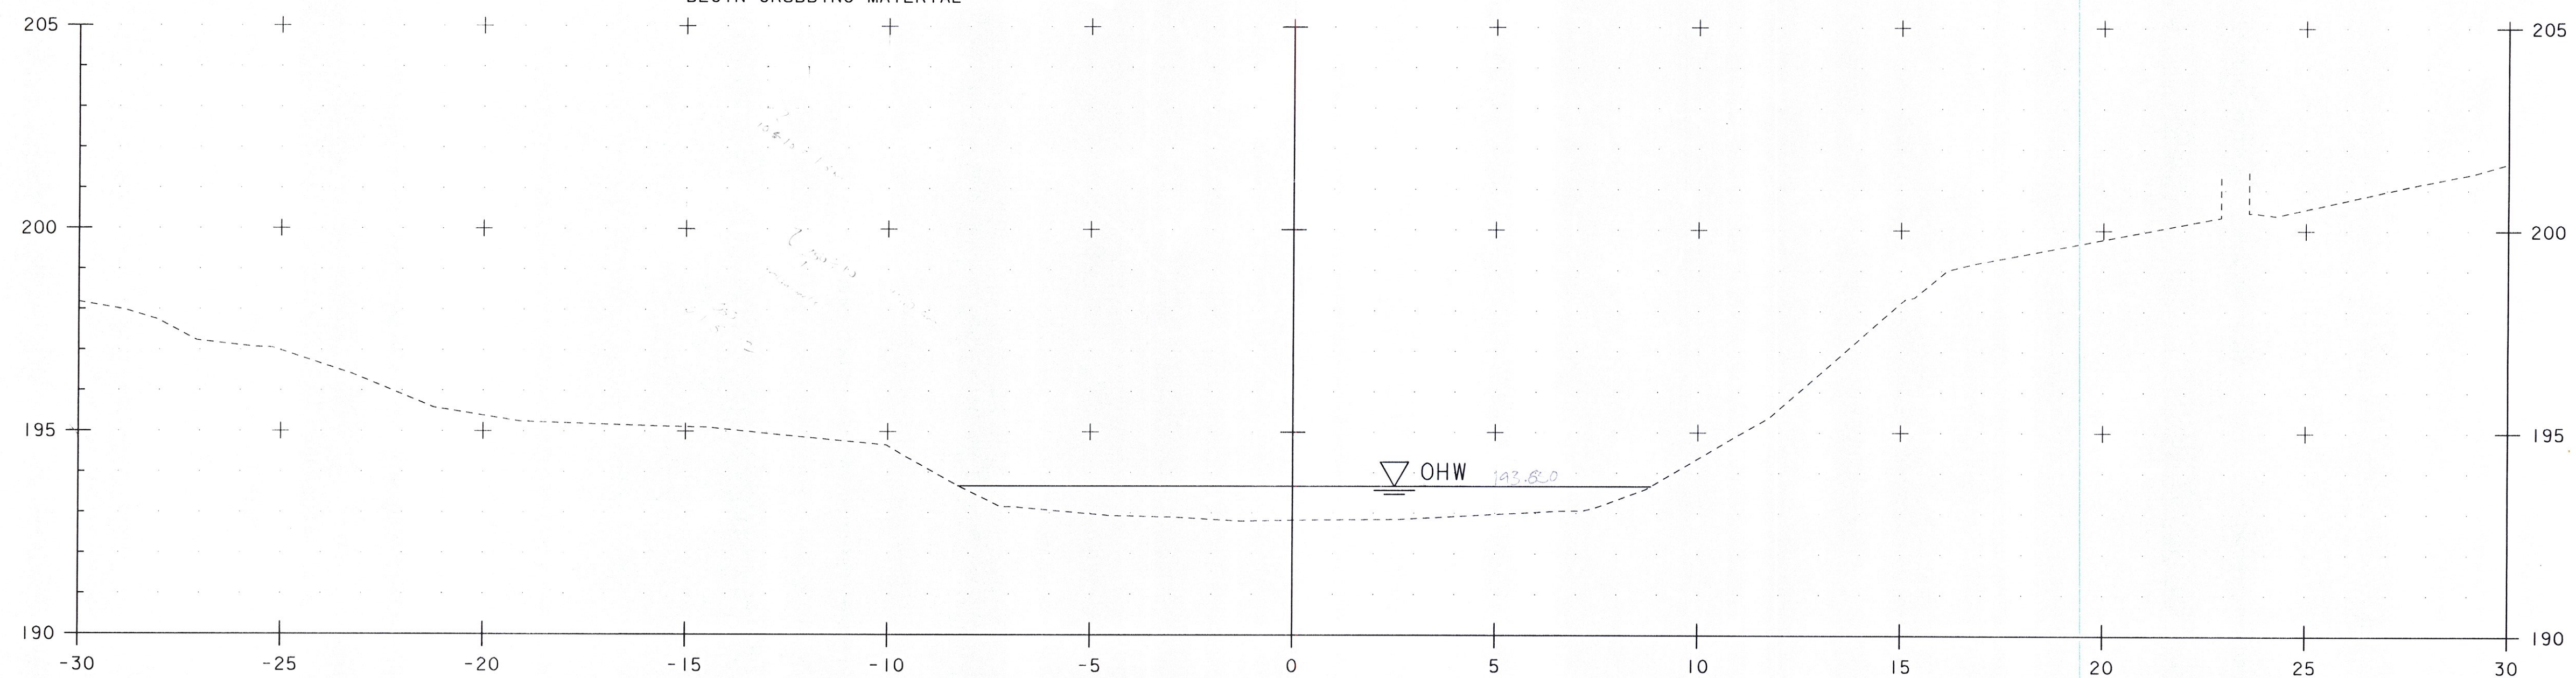

2+030.00

Handwritten notes:
C/C
11/12
11/12

PROJECT NAME: NEWFANE
PROJECT NUMBER: BRF 0106 (3)S

FILE NAME: s95j280xs.dgn
PROJECT MANAGER: C. CARLSON
DESIGNED BY: T. LACKEY
CHANNEL CROSS SECTIONS I

PLOT DATE: 22-JUL-2011
DRAWN BY: C. MOONEY
CHECKED BY: G. SWEENEY
SHEET 54 OF 70

STA. 2+030 TO STA. 2+035