


PI NO. 1
 STA. 10+036.691 BK=
 STA. 10+029.668 AH=
 Δ = 64° 20' 22" LT.

CURVE DATA NO. 1
 Δ = 64° 20' 22"
 R = 52.000
 T = 32.707
 L = 58.391
 E = 9.431
 2T-L = 7.023
 BANKING = VARIES

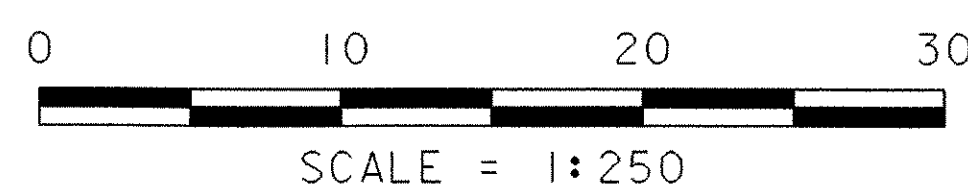

LAYOUT SHEET (1)

PROJECT NAME:	BROOKLINE NEWFANE
PROJECT NUMBER:	BHO 1442 (25)
FILE NAME:	95j278\Structures\sj27810i.i
PROJECT MANAGER:	R. WHITCOMB
DESIGNED BY:	G. ROY
PLOT DATE:	26-JUN-2003
DRAWN BY:	G. ROY
CHECKED BY:	M. LOZIER
SHEET	11 OF 78