

LEGEND

- EXISTING SIGN
- NEW SIGN
- R REMOVE
- N NEW

TRAFFIC SIGNS, TYPE A


- 10+083.8 RT (1)
- 10+097.8 RT (1)
- 10+110.4 RT (2)
- 10+128.8 RT (1)
- 10+129.3 LT (1)
- 10+188.2 LT (1)
- 10+190.7 RT (1)
- 10+200.9 LT (1)
- 10+202.4 LT (1)
- 10+225.7 LT (1)
- 10+310.0 LT (2)
- 30+012.5 LT (1)
- 30+020.0 RT (1)

REMOVING SIGNS

- 10+201.2 LT (1)
- 30+024.7 RT (1)

DURABLE 100mm YELLOW LINE

- 10+070.0-10+098.3 C.L. (DOUBLE)
- 10+110.3-10+260.0 C.L. (DOUBLE)

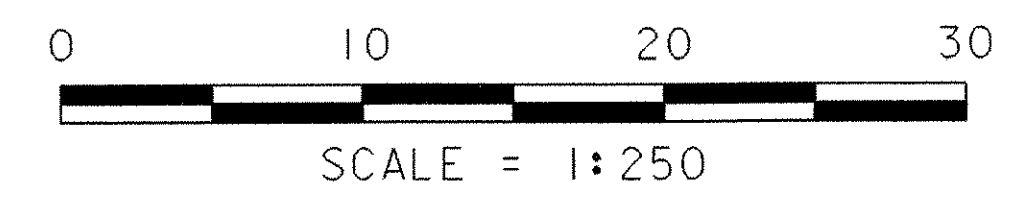

PERMANENT TRAFFIC SIGNS & PAVEMENT MARKINGS LAYOUT SHEET

PROJECT NAME:	BROOKLINE NEWFANE
PROJECT NUMBER:	BH0 1442 (25)
FILE NAME:	95j278\Structures\sj278trf.i
PROJECT MANAGER:	R. WHITCOMB
DESIGNED BY:	G. ROY
PLOT DATE:	26-JUN-2003
DRAWN BY:	G. ROY
CHECKED BY:	M. LOZIER
SHEET	17 OF 78