

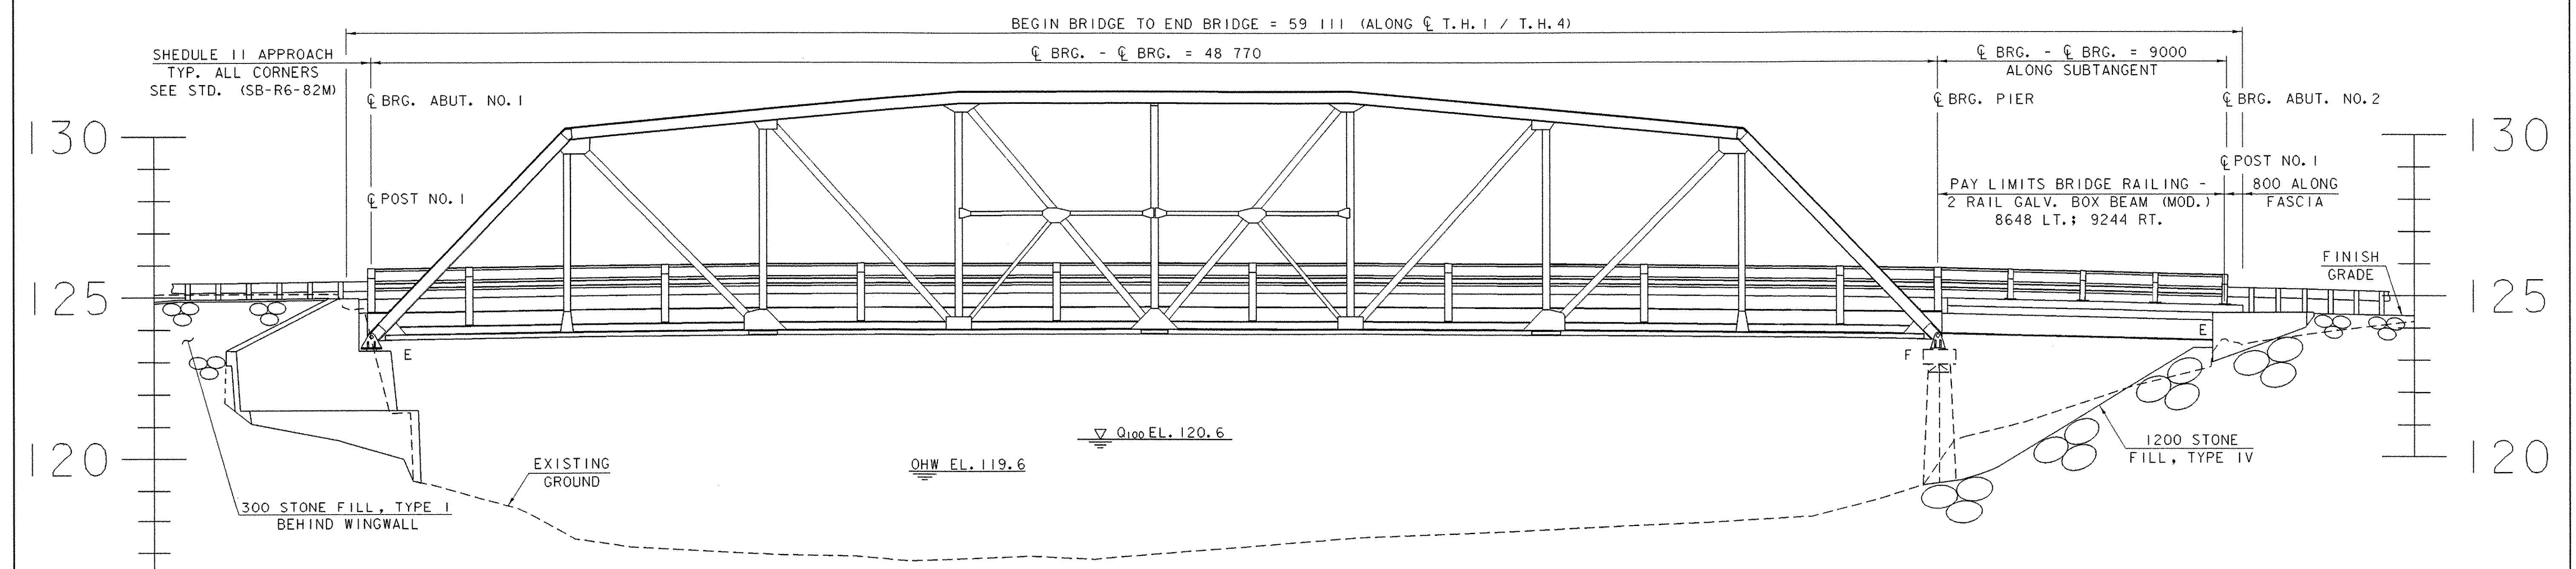


**PLAN**

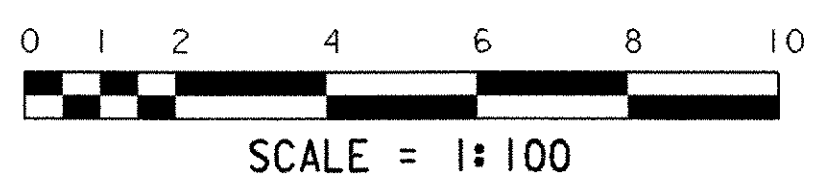

**ELEVATION**

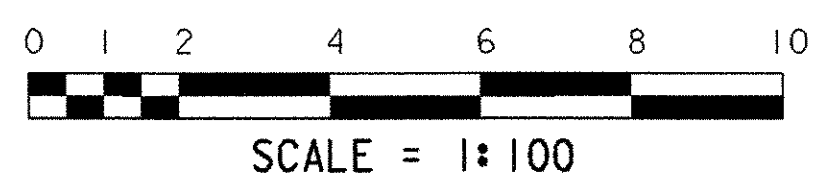

NOTE:  
SEE SHEET 41 FOR ADDITIONAL BRIDGE RAILING DETAILS.

**PLAN AND ELEVATION**

PROJECT NAME:	BROOKLINE-NEWFAINE
PROJECT NUMBER:	BHO 1442 (25)
FILE NAME:	95j278\Structures\sj278pe.i
PROJECT MANAGER:	R. WHITCOMB
DESIGNED BY:	G. ROY
PLOT DATE:	26-JUN-2003
DRAWN BY:	G. ROY
CHECKED BY:	M. LOZIER
SHEET 22 OF 78	