
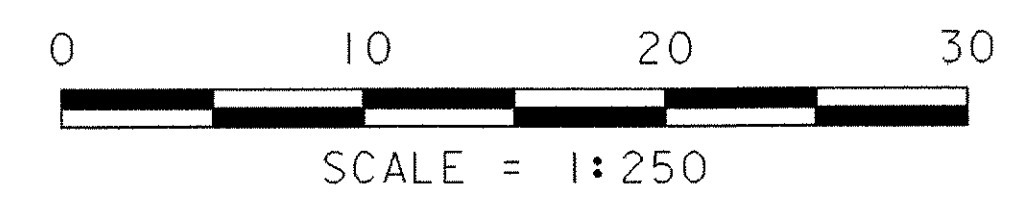


LEGEND

- ARCHEOLOGY — ARCHEOLOGICAL RESOURCE
- FLOOD PLAIN — FLOOD PLAIN LIMIT
- - - - - ORDINARY HIGH WATER LINE

APPROXIMATE AREA OF INVOLVEMENT

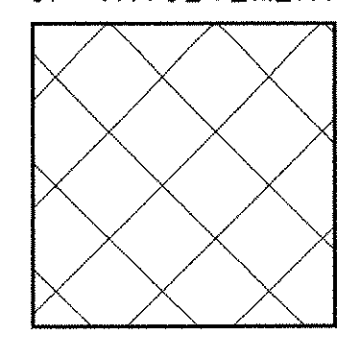

RESOURCES SHEET

PROJECT NAME:	BROOKLINE NEWFANE
PROJECT NUMBER:	BHO 1442 (25)
FILE NAME:	951278\Structures\sj278rsc.i
PROJECT MANAGER:	R. WHITCOMB
DESIGNED BY:	G. ROY
PLOT DATE:	26-JUN-2003
DRAWN BY:	G. ROY
CHECKED BY:	M. LOZIER
	SHEET 24 OF 78