
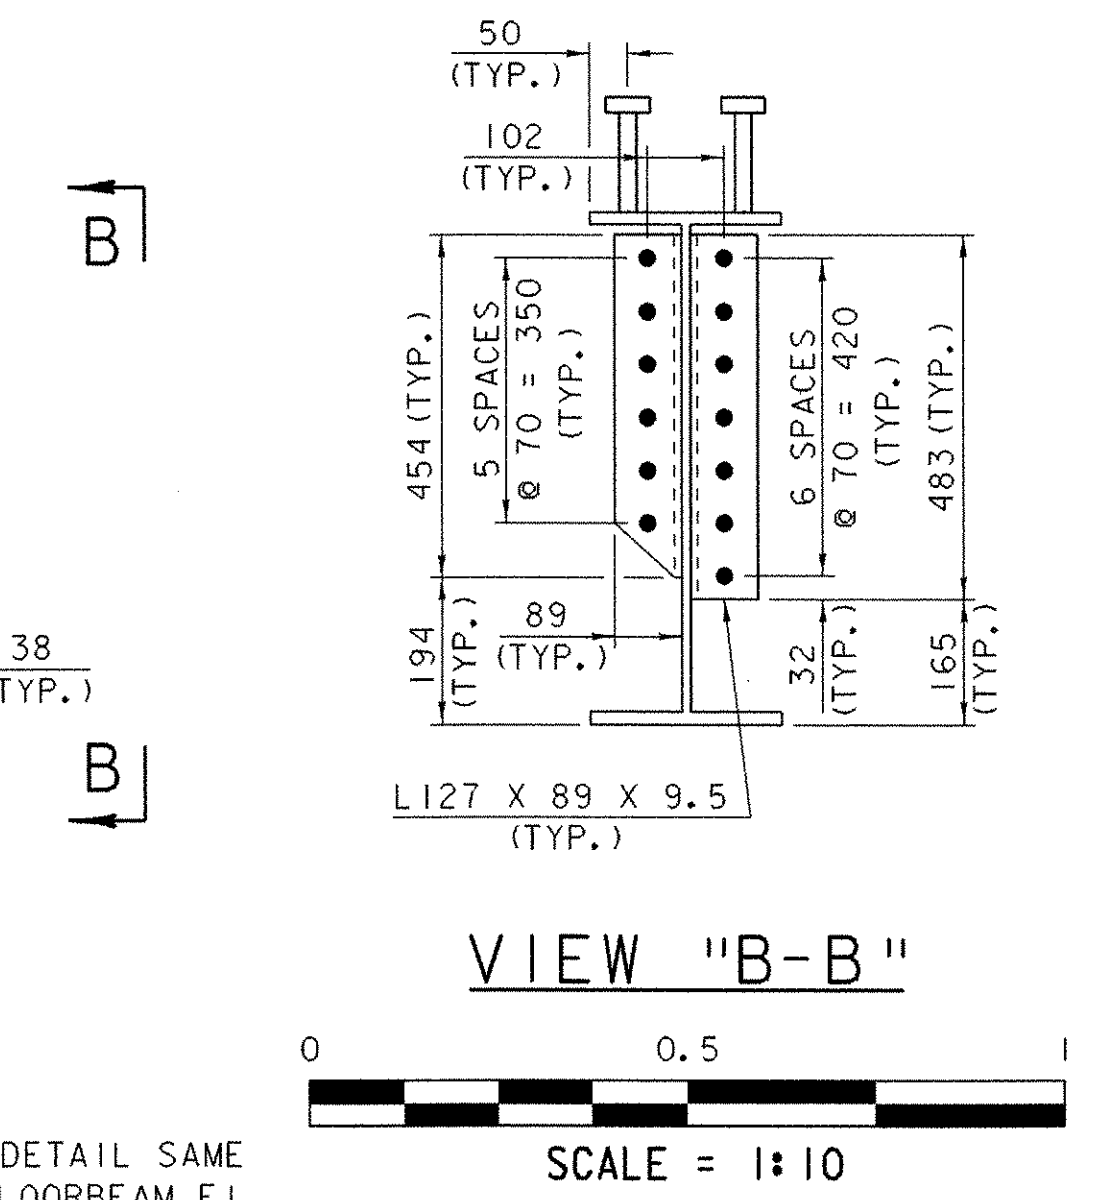


FLOORBEAM DETAILS

PROJECT NAME:	BROOKLINE NEWFANE
PROJECT NUMBER:	BHO 1442 (25)
FILE NAME:	95J278\Structures\sj278fd.i
PROJECT MANAGER:	R. WHITCOMB
DESIGNED BY:	M. LOZIER
PLOT DATE:	26-JUN-2003
DRAWN BY:	G. ROY
CHECKED BY:	M. LOZIER
SHEET	32 OF 78

- NOTES:**
- UNLESS OTHERWISE NOTED, HOLES ARE 24 DIA. FOR AASHTO M164M M22 DIA. HIGH-STRENGTH BOLTS.
 - CVN - SHALL MEET CHARPY V-NOTCH REQUIREMENTS FOR MAIN MEMBERS AS INDICATED IN SECTION 714 OF STANDARD SPECIFICATIONS.

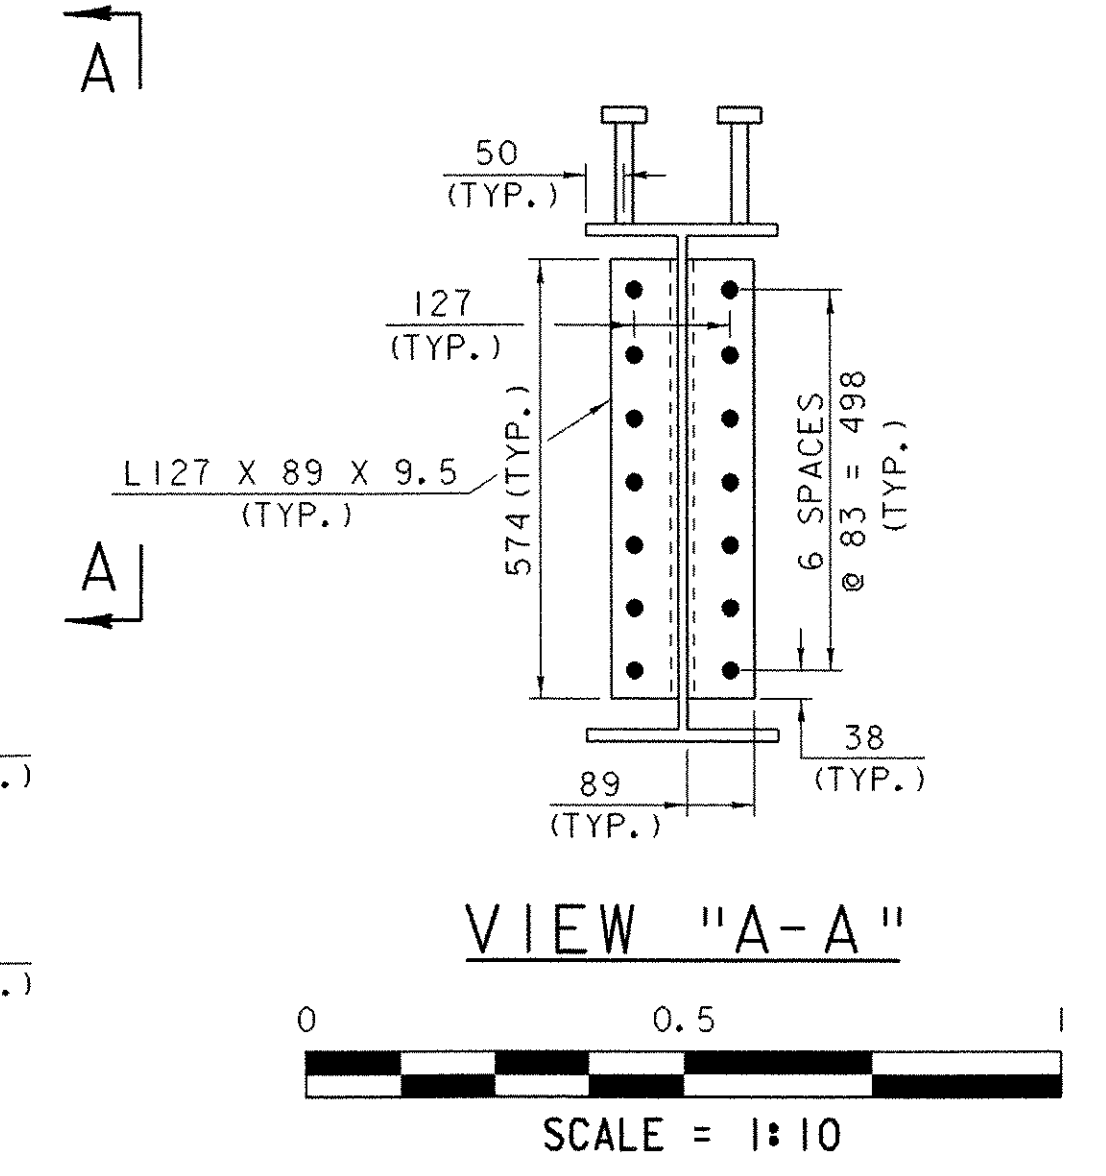

FLOORBEAM "FB2" DETAILS

FLOORBEAMS "FB1" & "FB3" DETAILS