


ROADWAY CROSS SECTIONS (6)

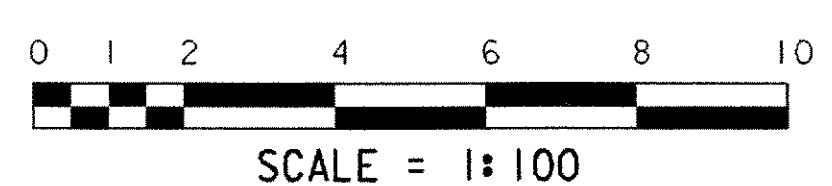

| | |
|---|------------------------|
| PROJECT NAME: BROOKLINE NEWFANE | |
| PROJECT NUMBER: BHO 1442 (25) | |
| FILE NAME: 951278\Structures\sj266m06.i | PLOT DATE: 26-JUN-2003 |
| PROJECT MANAGER: R. WHITCOMB | DRAWN BY: G. ROY |
| DESIGNED BY: G. ROY | CHECKED BY: M. LOZIER |
| SHEET 54 OF 78 | |