


CHANNEL CROSS SECTIONS LEFT (2)

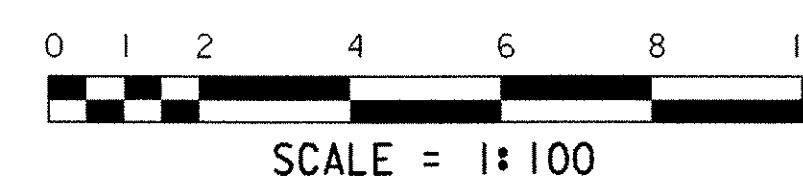

PROJECT NAME:	BROOKLINE NEWFANE
PROJECT NUMBER:	BH0 1442 (25)
FILE NAME:	95j278\Structures\sj266c02.i
PROJECT MANAGER:	R. WHITCOMB
DESIGNED BY:	G. ROY
PLOT DATE:	26-JUN-2003
DRAWN BY:	G. ROY
CHECKED BY:	M. LOZIER
SHEET	57 OF 78