


CHANNEL CROSS SECTIONS LEFT (3)

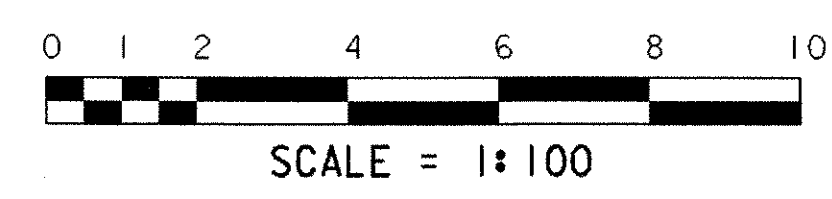

PROJECT NAME:	BROOKLINE NEWFANE	FILE NAME:	95\278\Structures\sj266c03.i	PLOT DATE:	26-JUN-2003
PROJECT NUMBER:	BHO 1442 (25)	PROJECT MANAGER:	R. WHITCOMB	DRAWN BY:	G. ROY
		DESIGNED BY:	G. ROY	CHECKED BY:	M. LOZIER
				SHEET	58 OF 78