


CHANNEL CROSS SECTIONS LEFT (5)

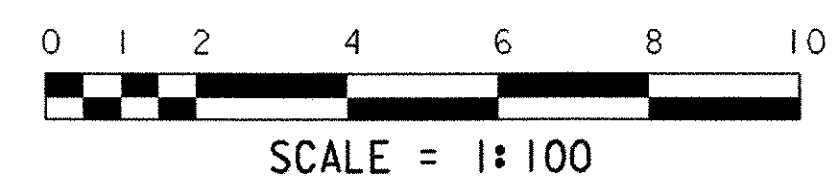

PROJECT NAME:	BROOKLINE NEWFANE	PLOT DATE:	26-JUN-2003
PROJECT NUMBER:	BHO 1442 (25)	DRAWN BY:	G. ROY
FILE NAME:	95j278\Structures\sj266c05.i	CHECKED BY:	M. LOZIER
PROJECT MANAGER:	R. WHITCOMB	SHEET	60 OF 78
DESIGNED BY:	G. ROY		