

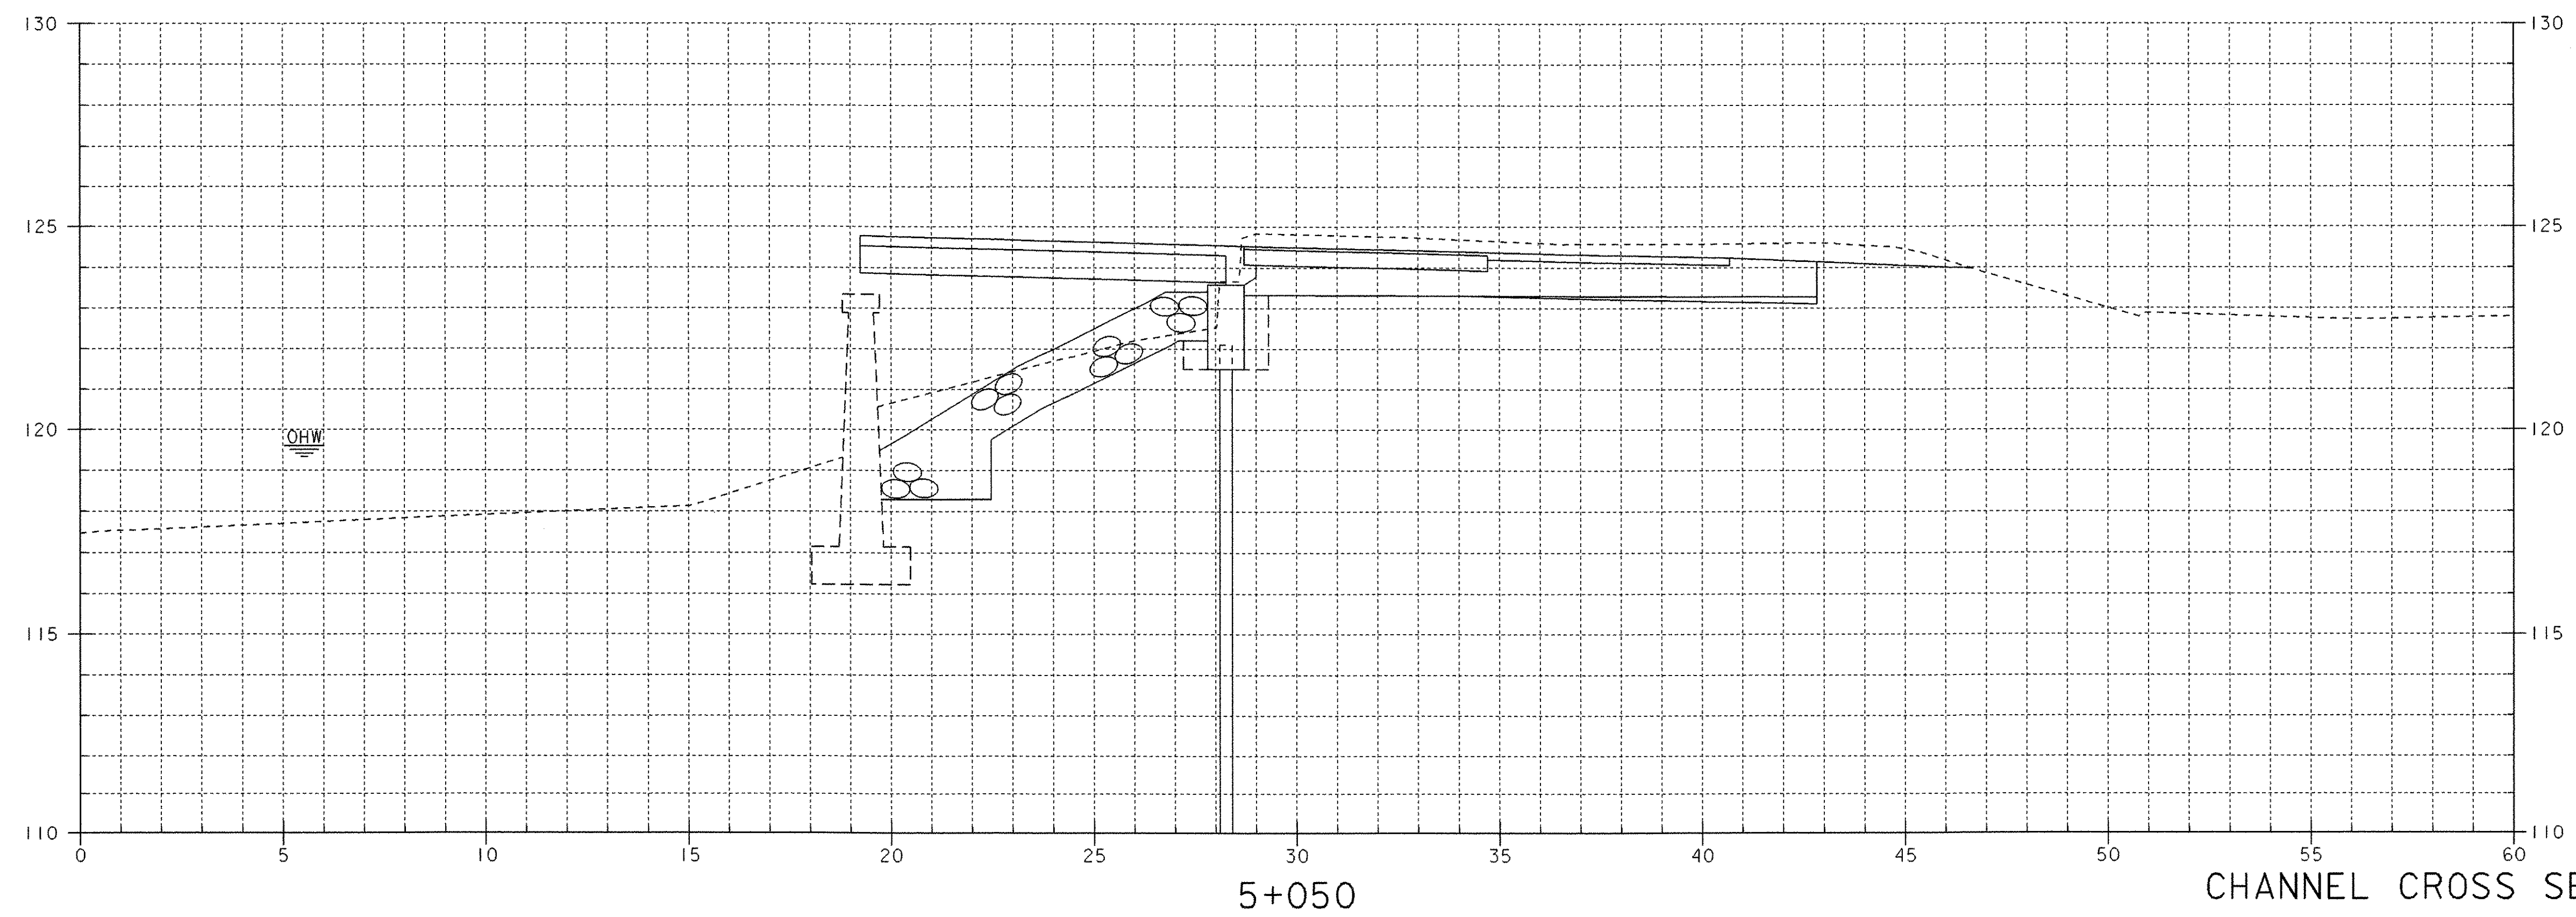


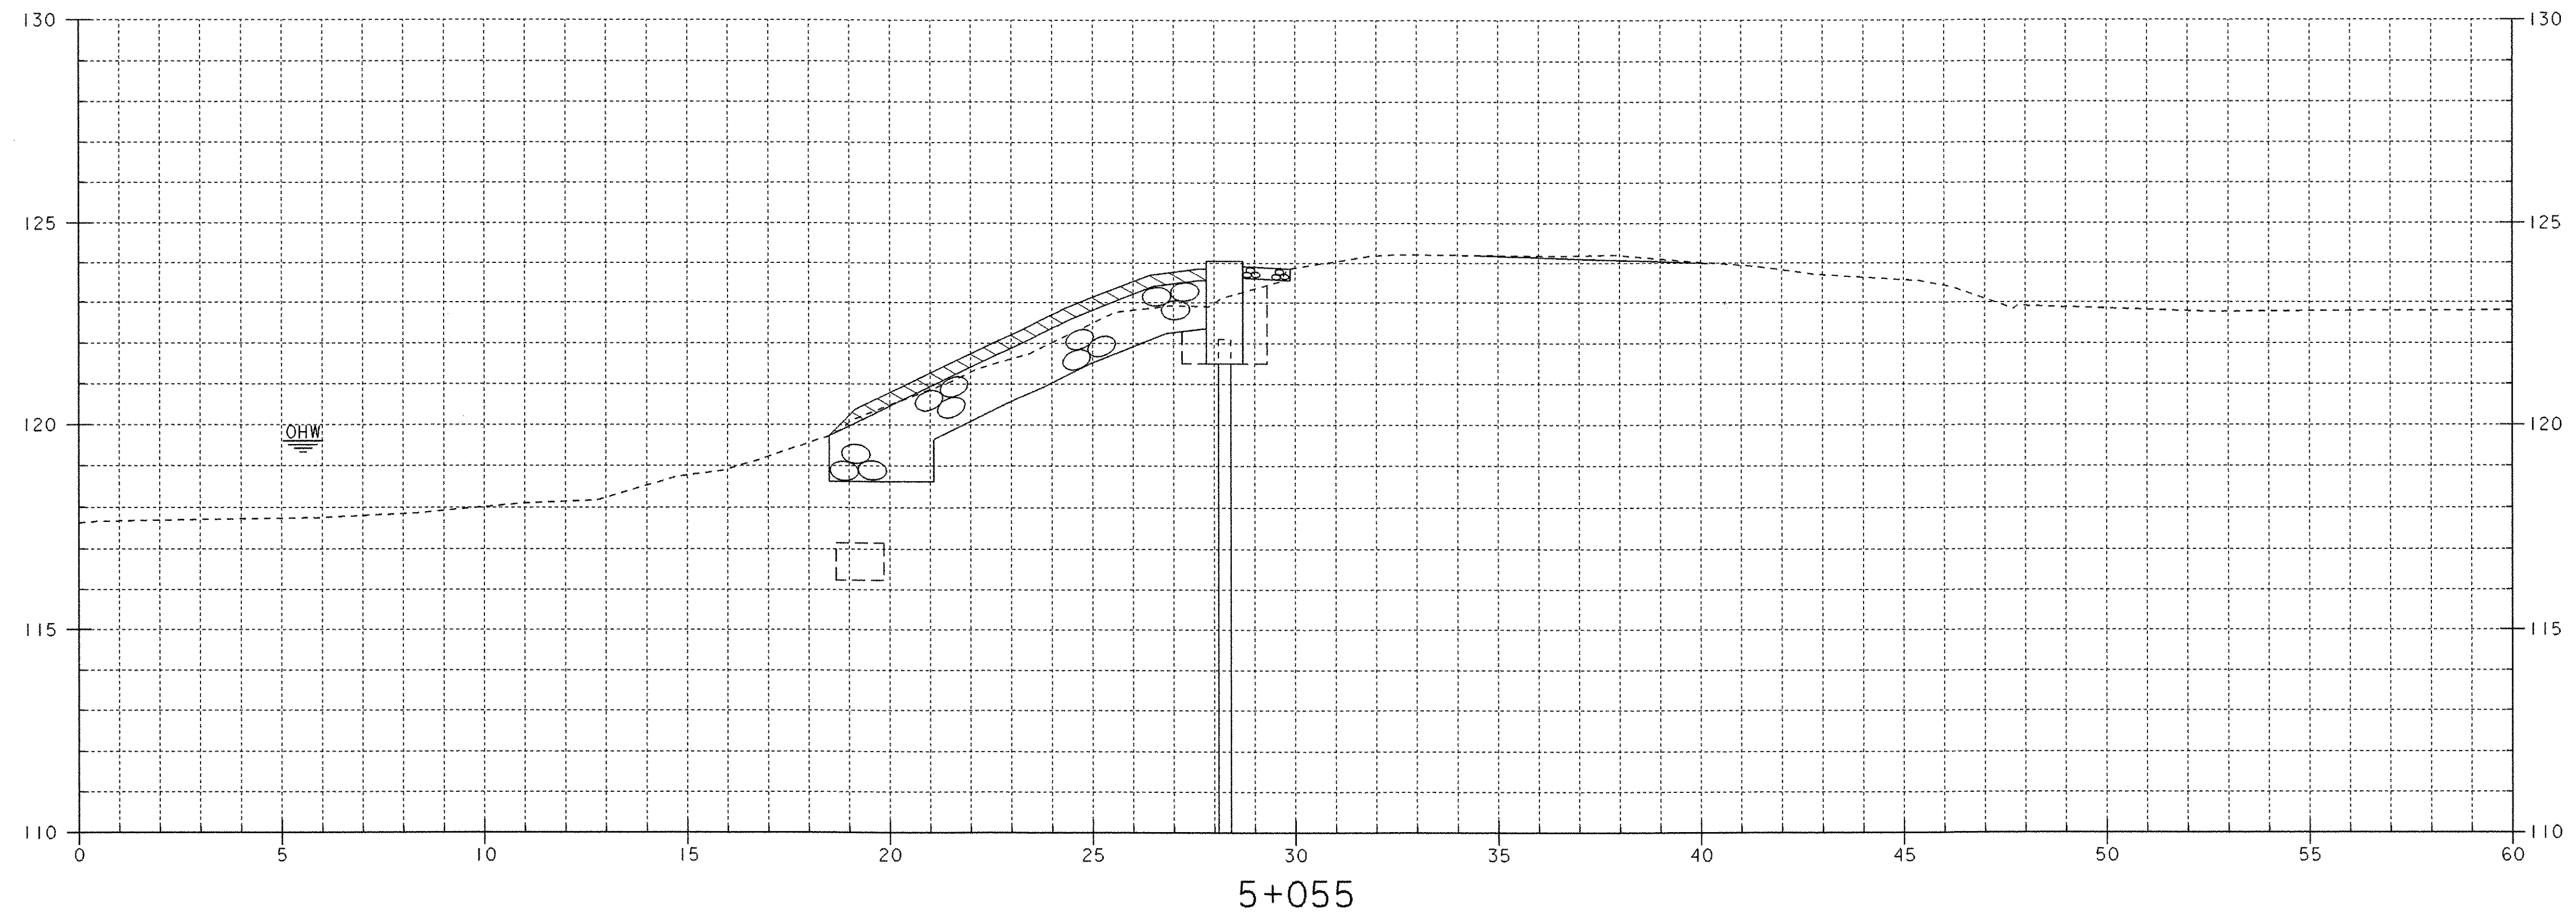

CHANNEL CROSS SECTIONS RIGHT (4)

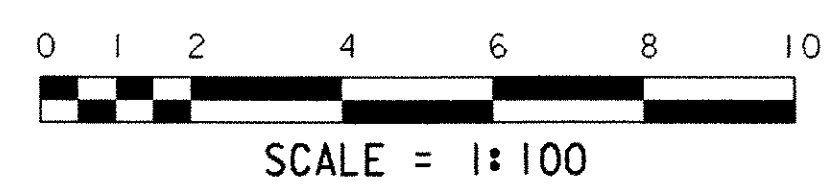

PROJECT NAME:	BROOKLINE NEWFANE	FILE NAME:	951278\Structures\sj266cl0.i	PLOT DATE:	26-JUN-2003
PROJECT NUMBER:	BHO 1442 (25)	PROJECT MANAGER:	R. WHITCOMB	DRAWN BY:	G. ROY
		DESIGNED BY:	G. ROY	CHECKED BY:	M. LOZIER
				SHEET	65 OF 78