
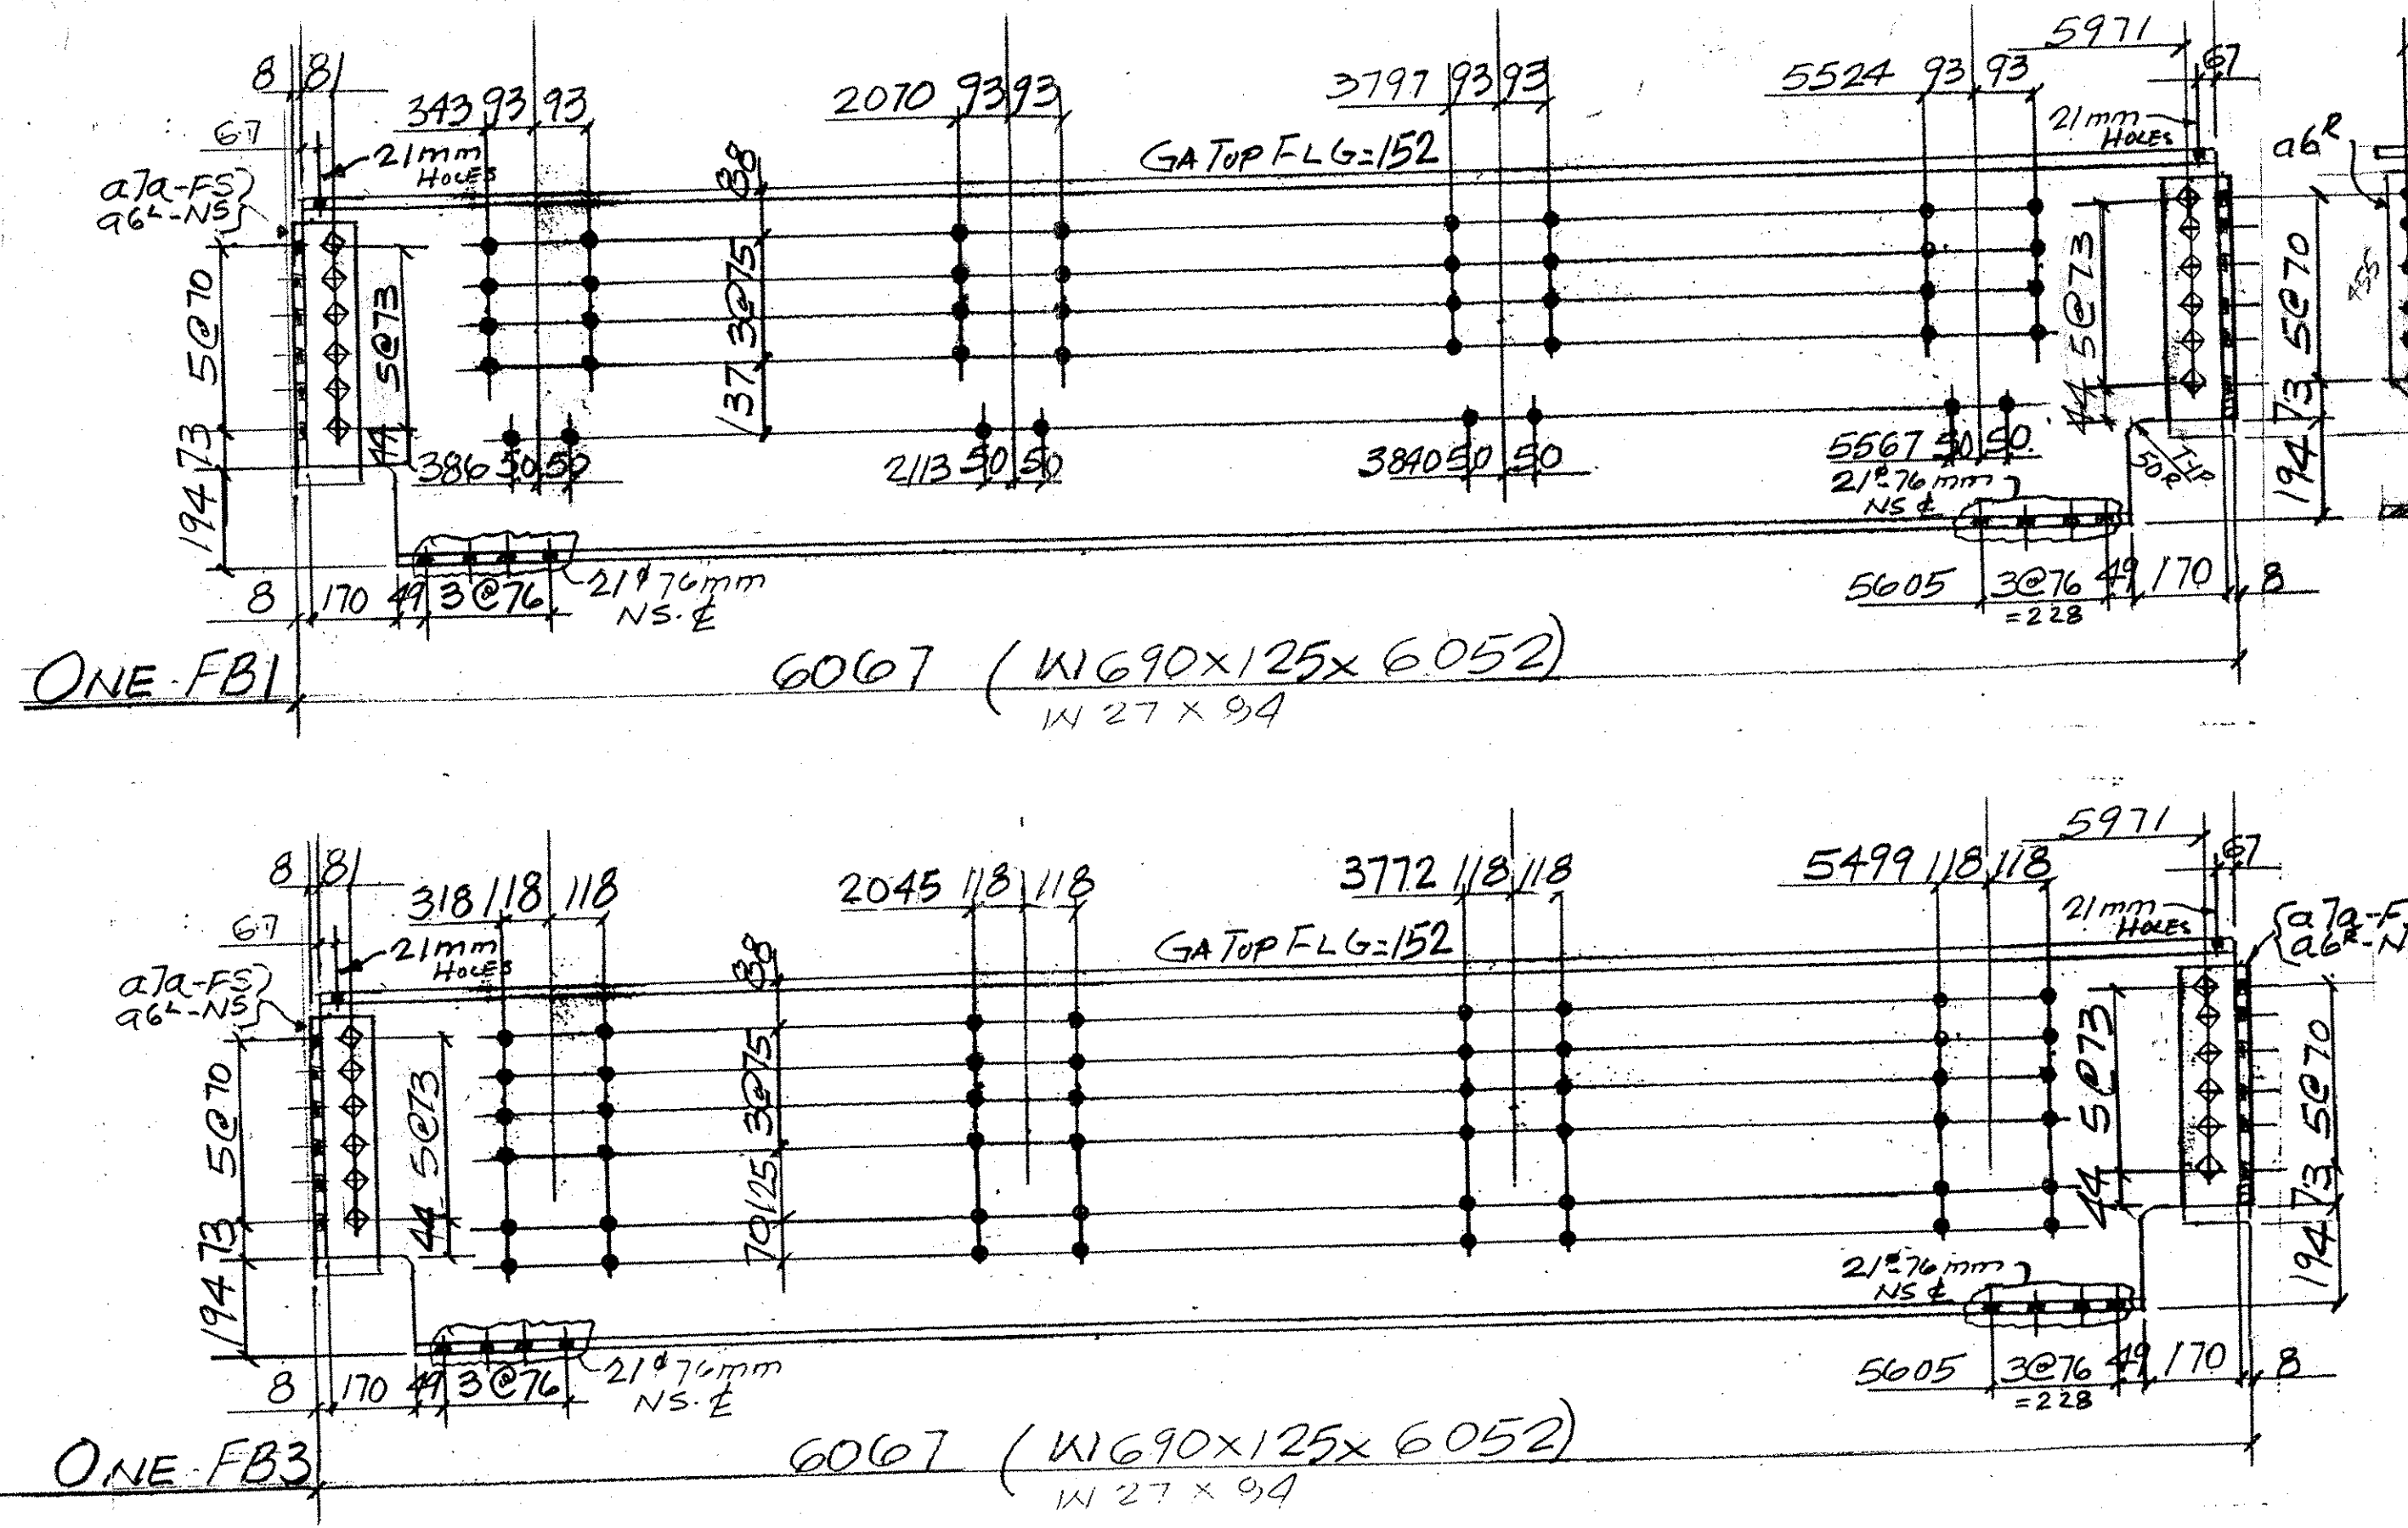
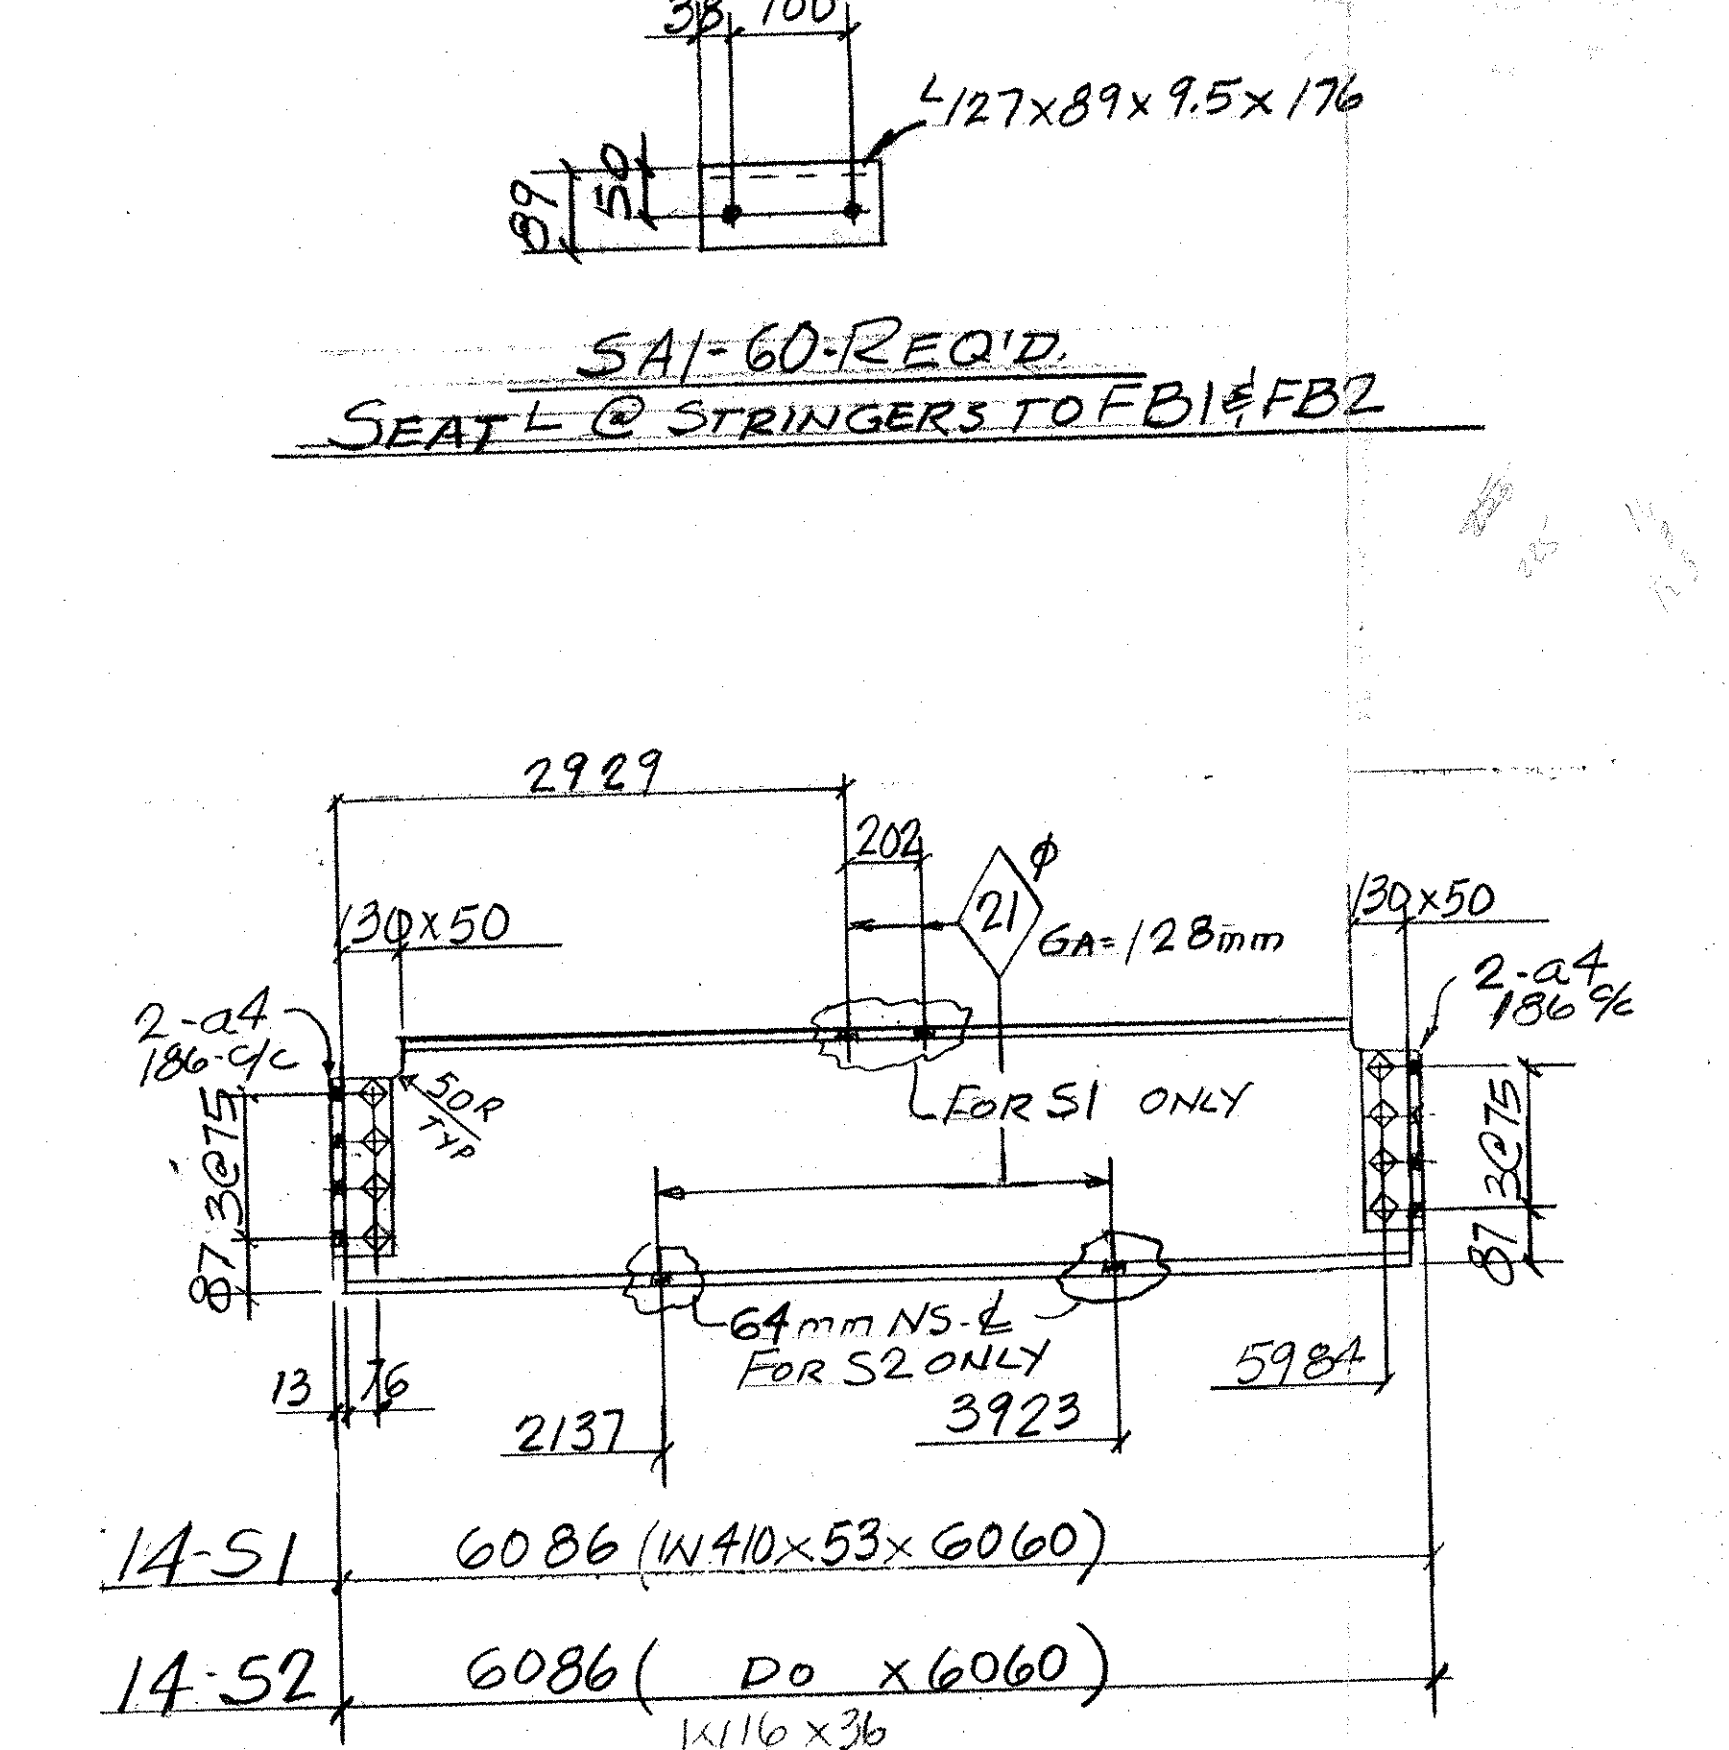
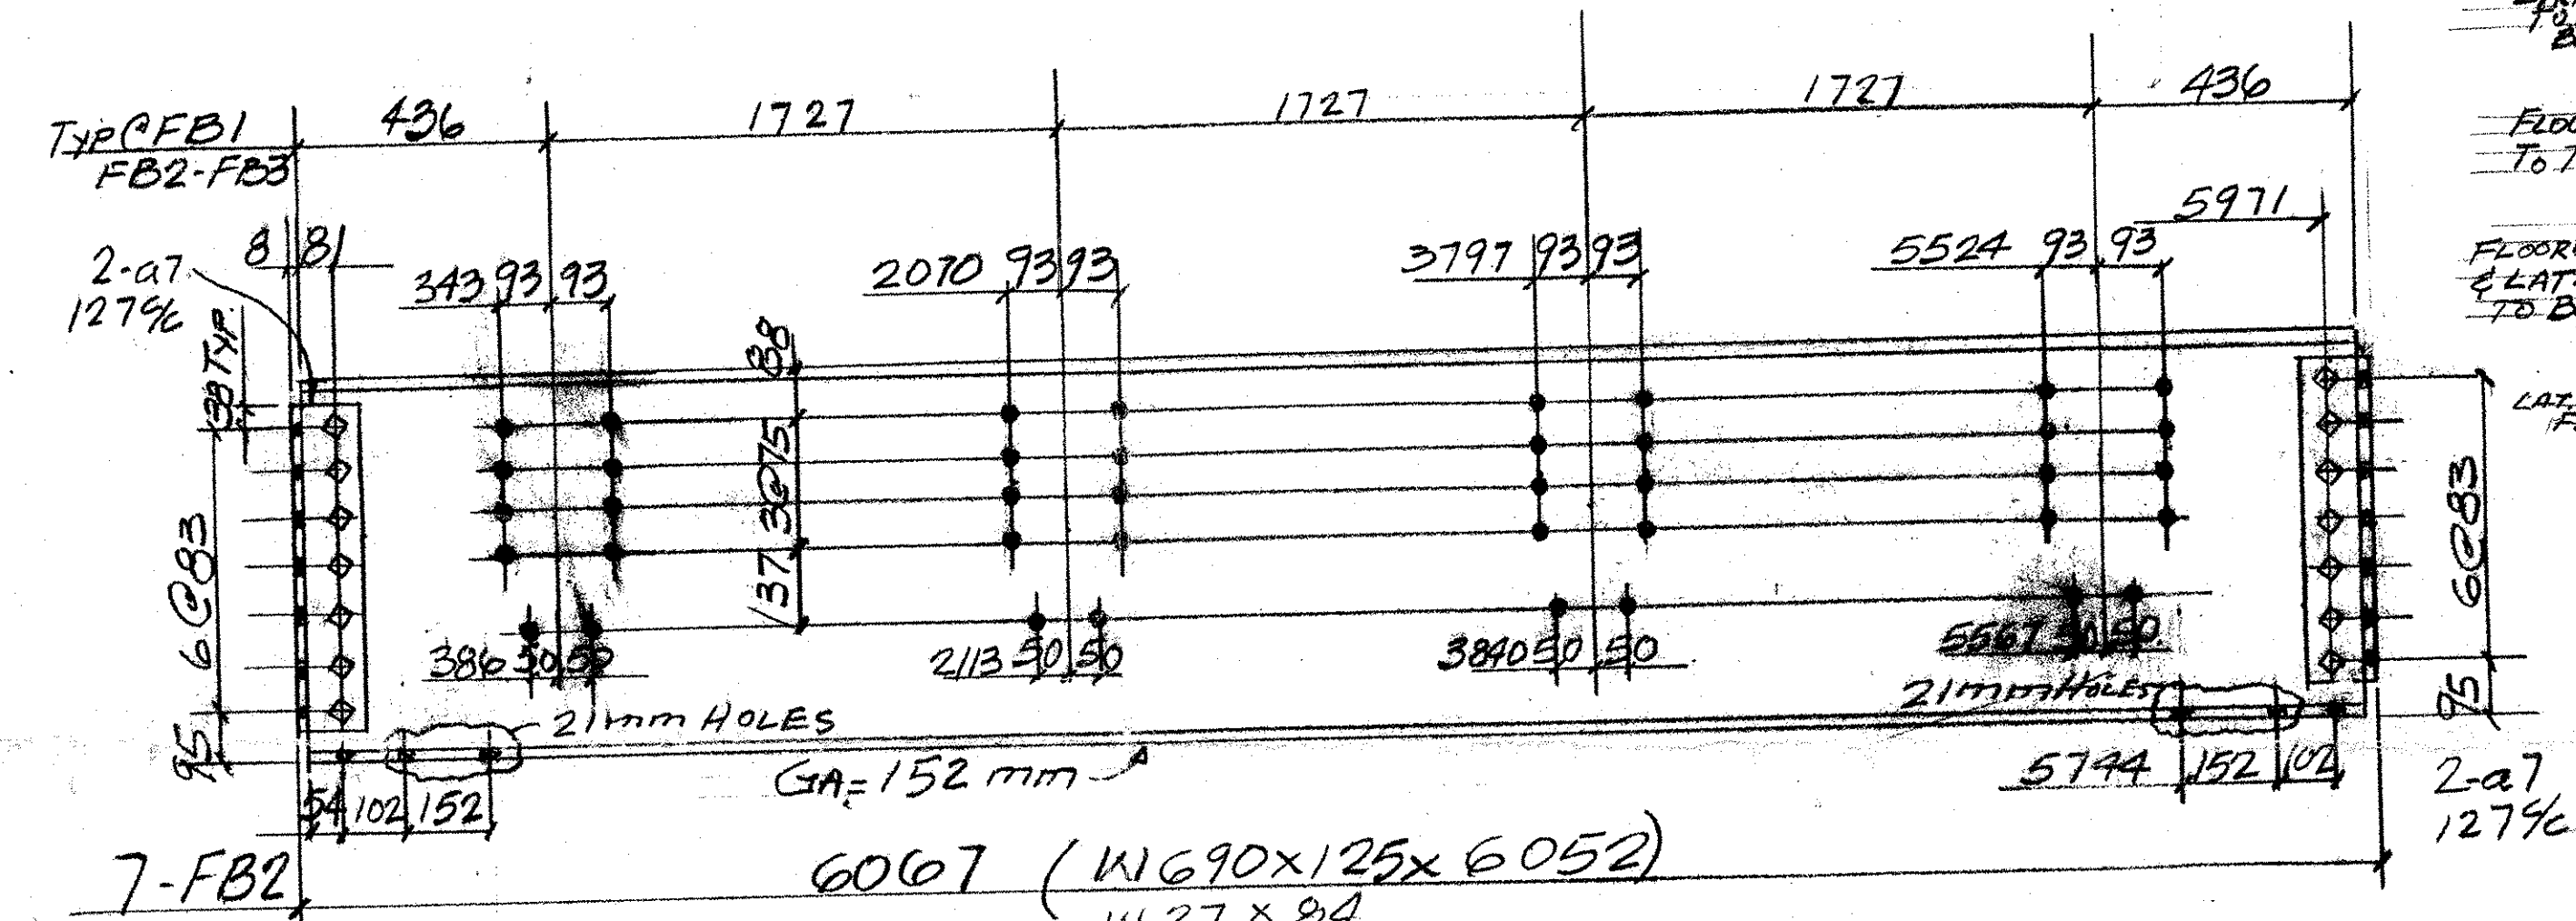


FLOOR FRAMING PLAN

X° = 83° 32' 03"
Y° = 77° 13' 44"

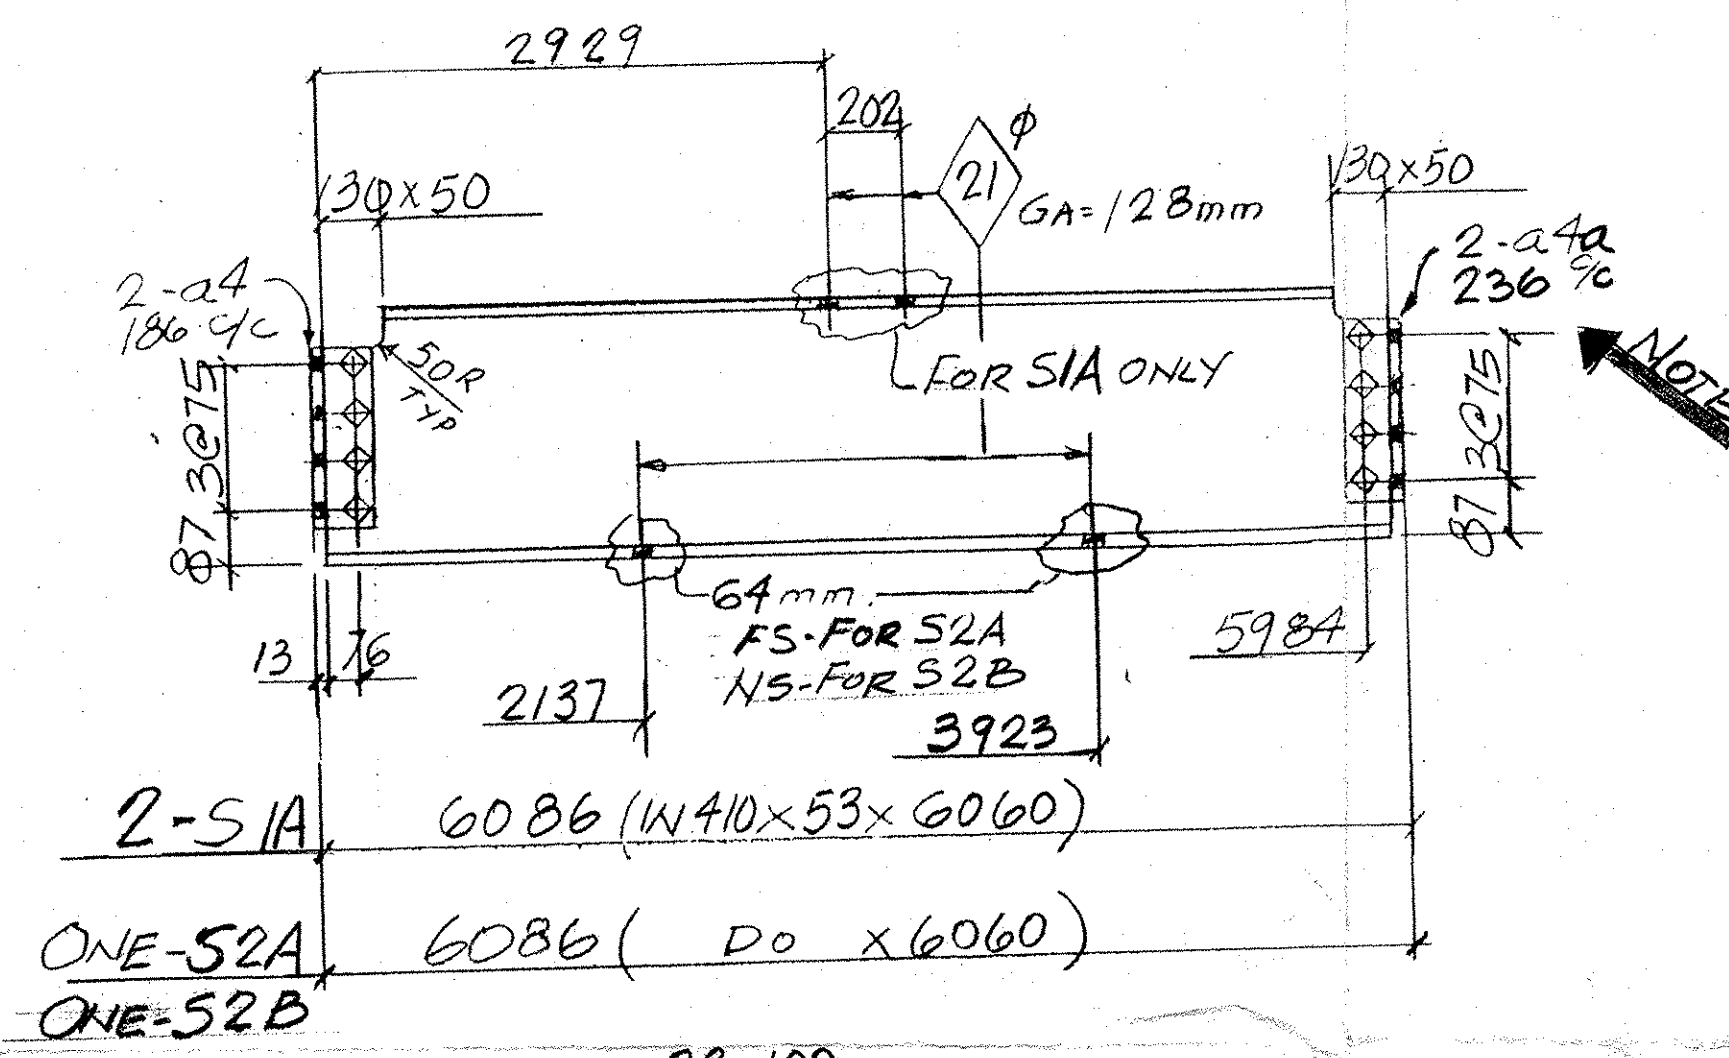

ABM INFO		SHOP BILL				JOB NO. 208	DRG. NO. S2	
PAGE	LINE	NO.	DESCRIPTION	MM	ASSEM MARK	SHIPPING MARK	REMARKS	WEIGHT
14		14	W410x53	6060		S1	CVN	
14		14	DO	6060		S2		
2		2	DO	6060		S1A		
1		1	DO	6060		S2A		
1		1	DO	6060		S2B	CVN	
120		120	L127x127x9.5	301	a4			
8		8	L152x152x9.5	301	a7a			
256		256	M22 BOLTS	64	SHOP		W/NEENHAWK GALV.	
7		7	W690x125	6052		FB2	CVN	
28		28	L127x89x9.5	574	a7			
1		1	W690x125	6052		FB1	CVN	
2		2	L127x89x9.5	484	a7a			
2		2	DO	455	a6a			
1		1	W690x125	6052		FB3	CVN	
2		2	L127x89x9.5	484	a7a			
2		2	DO	455	a6a			
122		122	M22 BOLTS	64	SHOP		W/NEENHAWK GALV.	
60		60	L127x89x9.5	176		SA1		
320		320	M22 BOLTS	64		FIELD	W/NEENHAWK GALV.	
56		56	DO	57		DO	DO DO	
44		44	DO	57		DO	DO DO	
64		64	DO	64		DO	DO DO	
140		140	DO	70		DO	DO DO	
52		52	DO	57		DO	DO DO	
16		16	DO	64		DO	DO DO	
48		48	DO	76		DO	DO DO	
12		12	DO	90		DO	DO DO	
72		72	M19 BOLTS	57		FIELD	W/NEENHAWK GALV.	
		PAY ITEM 506.50:		S1, S2, S1A, S2A, S2B, FB1, FB2 & FB3				
		PAY ITEM 506.60:		ALL OTHER STEEL				

ALL BOLTS (SHOP & FIELD) TO BE AASHTO-M19-TYPE I GALV.

PLANS DRAWN USING METRIC DIMENSIONS

RECEIVED
CHKD BY: G. ROY, OKD BY: J. J. J.
2-18-04
FEB 12 2004
RESUBMIT BY: RRW, APPROVED AS LISTED DATE: 2-24-04

~ STRUCTURES COPY ~

REV.	REMARKS	DATE	DWN	CHK	APP	Q.A.	NO.	DIA.	LGT	TYPE	WASHER
	OUT FOR APPROVAL	1-2-04									
	OUT FOR APPROVAL	FILED	2-6-04								
	ISSUED TO SHOP										
	FIELD & OFFICE										
	PROJECT NO. BHO-1442 (25)										
	STATE BRIDGE NO. 19 (BROOKLINE)										
	MATERIAL: AASHTO M22										
	ELECTRODES: -										
	HOLES: 24" U.N.										
	SHOP BOLTS: M22										
	SURFACE PREP. & PAINT: PREP. SSPC-SP-10										
	AASHTO-M19-GALV										
	3-COAT SYSTEM C										
	PRIMER - WATER - MC ZINC										
	INTERMEDIATE - WATER - MC FERROX B										
	TOP COAT - WATER - MC LUSTER GREEN FED CHIP #1402										
	DESCRIPTION: FLOOR BEAMS & STRINGERS										
	JOB:										
	BRIDGE REHAB.										
	BROOKLINE-NEWFANE VT.										
	CUSTOMER: RENAUD BROTHERS										
	CASCO BAY STEEL STRUCTURES, INC.										
	75 SPRING HILL ROAD SACO, MAINE 04072										
	PHONE (207) 282-7360 FAX. (207) 282-1179										
	JOB NO. 208										
	DRG. NO. S2										
	REV. 1										