



SEE SHEET 2 FOR
INDEX OF SHEETS AND
LIST OF STANDARDS

STATE OF VERMONT AGENCY OF TRANSPORTATION

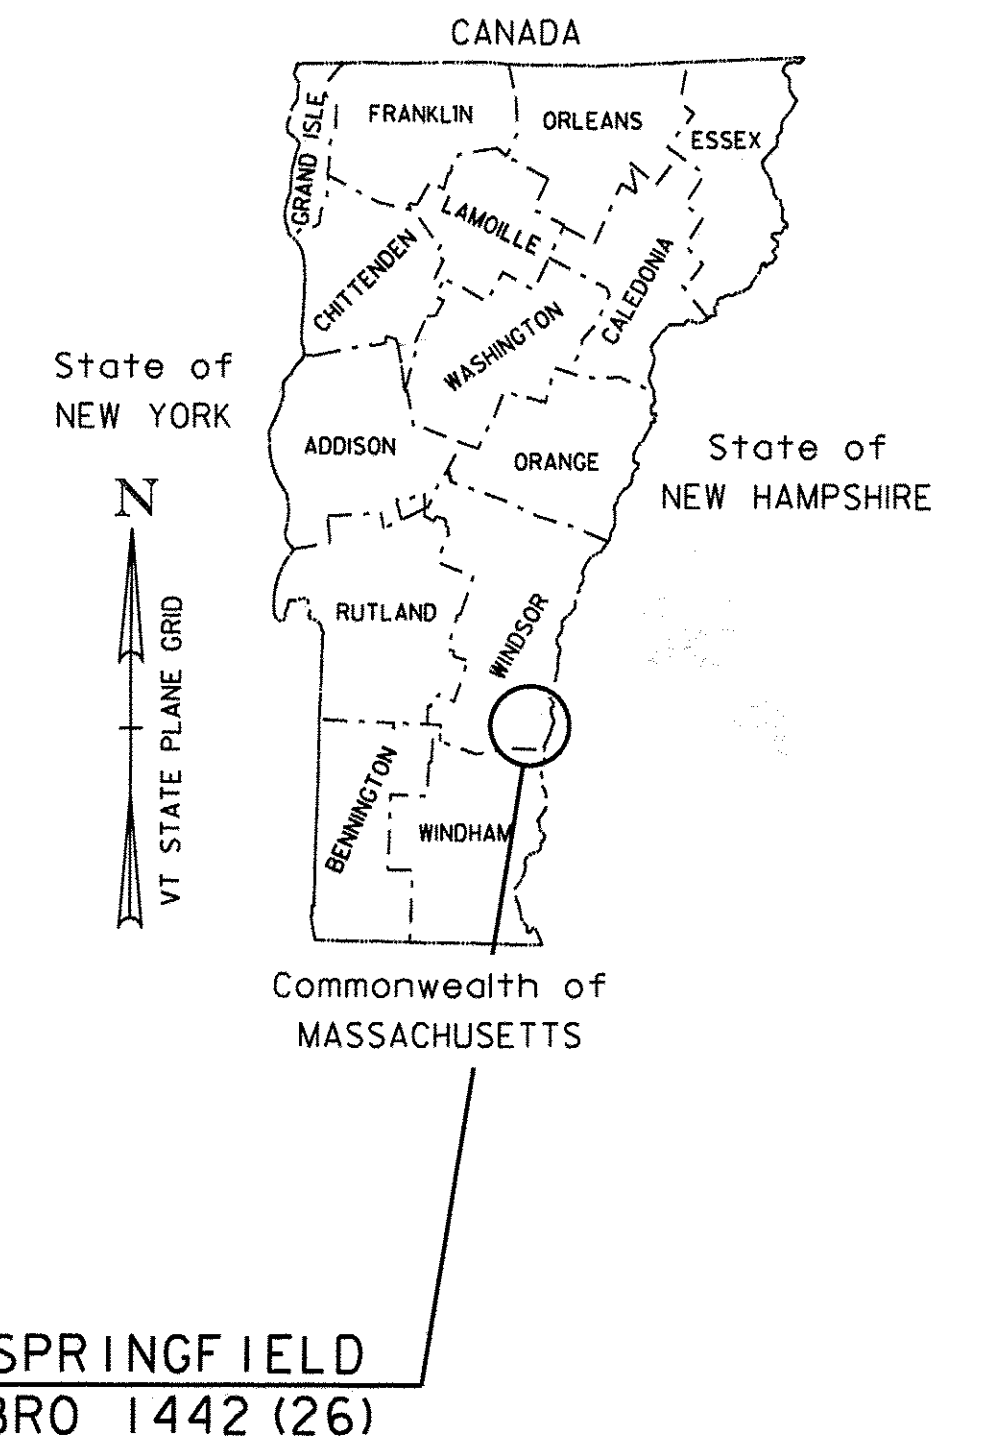

PROPOSED IMPROVEMENT BRIDGE PROJECT TOWN OF SPRINGFIELD COUNTY OF WINDSOR

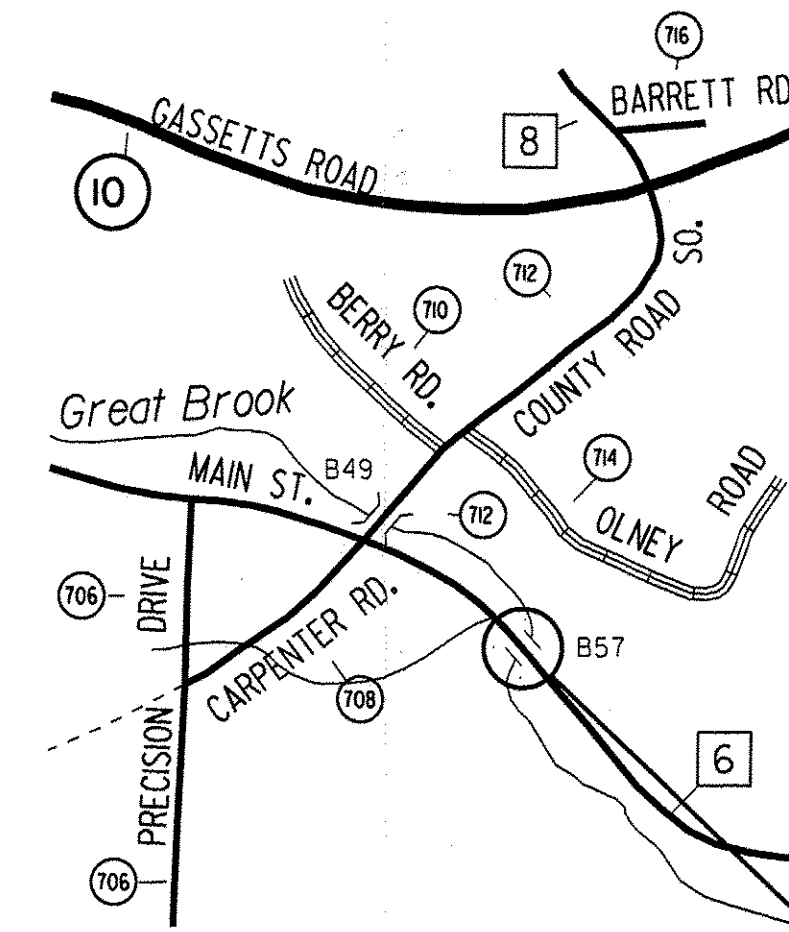


RECORD PLANS	
CONTRACTOR:	T. BUCK - AUBURN, ME.
RESIDENT ENGINEER:	CHAD GREENWOOD
CONSTRUCTION BEGAN:	APRIL 23, 2012
CONSTRUCTION COMPLETE:	JUNE 14, 2013
RECORD PLANS BY:	CHAD GREENWOOD & N. GARBACIK
I HEREBY CERTIFY THAT ALL THE CONSTRUCTION REQUIRED BY THIS SET OF DRAWINGS HAS BEEN ACCOMPLISHED AS INDICATED HEREIN.	
BY	RESIDENT ENGINEER
DATE	11/4/13
NOTE: Any further information concerning final quantities, amounts or other details relative to this project may be found at Central Files in the electronic archives.	

ROUTE NO : TH 6 CLASS III, LOCAL ROAD BRIDGE NO : 57

PROJECT LOCATION : BRIDGE #57 IS LOCATED ON TOWN HIGHWAY 6 APPROXIMATELY 0.63 MILES EAST OF THE INTERSECTION WITH VT 10
PROJECT DESCRIPTION : REPLACEMENT OF EXISTING BRIDGE WITH A NEW CURVED GIRDER BRIDGE ON NEW ABUTMENTS AND NECESSARY APPROACH WORK.

LENGTH OF STRUCTURE : 134.76 FEET.
LENGTH OF ROADWAY : 115.24 FEET.
LENGTH OF PROJECT : 250.00 FEET.

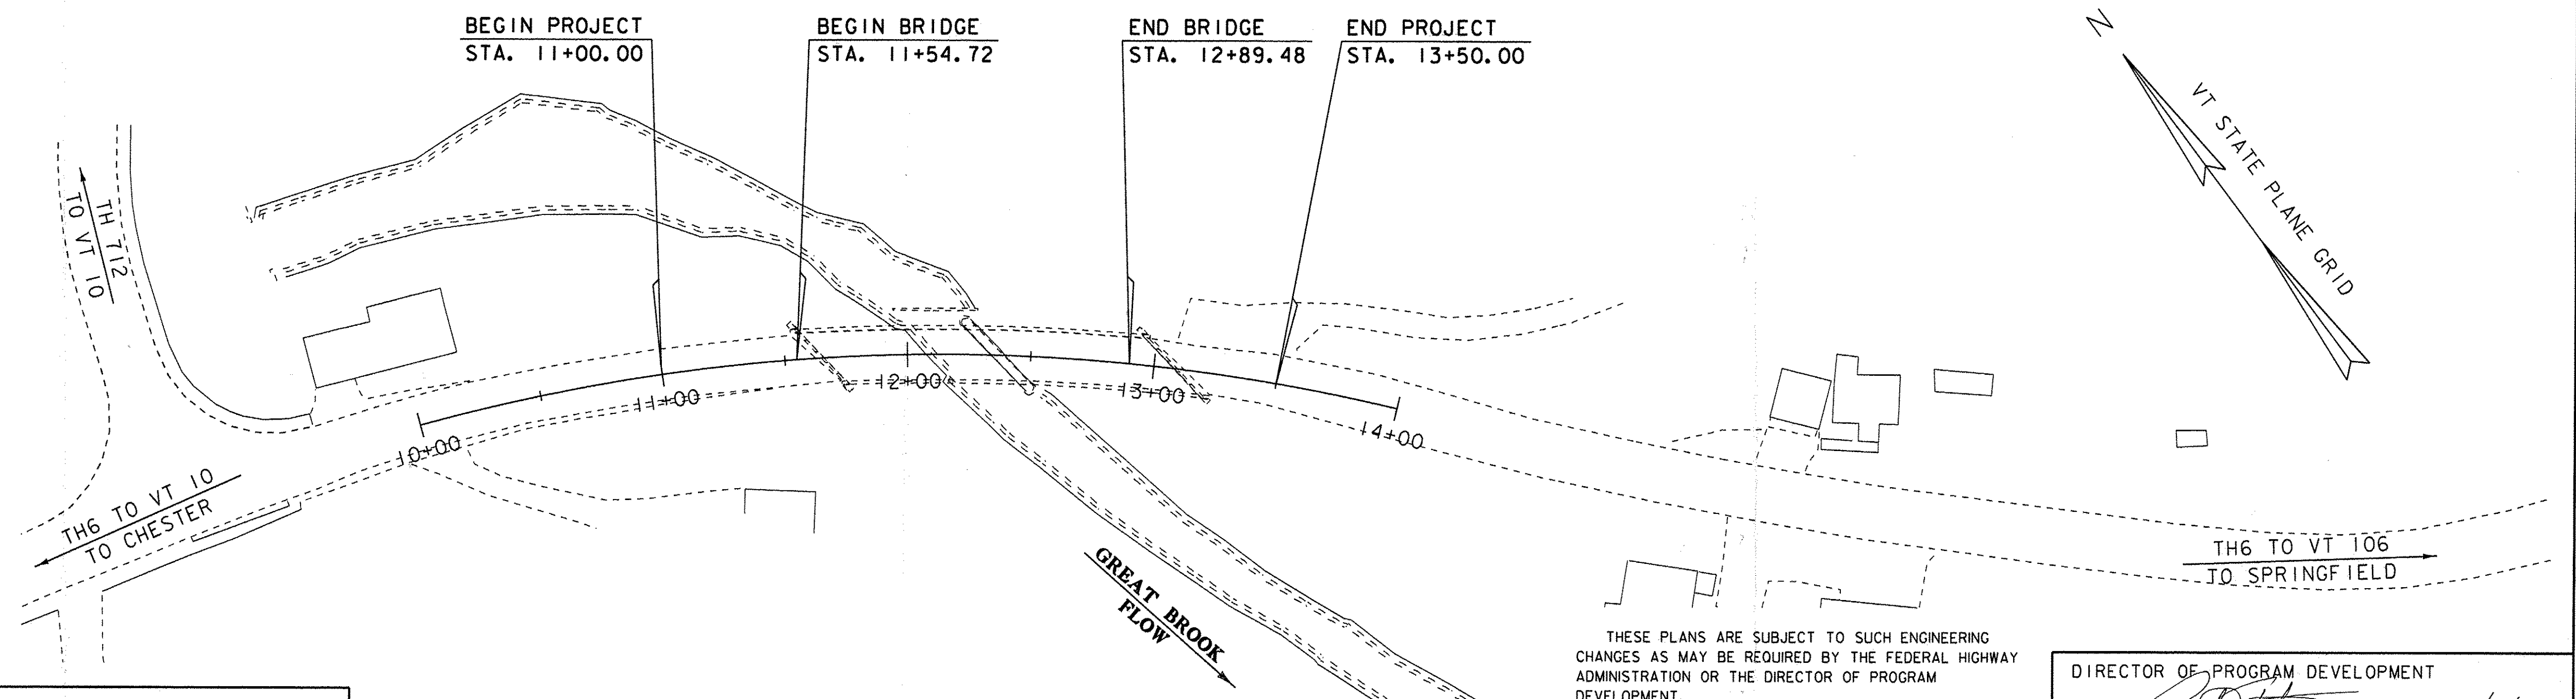

QUALITY ASSURANCE PROGRAM: LEVEL 2

CONVENTIONAL SYMBOLS	
COUNTY LINE	
TOWN LINE	
LIMITS OF ACCESS	
POINT OF ACCESS	
FENCE LINE	
STONE WALL	
TRAVELED WAY	
GUARD RAIL	
RAILROAD	
SURVEY LINE	
CULVERT	
POWER POLE	
TELEPHONE POLE	
TREES	
CONTROL OF ACCESS	
PROPERTY LINE	
R.O.W. TAKING LINE	
SLOPE RIGHTS	
TOP OF CUT	
TOE OF SLOPE	

SURVEYED BY : RDG
SURVEYED DATE : JANUARY 1996

DATUM
VERTICAL : NAVD 88
HORIZONTAL : NAD 83 (92)

SCALE 1" = 40'-0"
40 0 40

THESE PLANS ARE SUBJECT TO SUCH ENGINEERING CHANGES AS MAY BE REQUIRED BY THE FEDERAL HIGHWAY ADMINISTRATION OR THE DIRECTOR OF PROGRAM DEVELOPMENT.
CONSTRUCTION IS TO BE CARRIED ON IN ACCORDANCE WITH THESE PLANS AND THE STANDARD SPECIFICATIONS FOR CONSTRUCTION DATED 2006, AS APPROVED BY THE FEDERAL HIGHWAY ADMINISTRATION ON JUNE 15, 2006 FOR USE ON THIS PROJECT, INCLUDING ALL SUBSEQUENT REVISIONS AND SUCH REVISED SPECIFICATIONS AND SPECIAL PROVISIONS AS ARE INCORPORATED IN THESE PLANS.

DIRECTOR OF PROGRAM DEVELOPMENT	APPROVED DATE 8/30/11
PROJECT MANAGER : KRISTIN HIGGINS	
PROJECT NAME : SPRINGFIELD	
PROJECT NUMBER : BRO 1442 (26)	
SHEET 1 OF 52 SHEETS	