
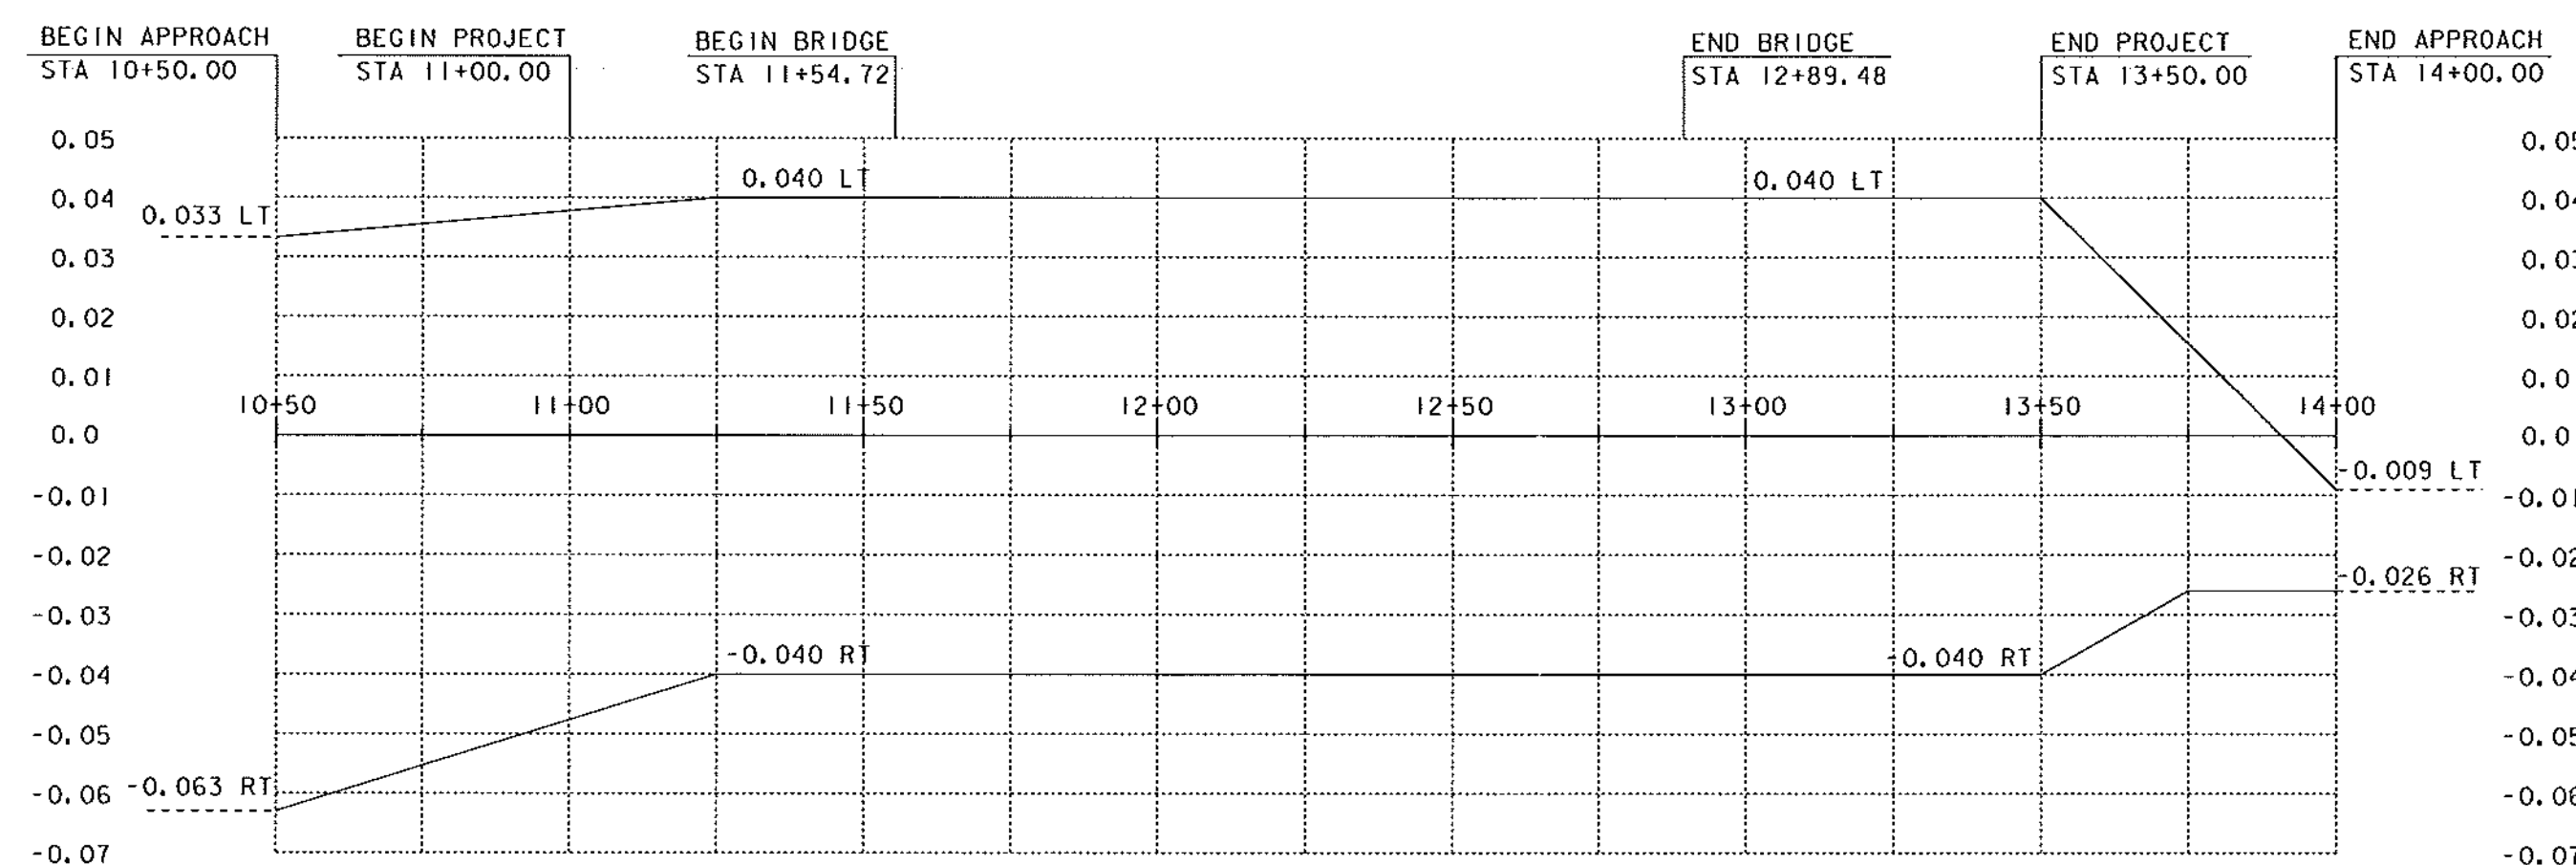


MAINLINE PROFILE Δ
 HOR. SCALE 1" = 20'-0"
 VER. SCALE 1" = 10'-0"

THE GRADES SHOWN TO THE NEAREST TENTH ARE THE ORIGINAL GROUND ELEVATIONS ALONG THE PROPOSED ALIGNMENT.
 THE GRADES SHOWN TO THE NEAREST HUNDREDTH ARE THE FINISH GRADES ALONG THE PROPOSED ALIGNMENT.

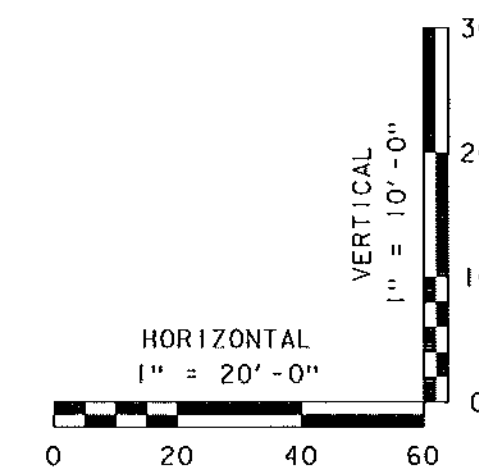

BANKING DIAGRAM
 HOR. SCALE 1" = 20'-0"
 NO VERT. SCALE

Δ REVISED 9-18-2012

- INCREASE ELEVATION 2" AT MID SPAN WITH A VERTICAL CURVE MATCHING THE EXISTING TANGENTS BETWEEN BEGIN / END BRIDGE.

PROJECT NAME: SPRINGFIELD	PLOT DATE: 18-SEP-2012
PROJECT NUMBER: BRO 1442(26)	DRAWN BY: J. SALVATORI
FILE NAME: s951292pro.dgn	CHECKED BY: J. LACROIX
PROJECT LEADER: K. HIGGINS	SHEET 1 OF 1
DESIGNED BY: J. SALVATORI	
MAINLINE PROFILE	