


PLAN

SCALE 1" = 10'-0"
 10 0 10

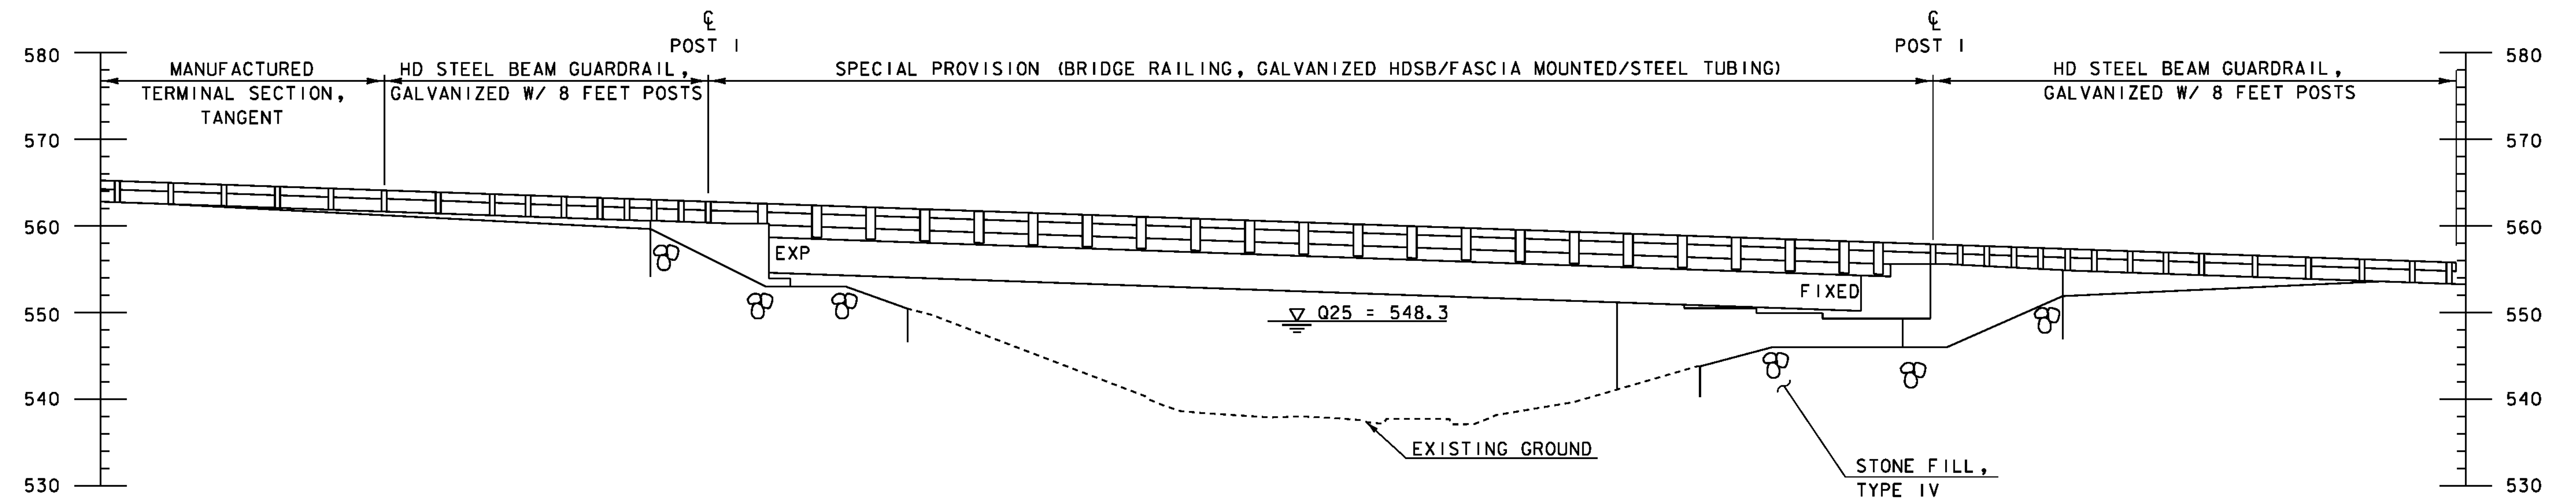

ELEVATION

SCALE 1" = 10'-0"
 10 0 10

NOTE:
 SEE BRIDGE AND APPROACH RAILING
 LAYOUT FOR RAIL DETAILS

PROJECT NAME: SPRINGFIELD	PLOT DATE: 30-AUG-2011
PROJECT NUMBER: BRO 1442(26)	DRAWN BY: R. PELLET
FILE NAME: s95j282pe.dgn	CHECKED BY: J. SALVATORI
PROJECT LEADER: K. HIGGINS	SHEET 18 OF 52
DESIGNED BY: J. LACROIX	PLAN AND ELEVATION SHEET