



ABUTMENT 2 PLAN
SCALE 1/4" = 1'-0"

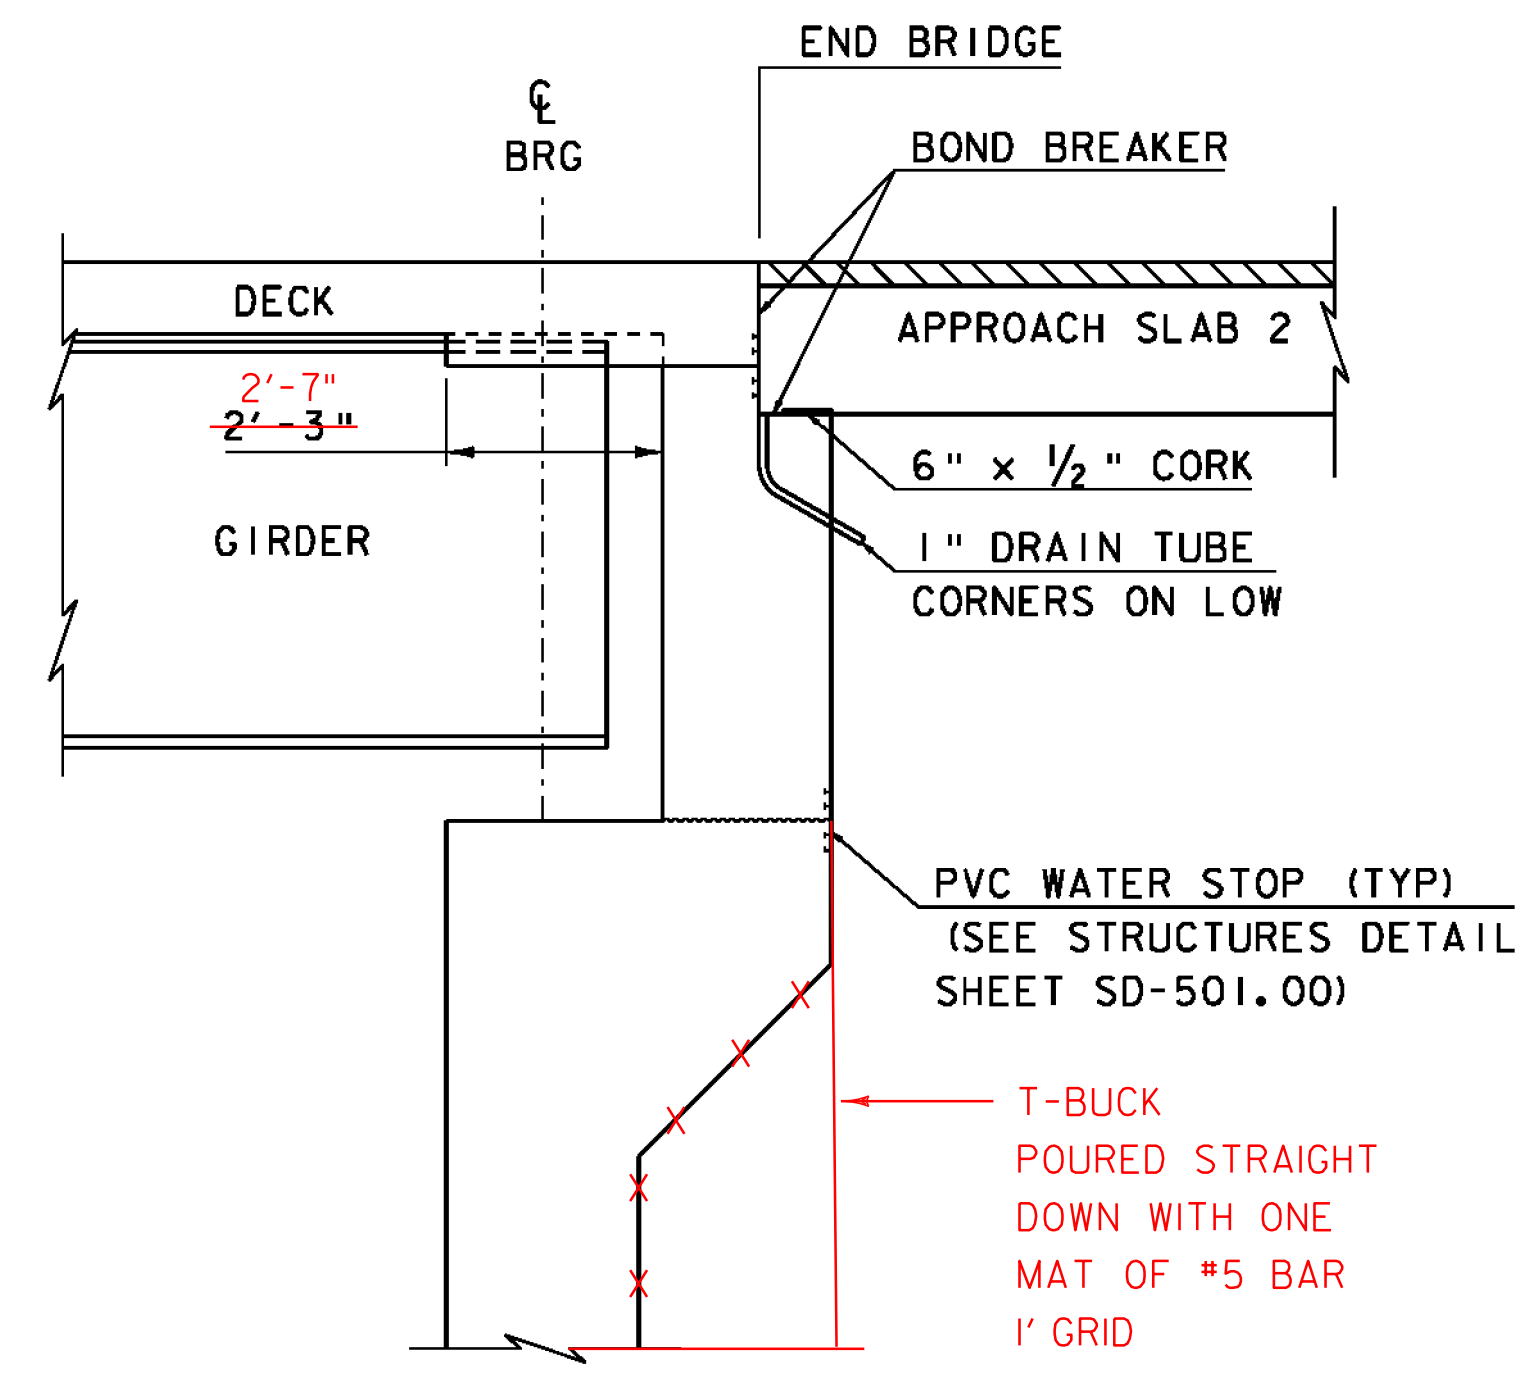

ABUTMENT 2 BRIDGE END
SCALE 1/2" = 1'-0"
(FIXED)

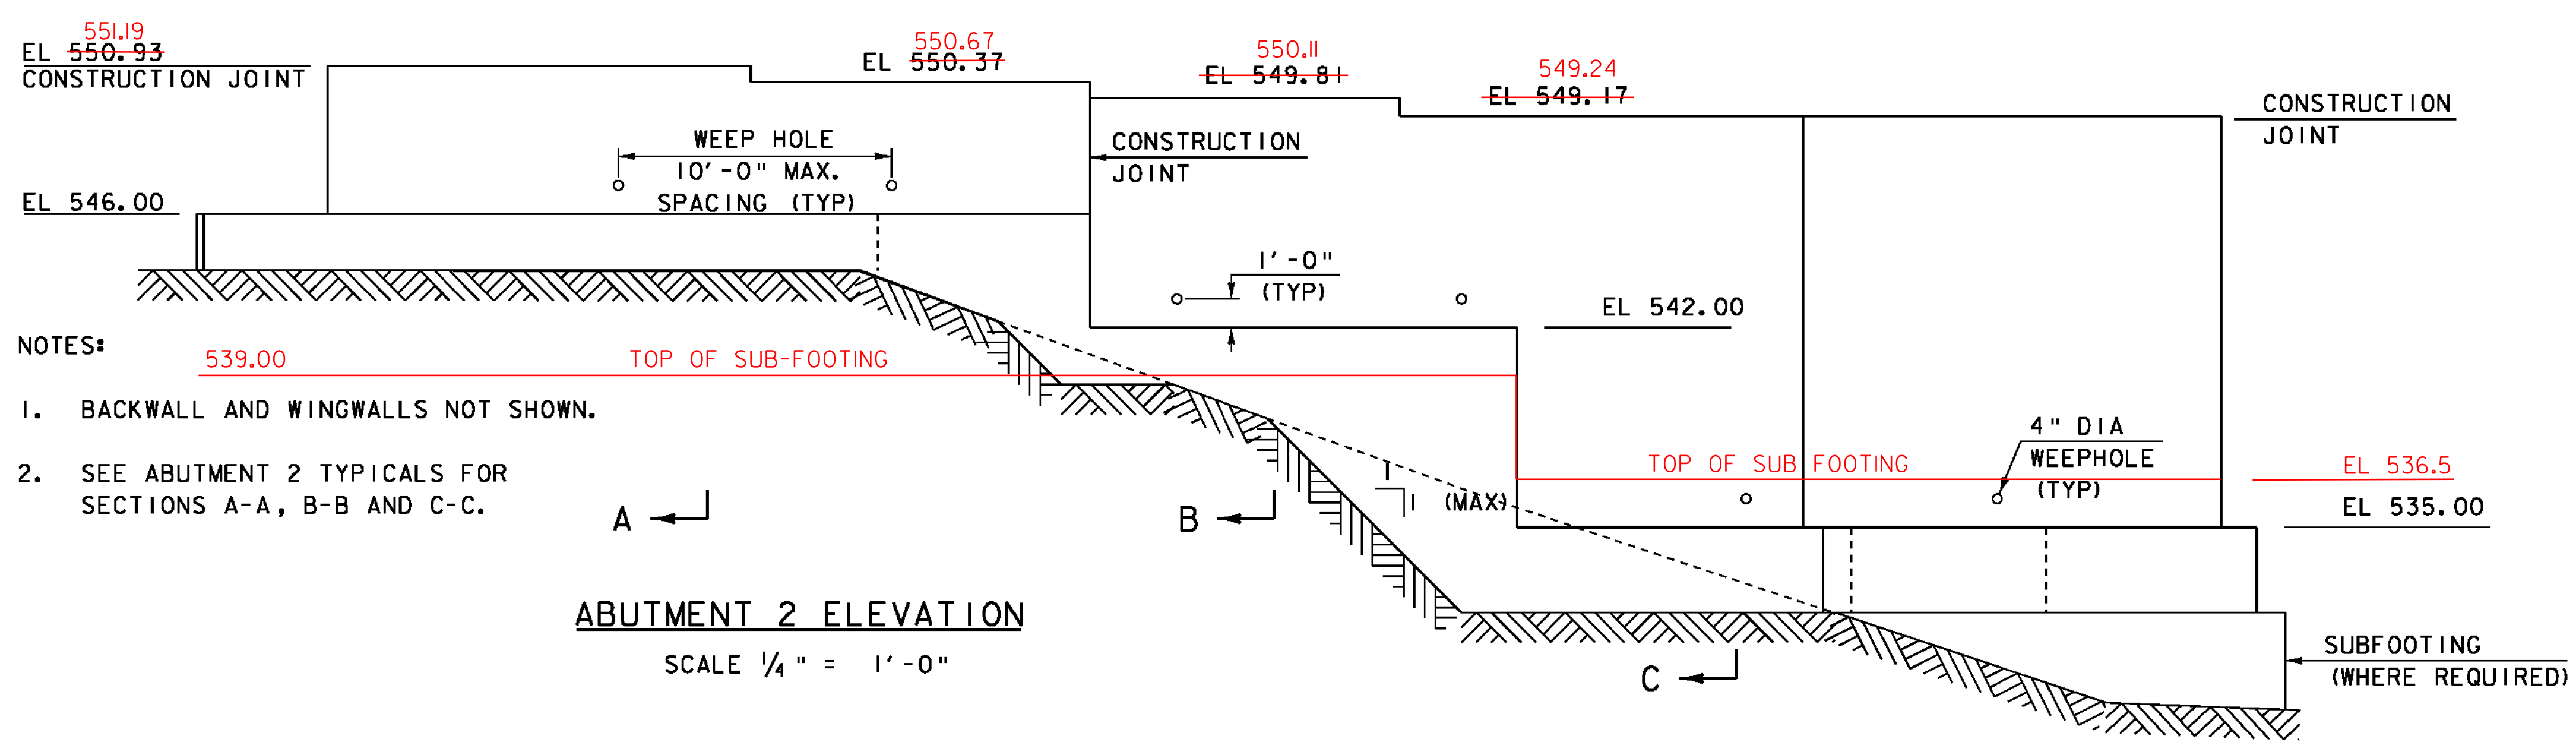

ABUTMENT 2 ELEVATION
SCALE 1/4" = 1'-0"

- NOTES:
- BACKWALL AND WINGWALLS NOT SHOWN.
 - SEE ABUTMENT 2 TYPICALS FOR SECTIONS A-A, B-B AND C-C.

PROJECT NAME:	SPRINGFIELD	PLOT DATE:	30-AUG-2011
PROJECT NUMBER:	BRO 1442(26)	DRAWN BY:	R. PELLETT
FILE NAME:	s95j282sub.dgn	DESIGNED BY:	J. GRIFFIN
ABUTMENT 2		CHECKED BY:	J. LACROIX
		SHEET	29 OF 52