




WINGWALL 4 TYPICAL
SCALE 1/2" = 1'-0"

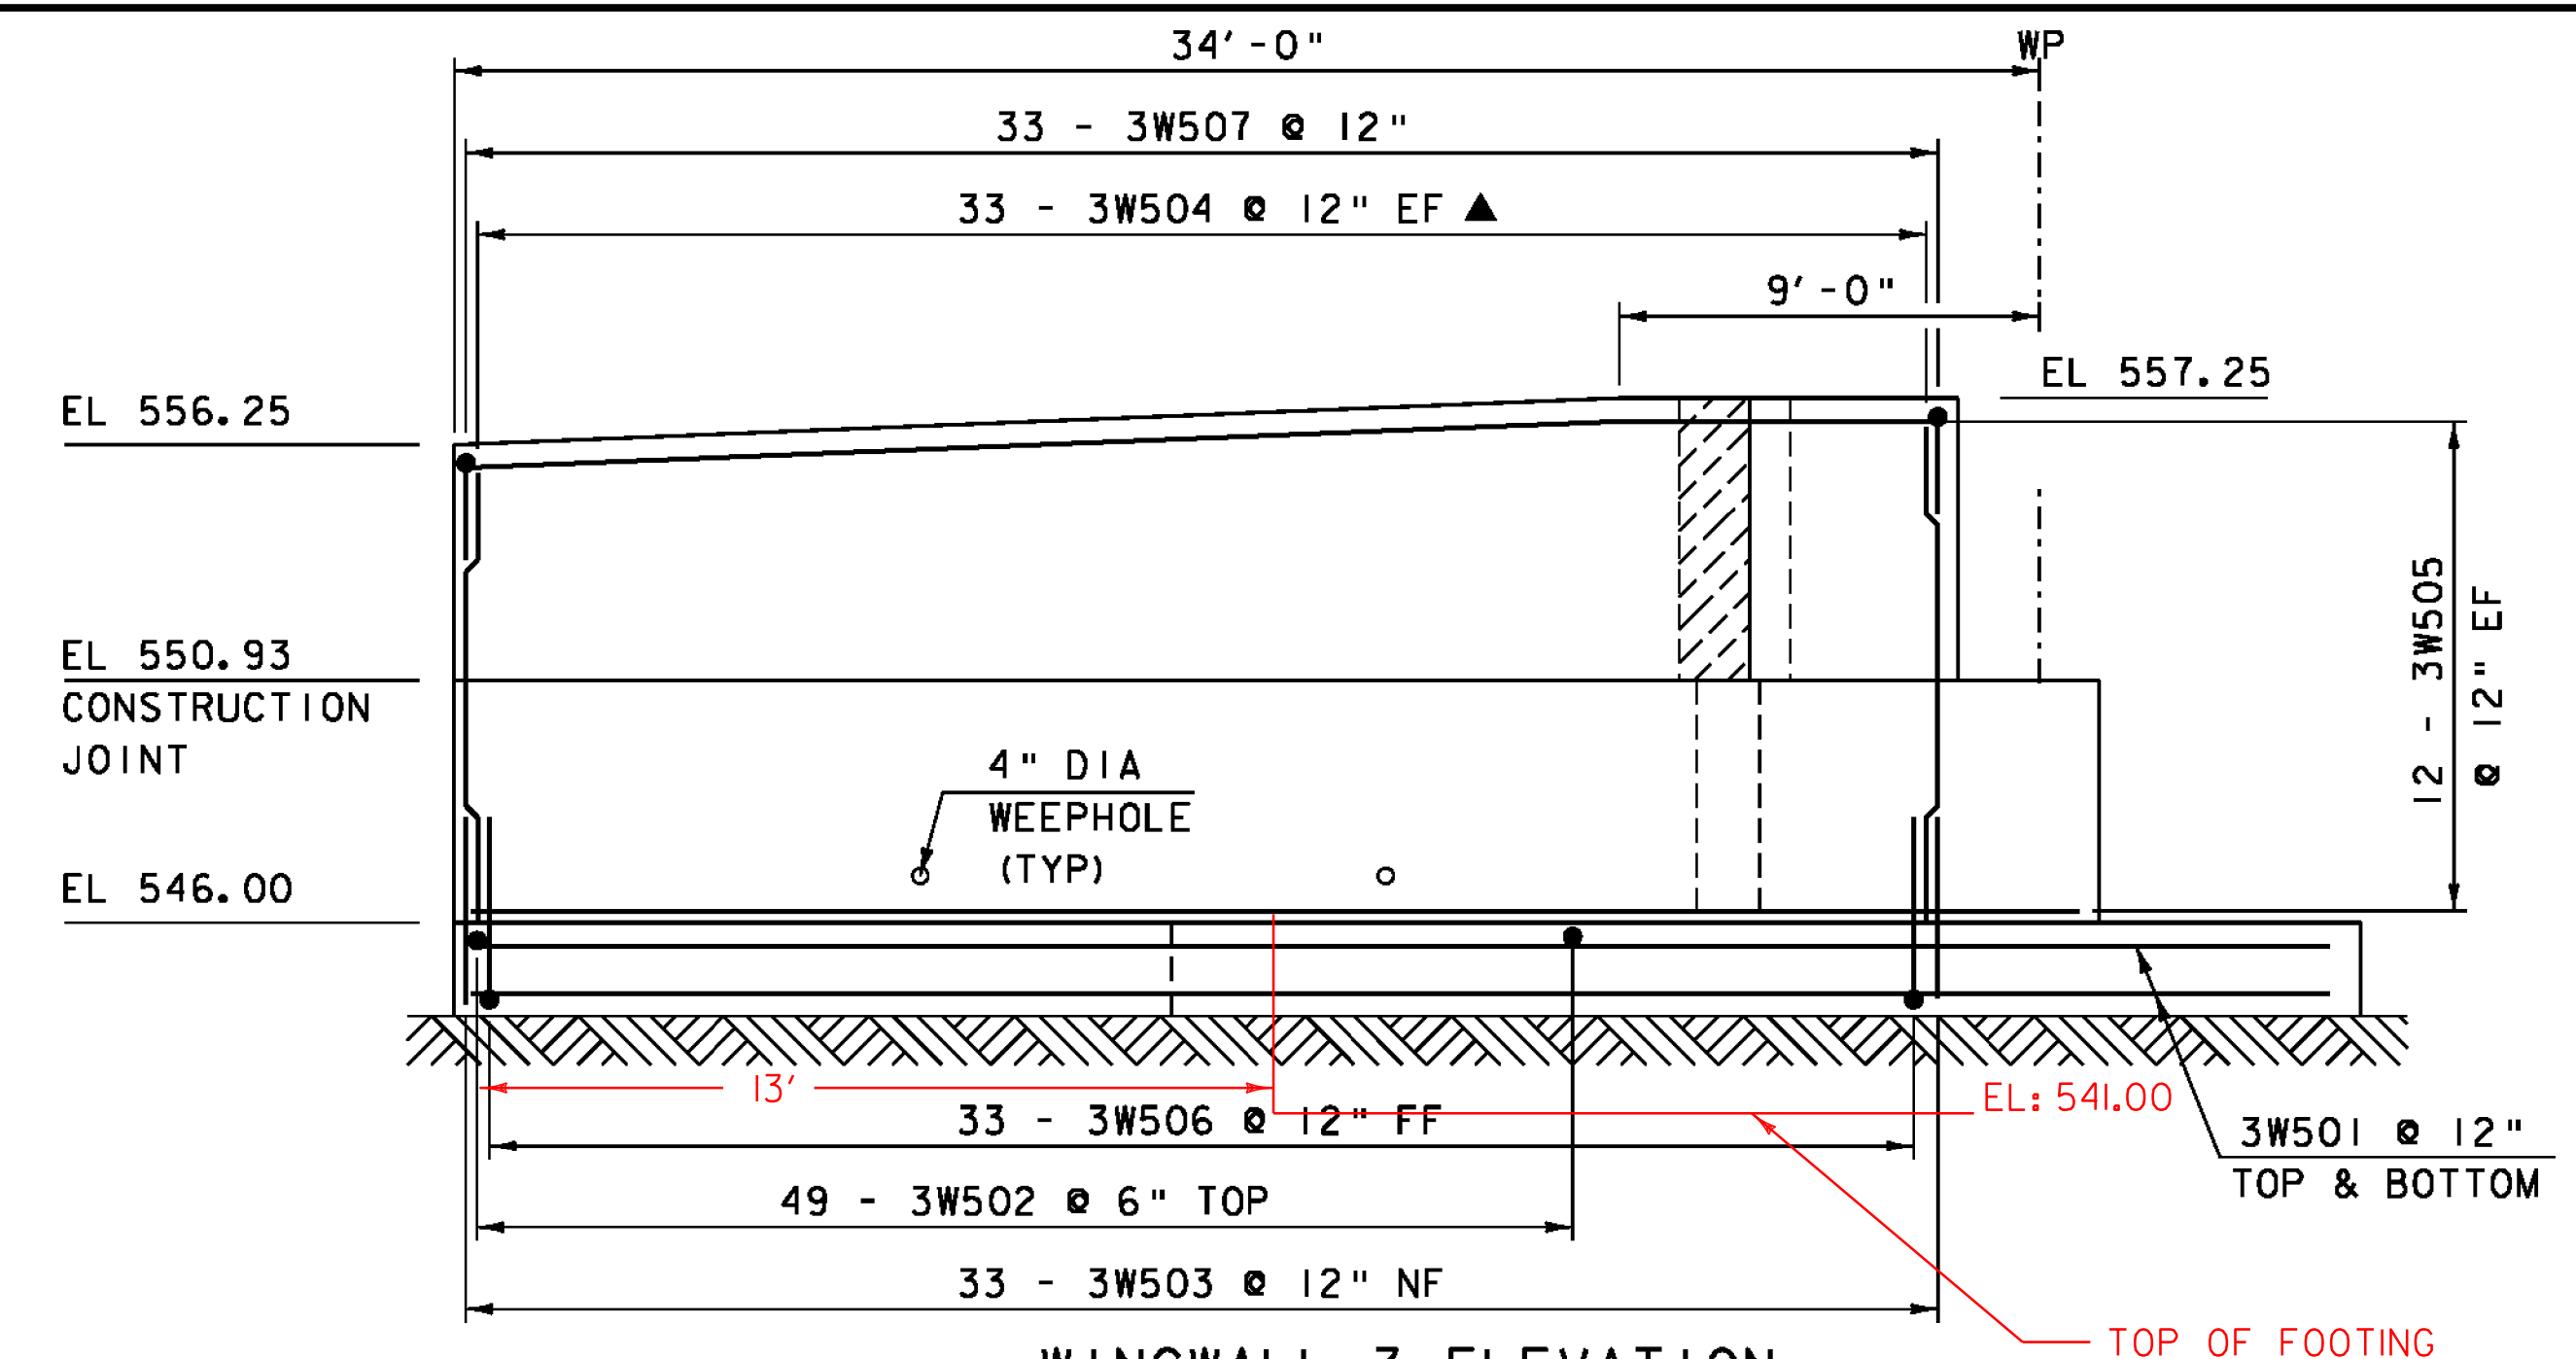

WINGWALL 3 ELEVATION
SCALE 1/4" = 1'-0"

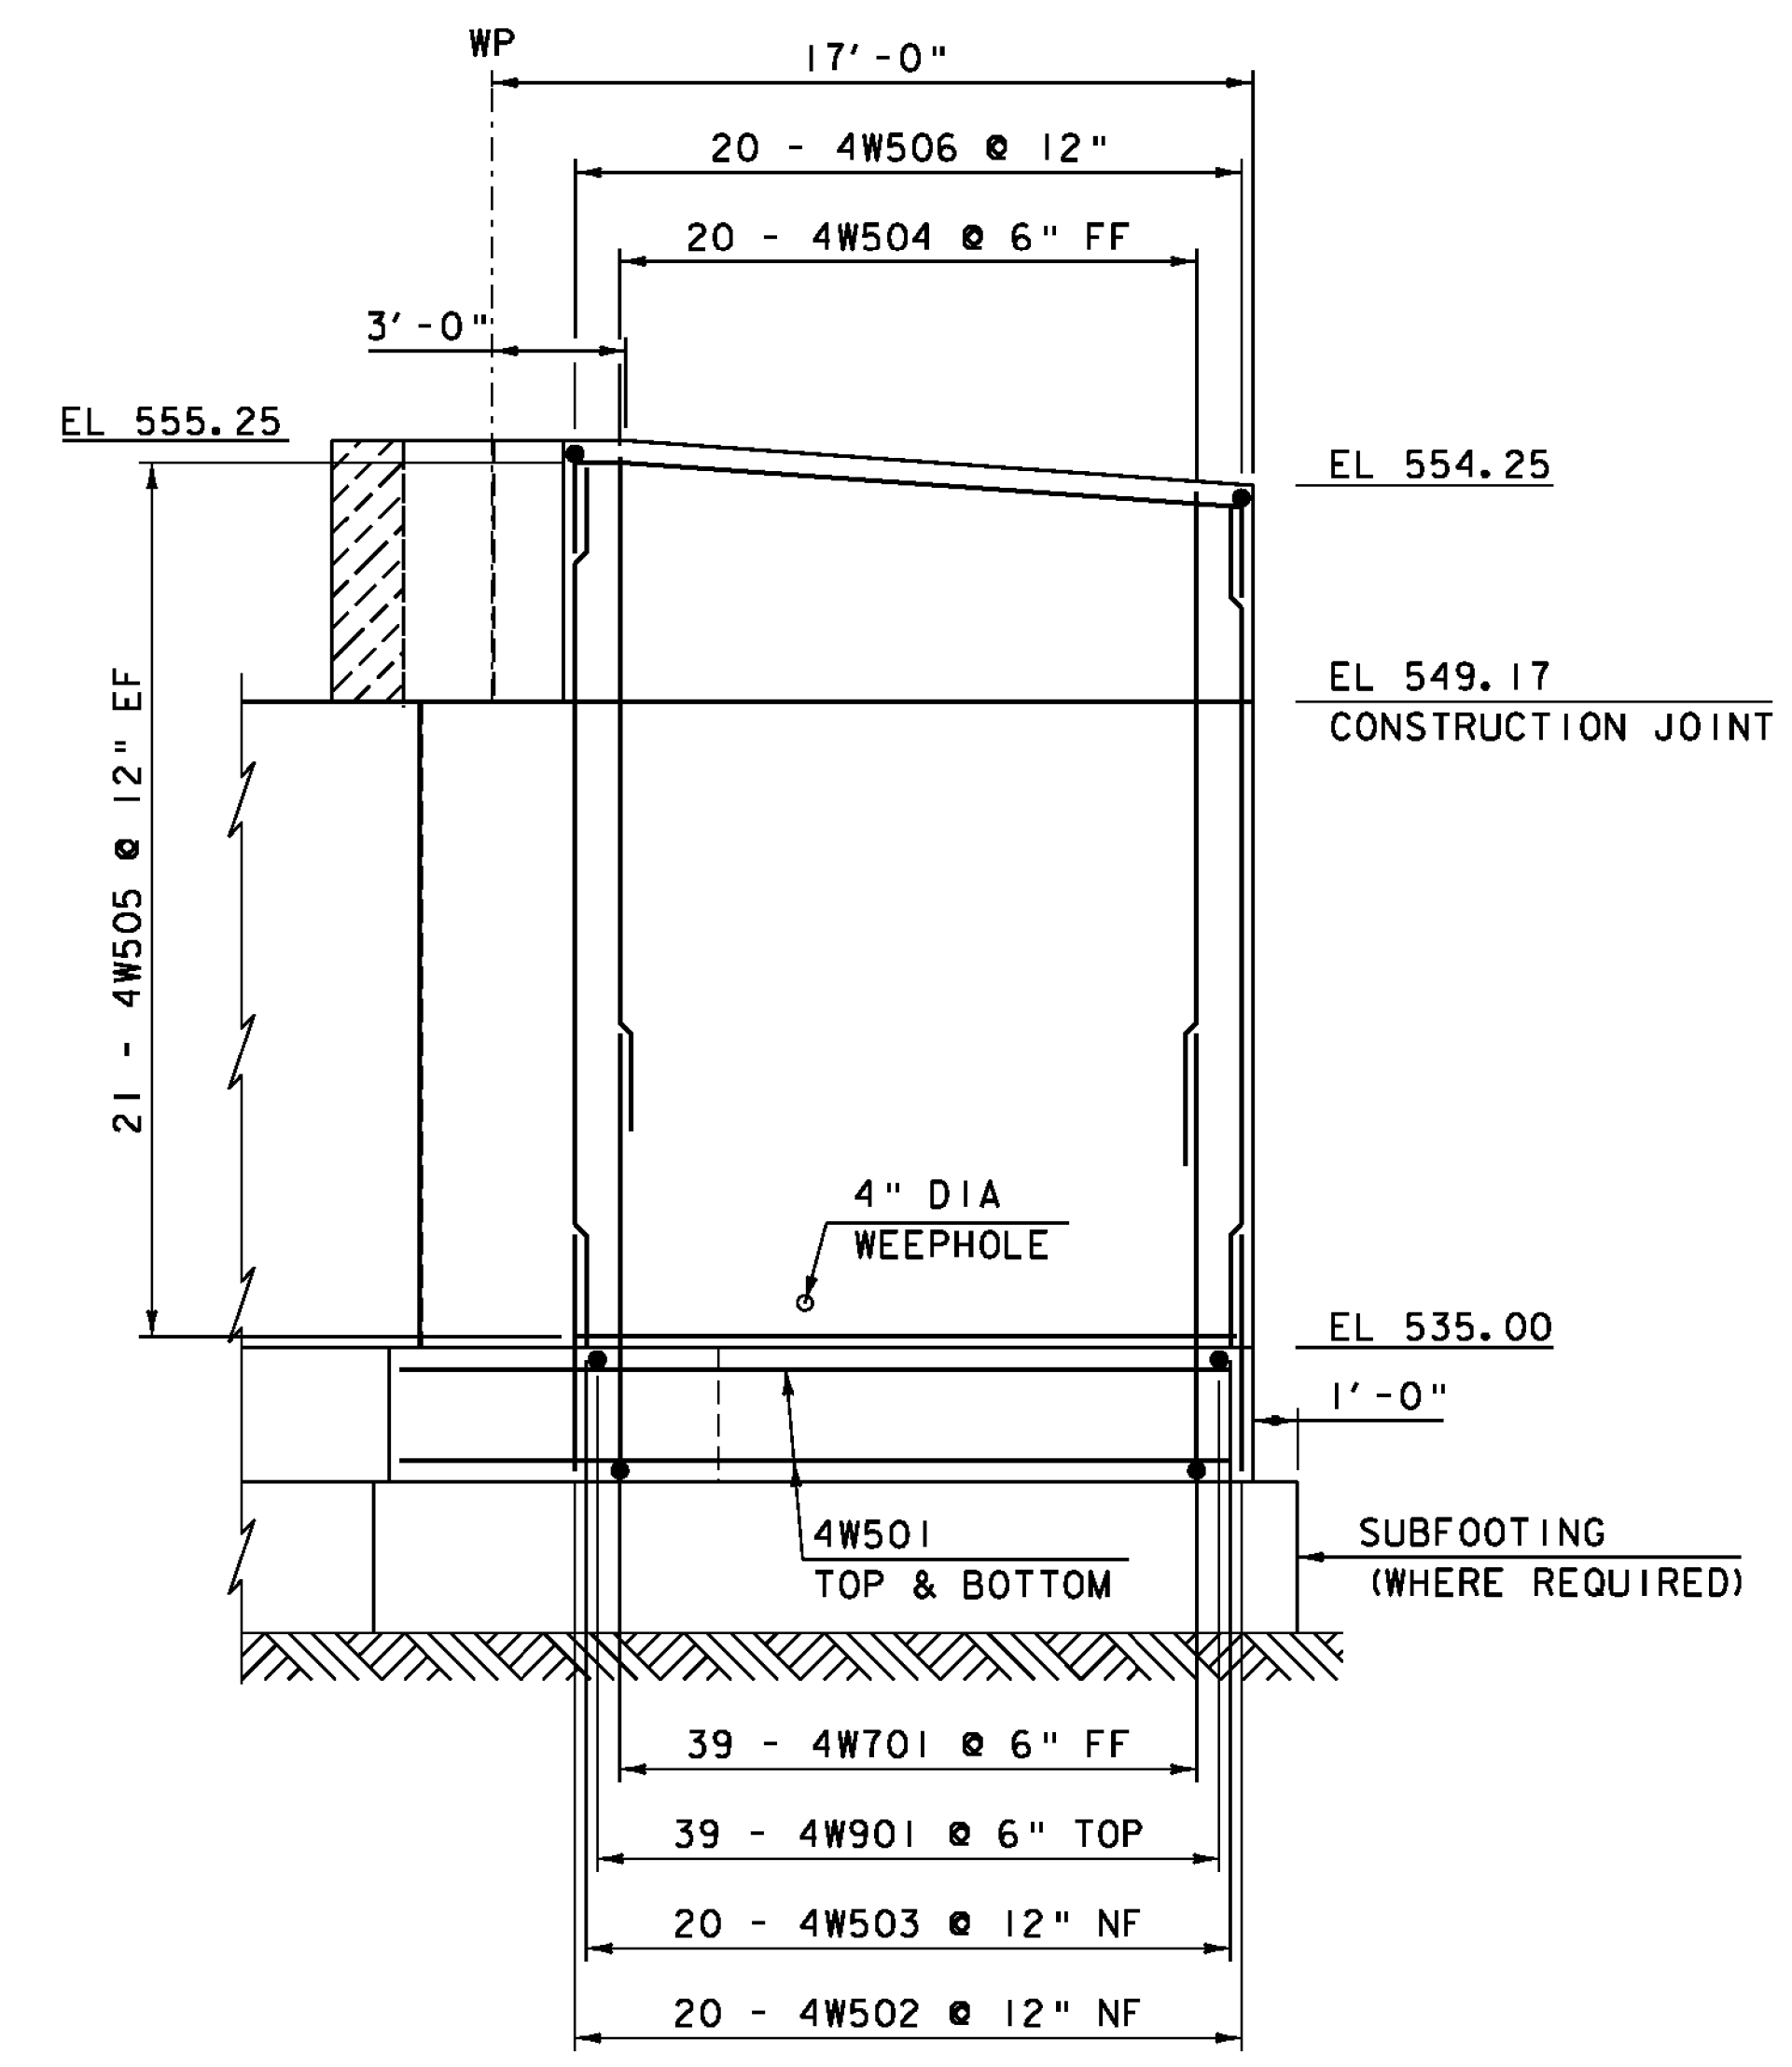

WINGWALL 4 ELEVATION
SCALE 1/4" = 1'-0"

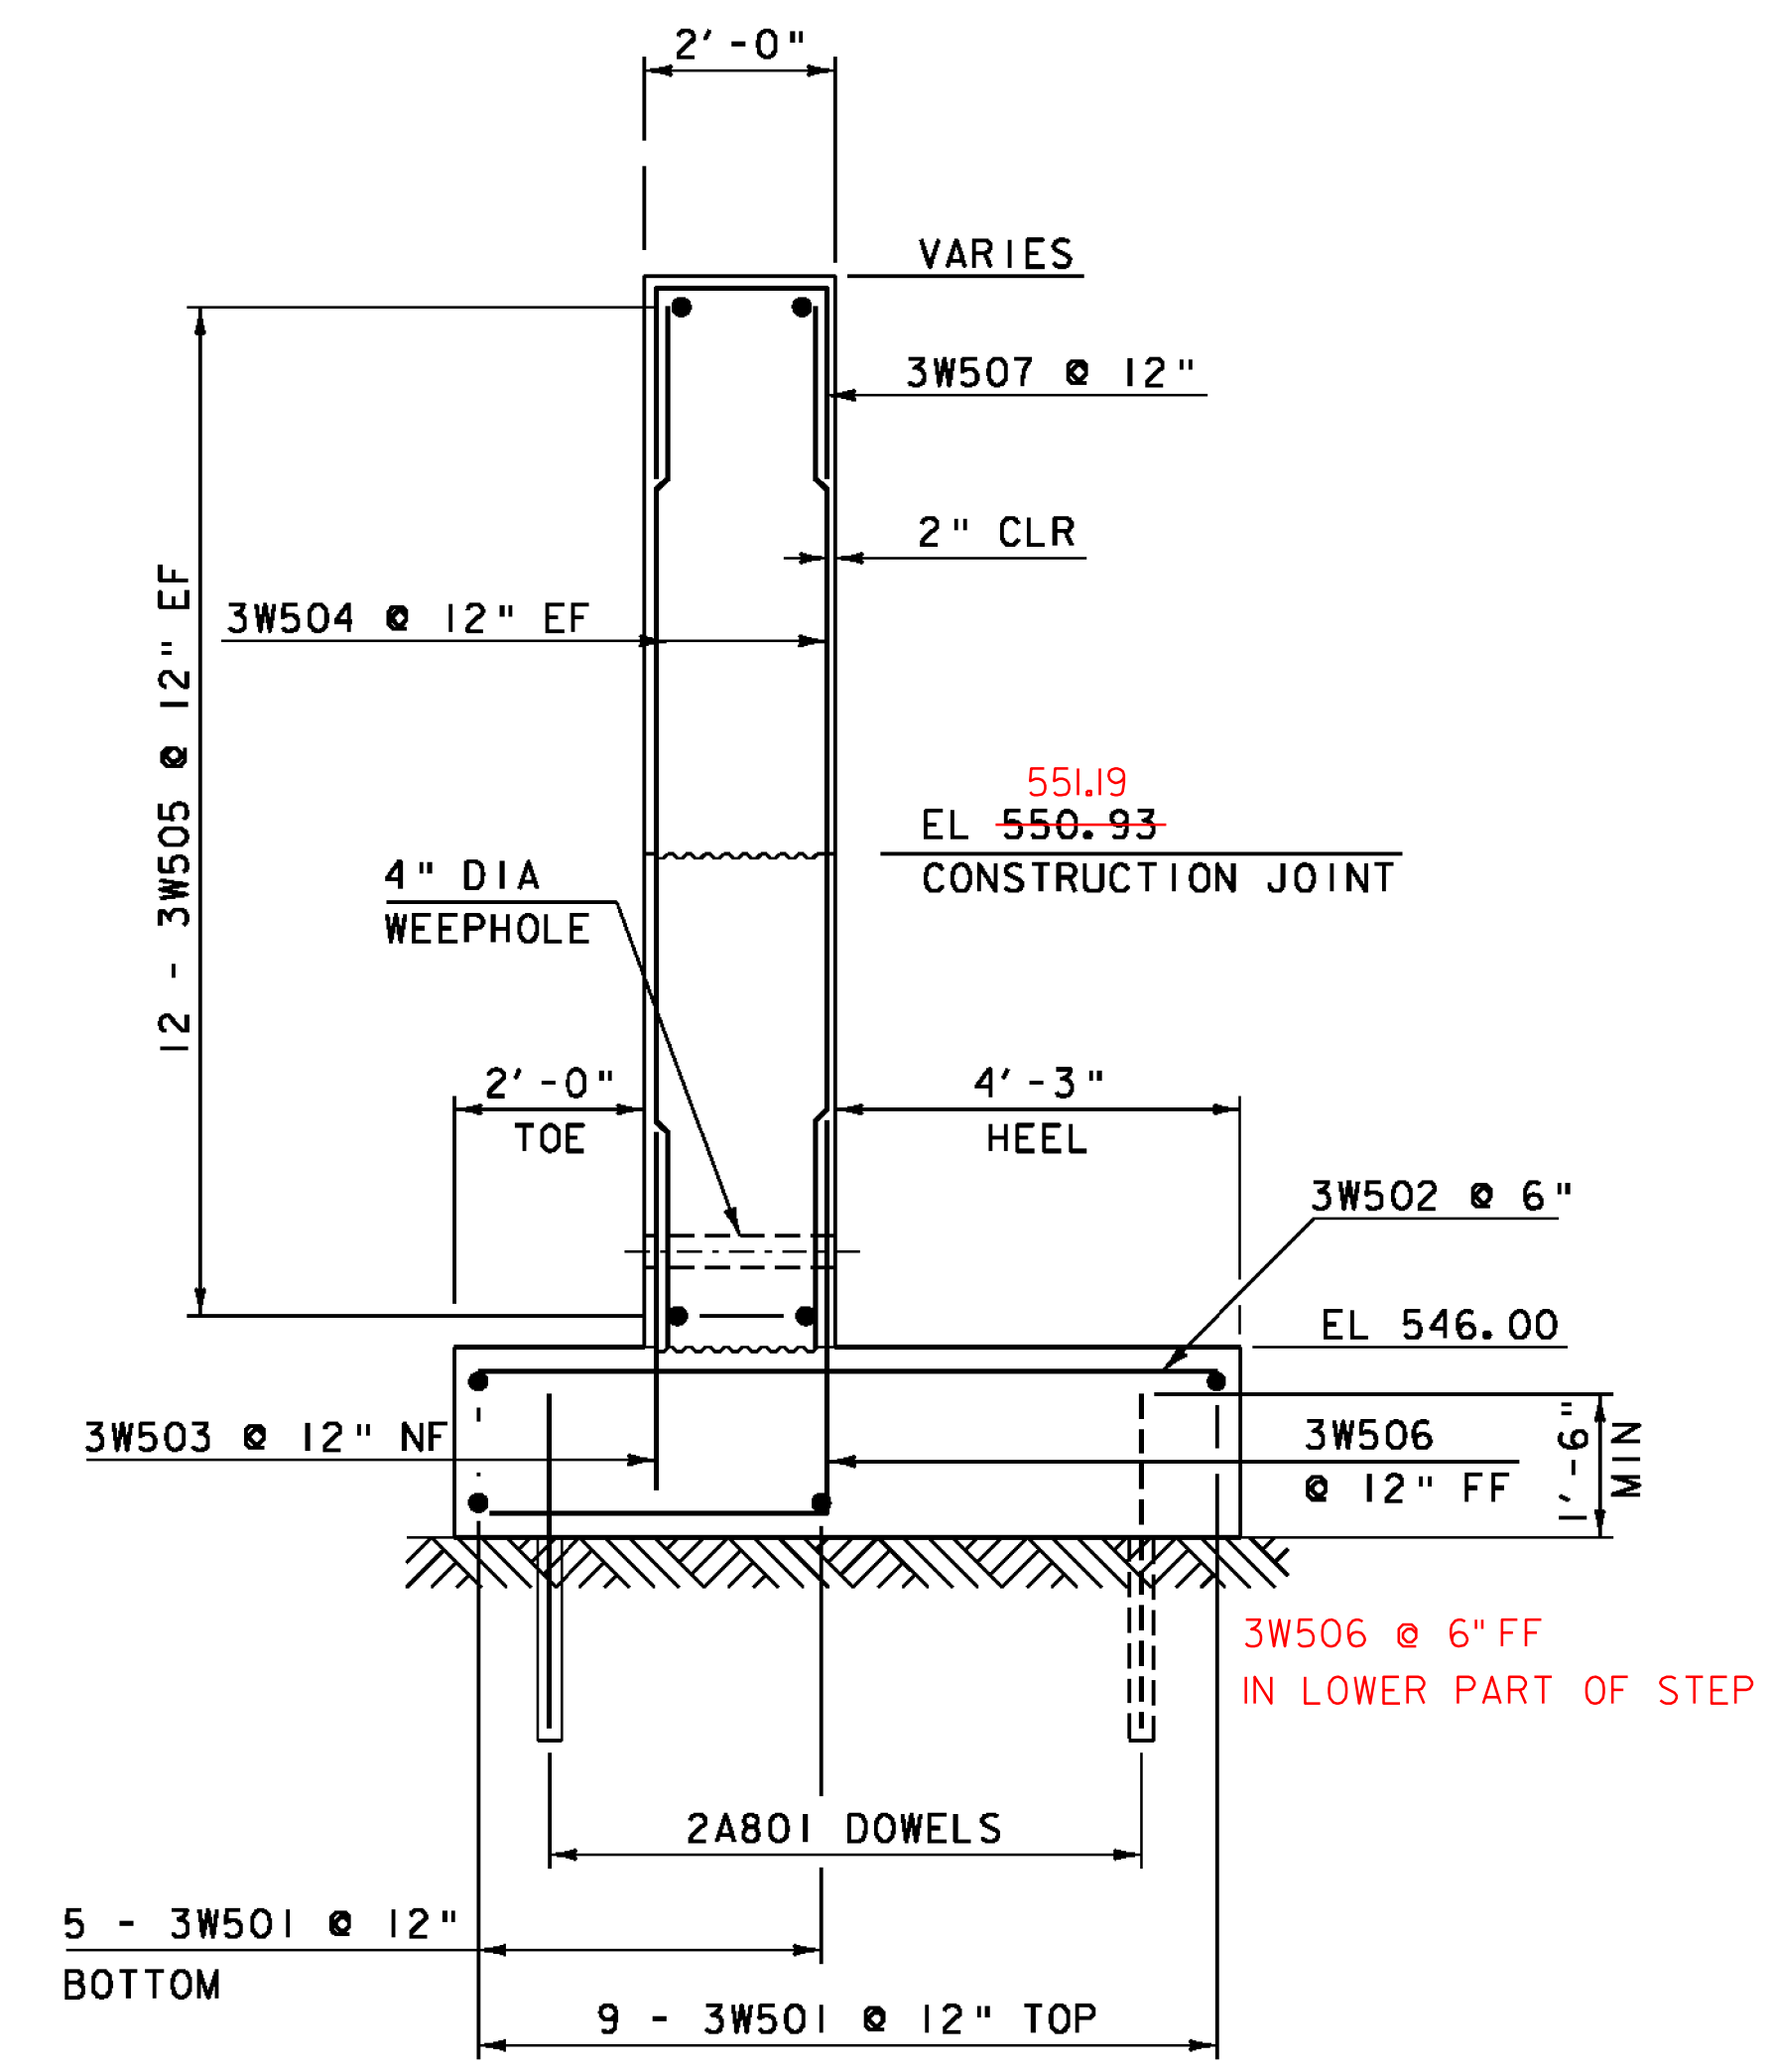

WINGWALL 3 TYPICAL
SCALE 1/2" = 1'-0"

NOTE:
 NF = NEAR FACE
 FF = FAR FACE
 EF = EACH FACE
 ▲ = CUT TO FIT IN FIELD
 3" CLEAR, UNLESS OTHERWISE SPECIFIED ON THE PLANS.
 2'-2" BAR LAP UNLESS OTHERWISE SPECIFIED ON THE PLANS.

PROJECT NAME:	SPRINGFIELD	PLOT DATE:	30-AUG-2011
PROJECT NUMBER:	BRO 1442(26)	DRAWN BY:	R. PELLETT
FILE NAME:	s95j282sub.dgn	DESIGNED BY:	J. GRIFFIN
		CHECKED BY:	J. LACROIX
		WINGWALL 3 & 4 DETAILS	SHEET 32 OF 52