




10+25

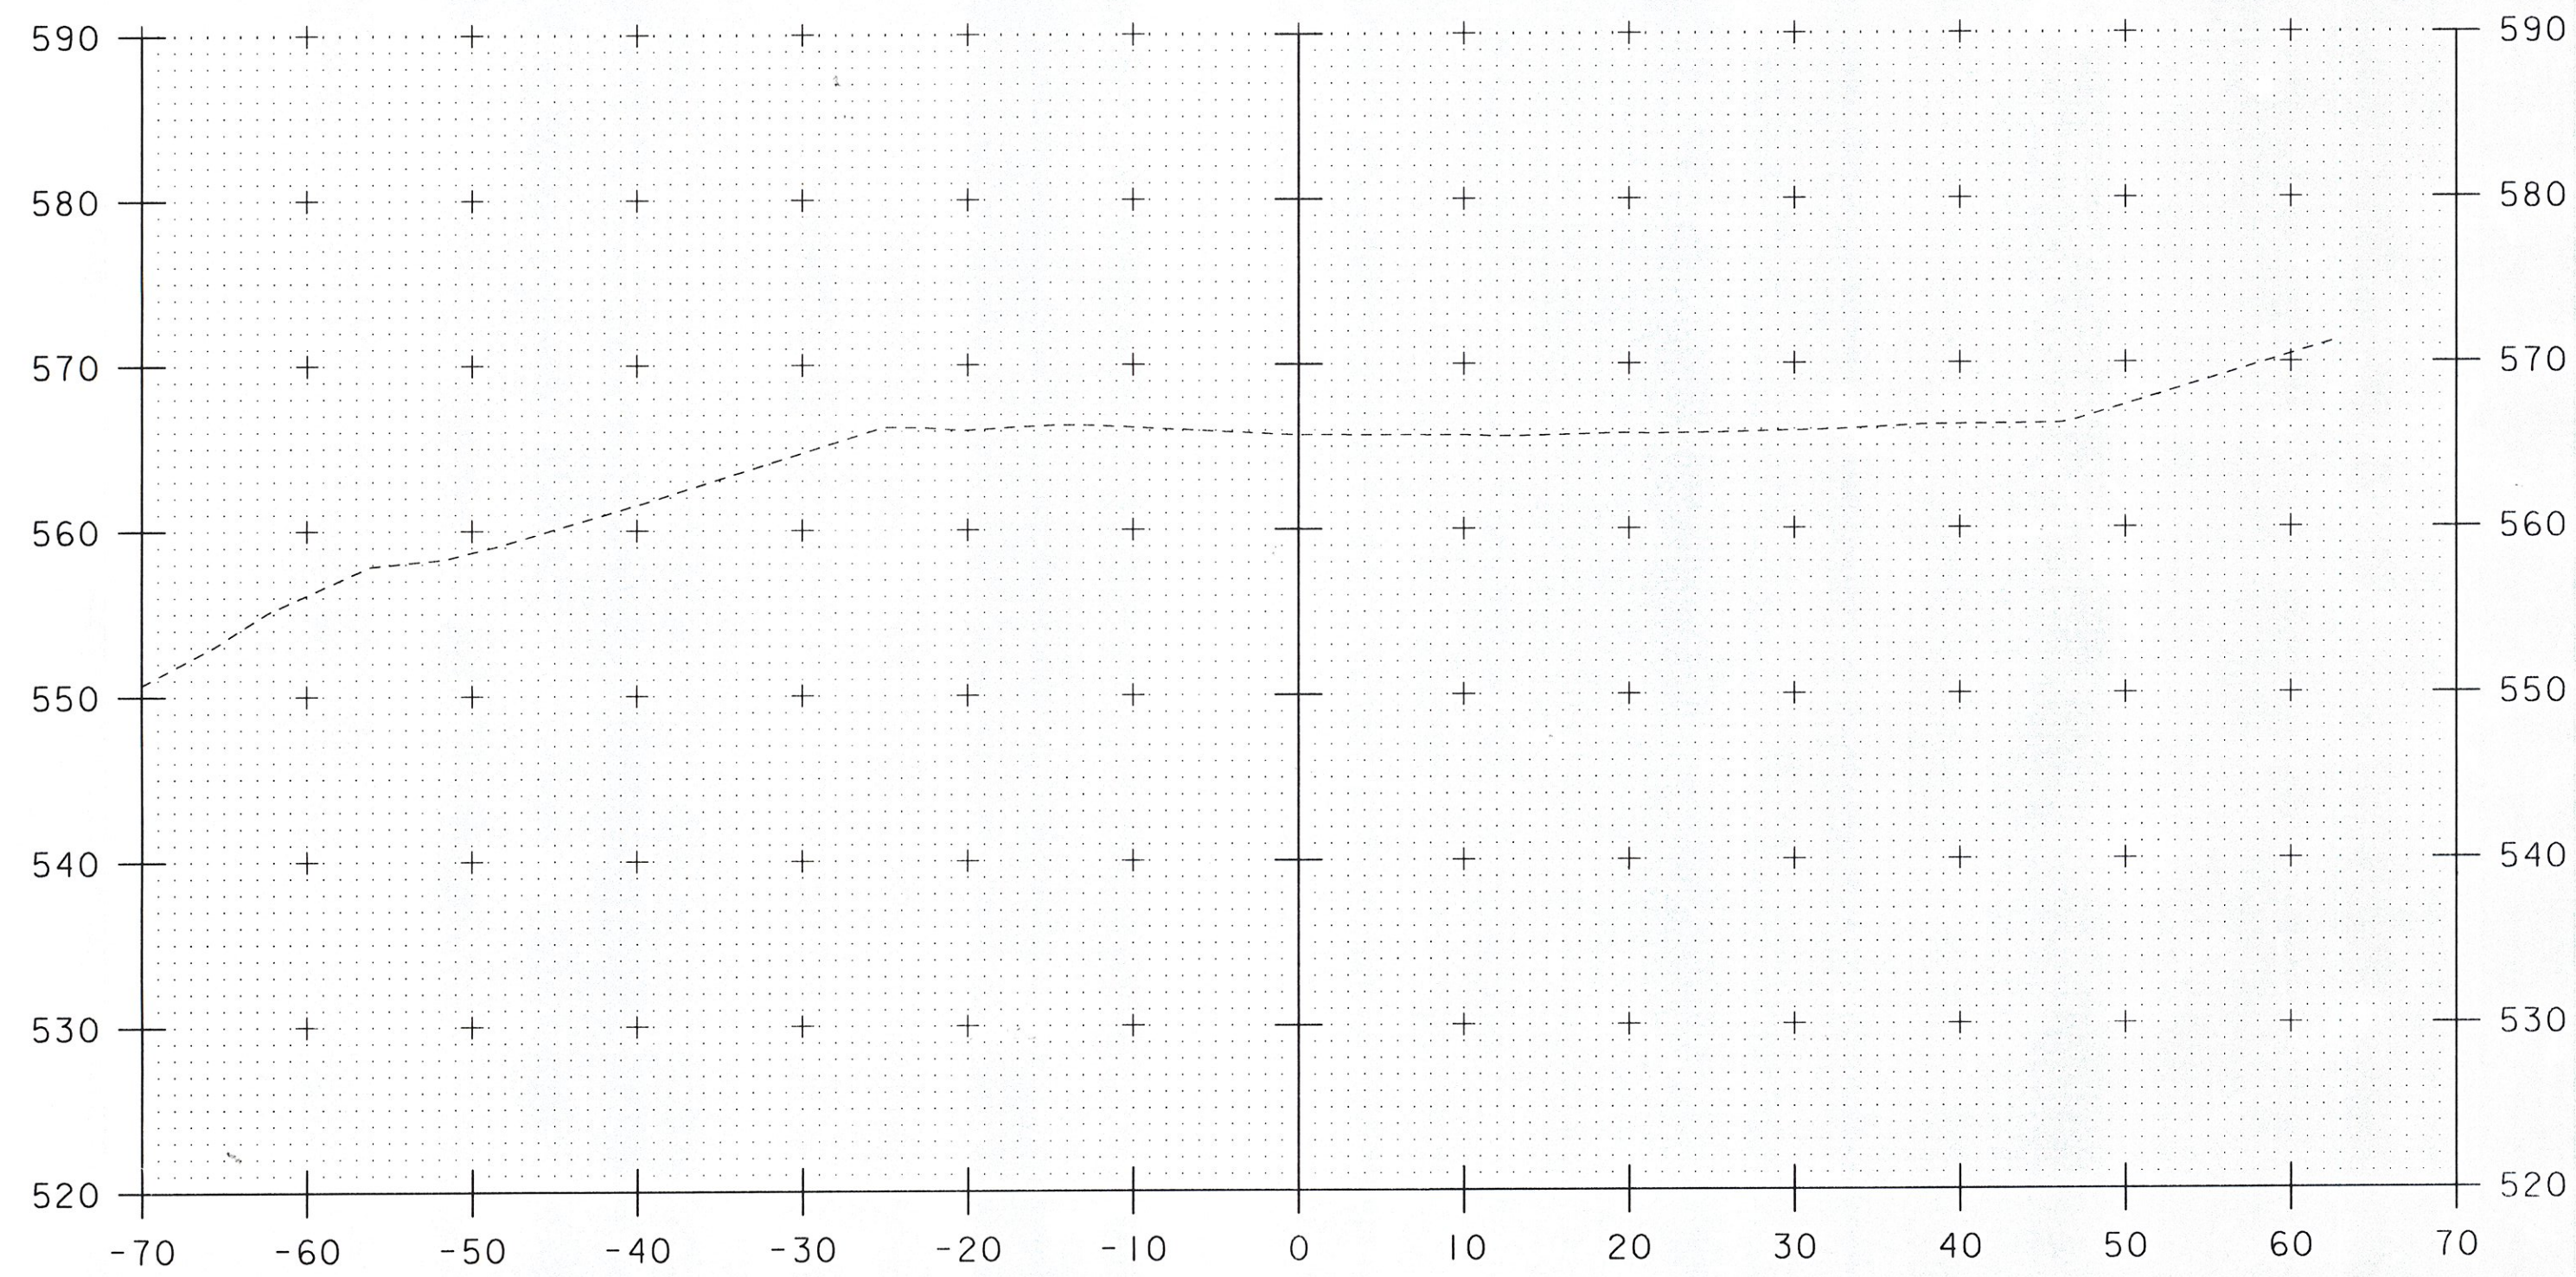

10+00

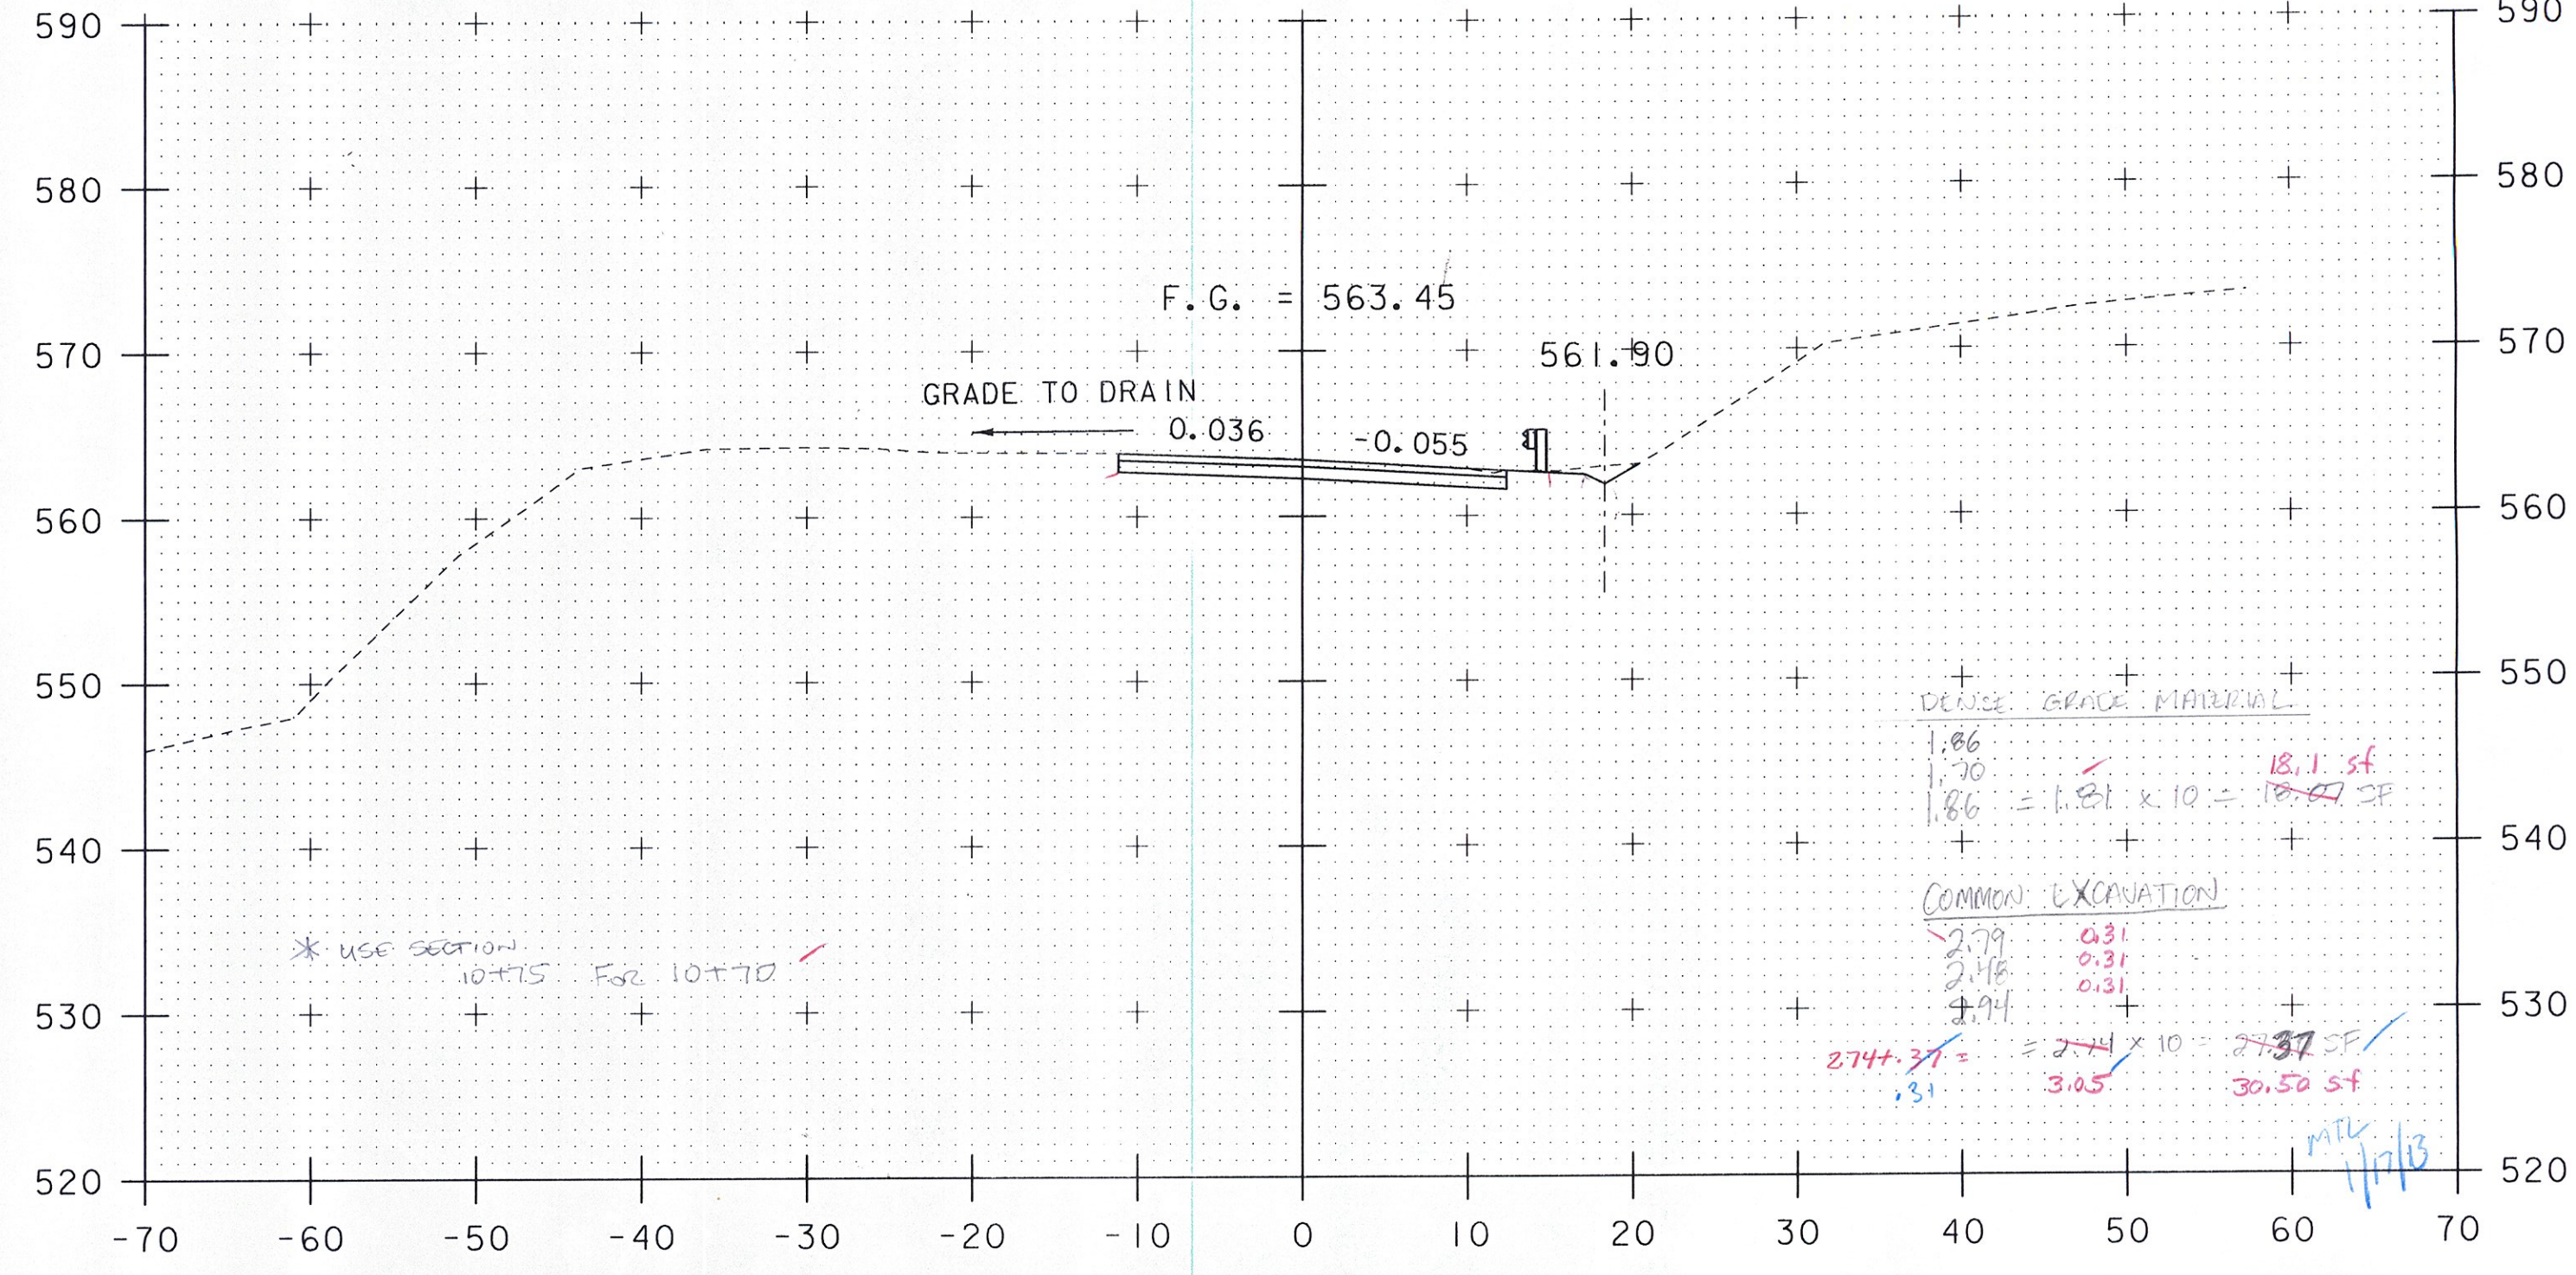

10+75

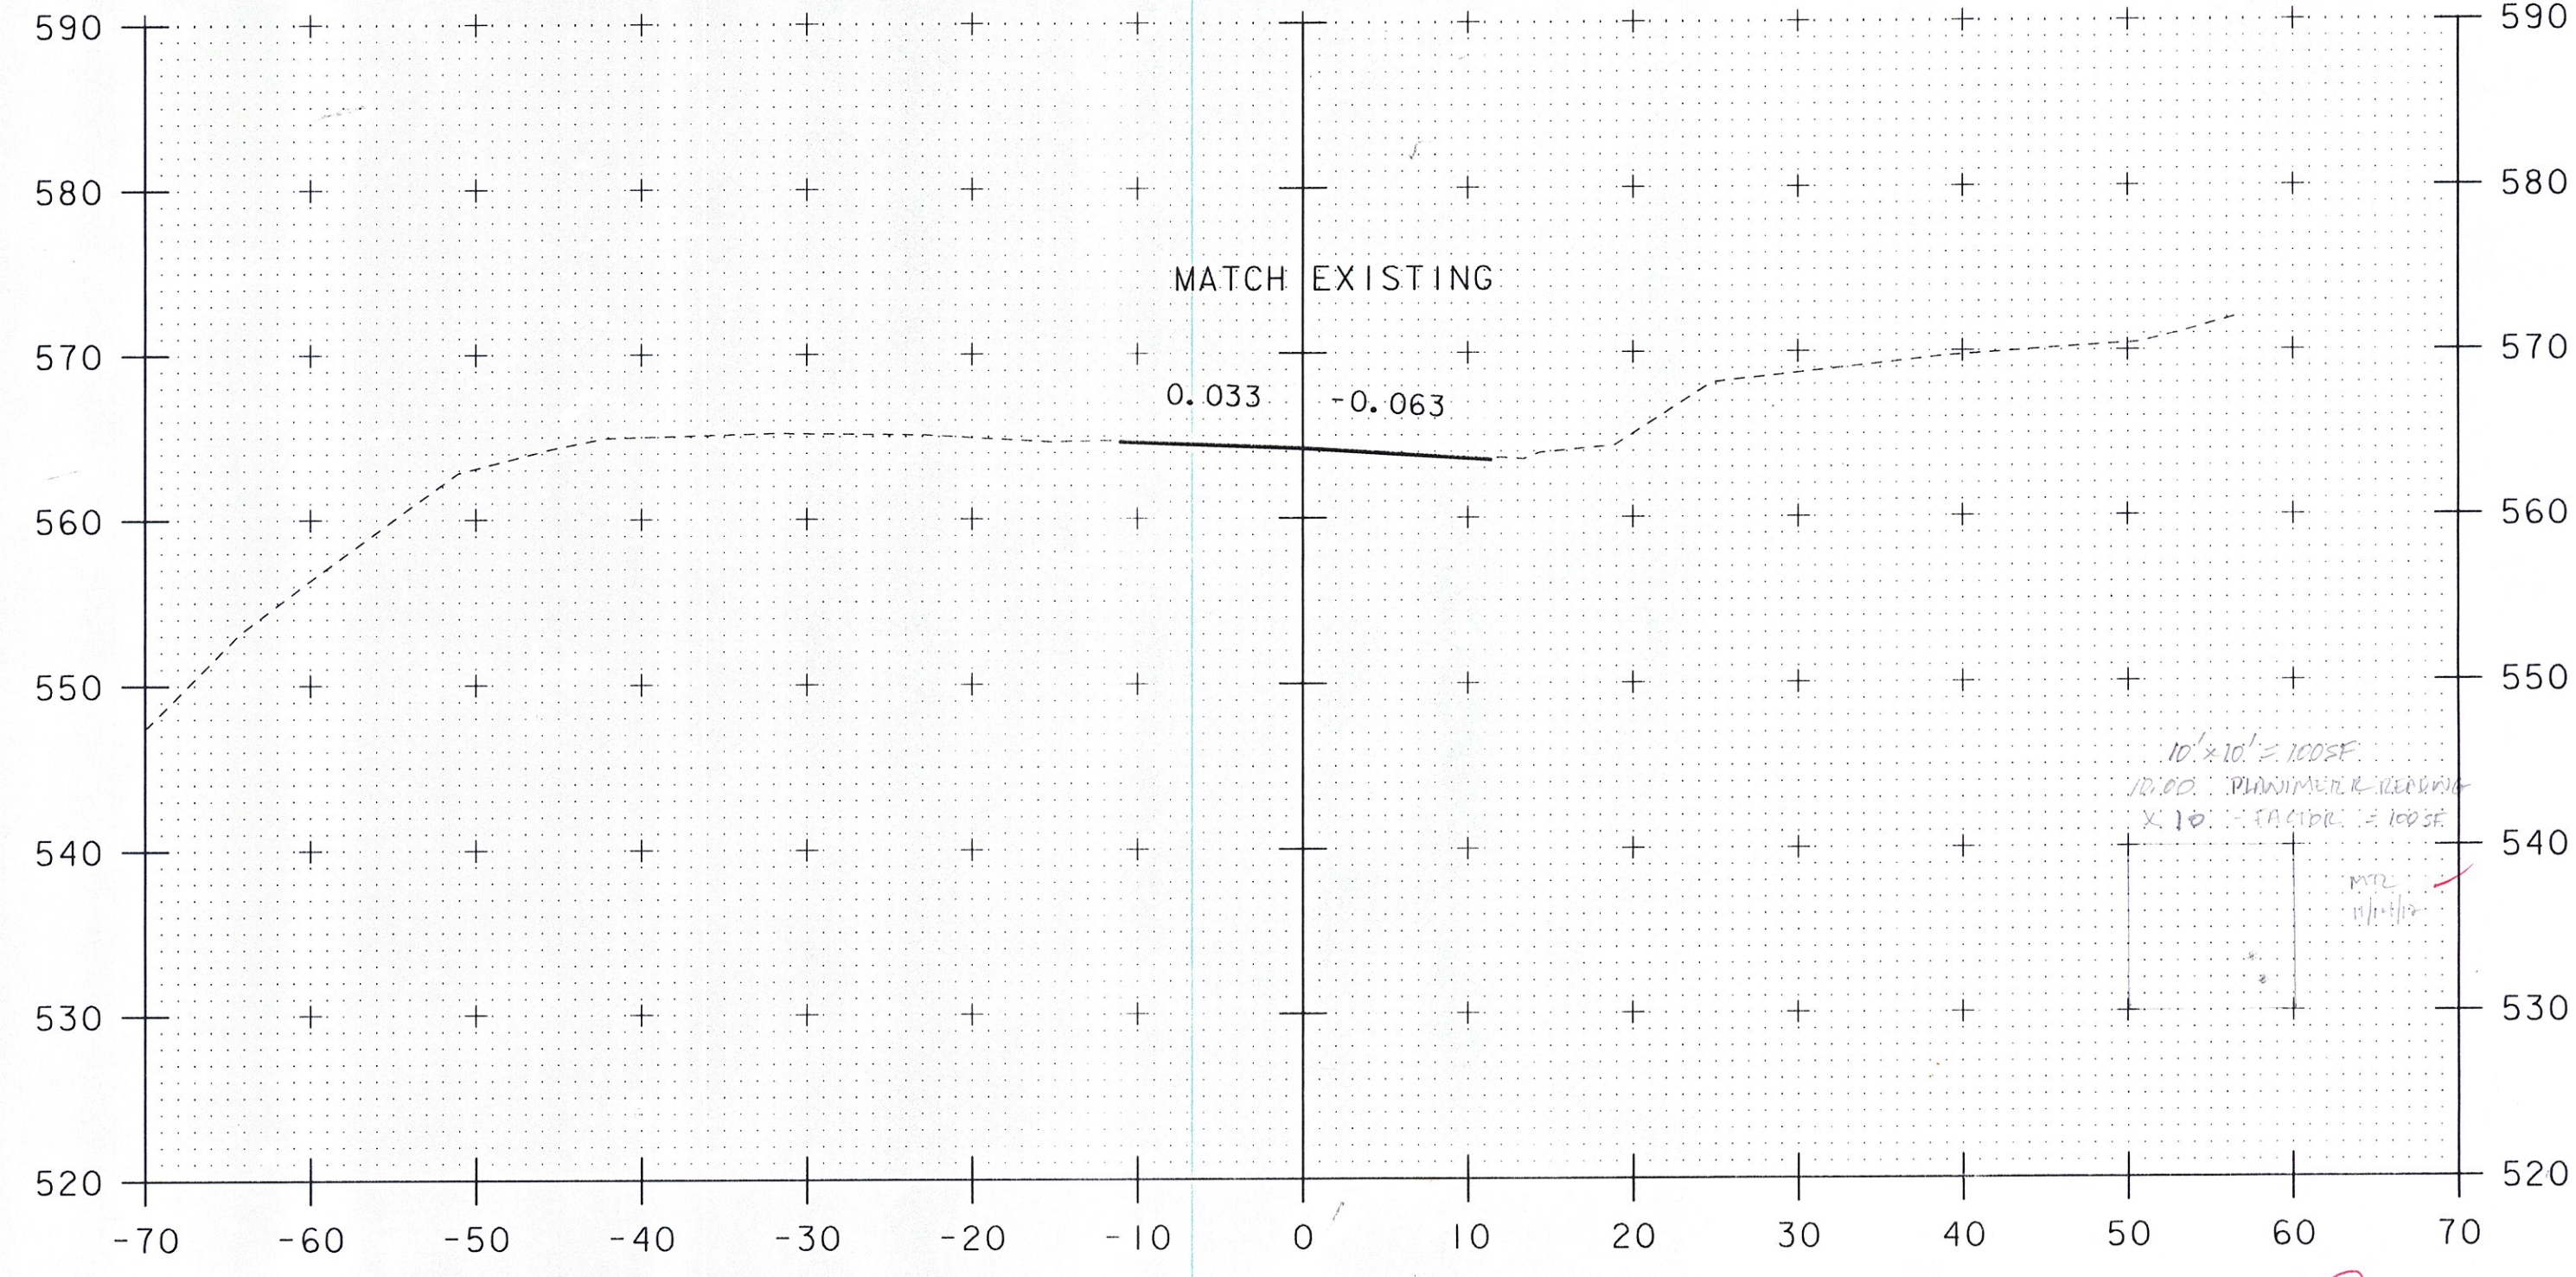

BEGIN APPROACH
10+50

SCALE 1" = 10'-0"

STA. 10+00 TO STA. 10+75

PROJECT NAME: SPRINGFIELD
PROJECT NUMBER: BRO_1442(26)

FILE NAME: s95j282xsl.dgn
PROJECT LEADER: K. HIGGINS
DESIGNED BY: J. SALVATORI
ROADWAY CROSS SECTIONS - I

PLOT DATE: 30-AUG-2011
DRAWN BY: J. SALVATORI
CHECKED BY: J. LACROIX
SHEET 44 OF 52

CSF
11/1/13