

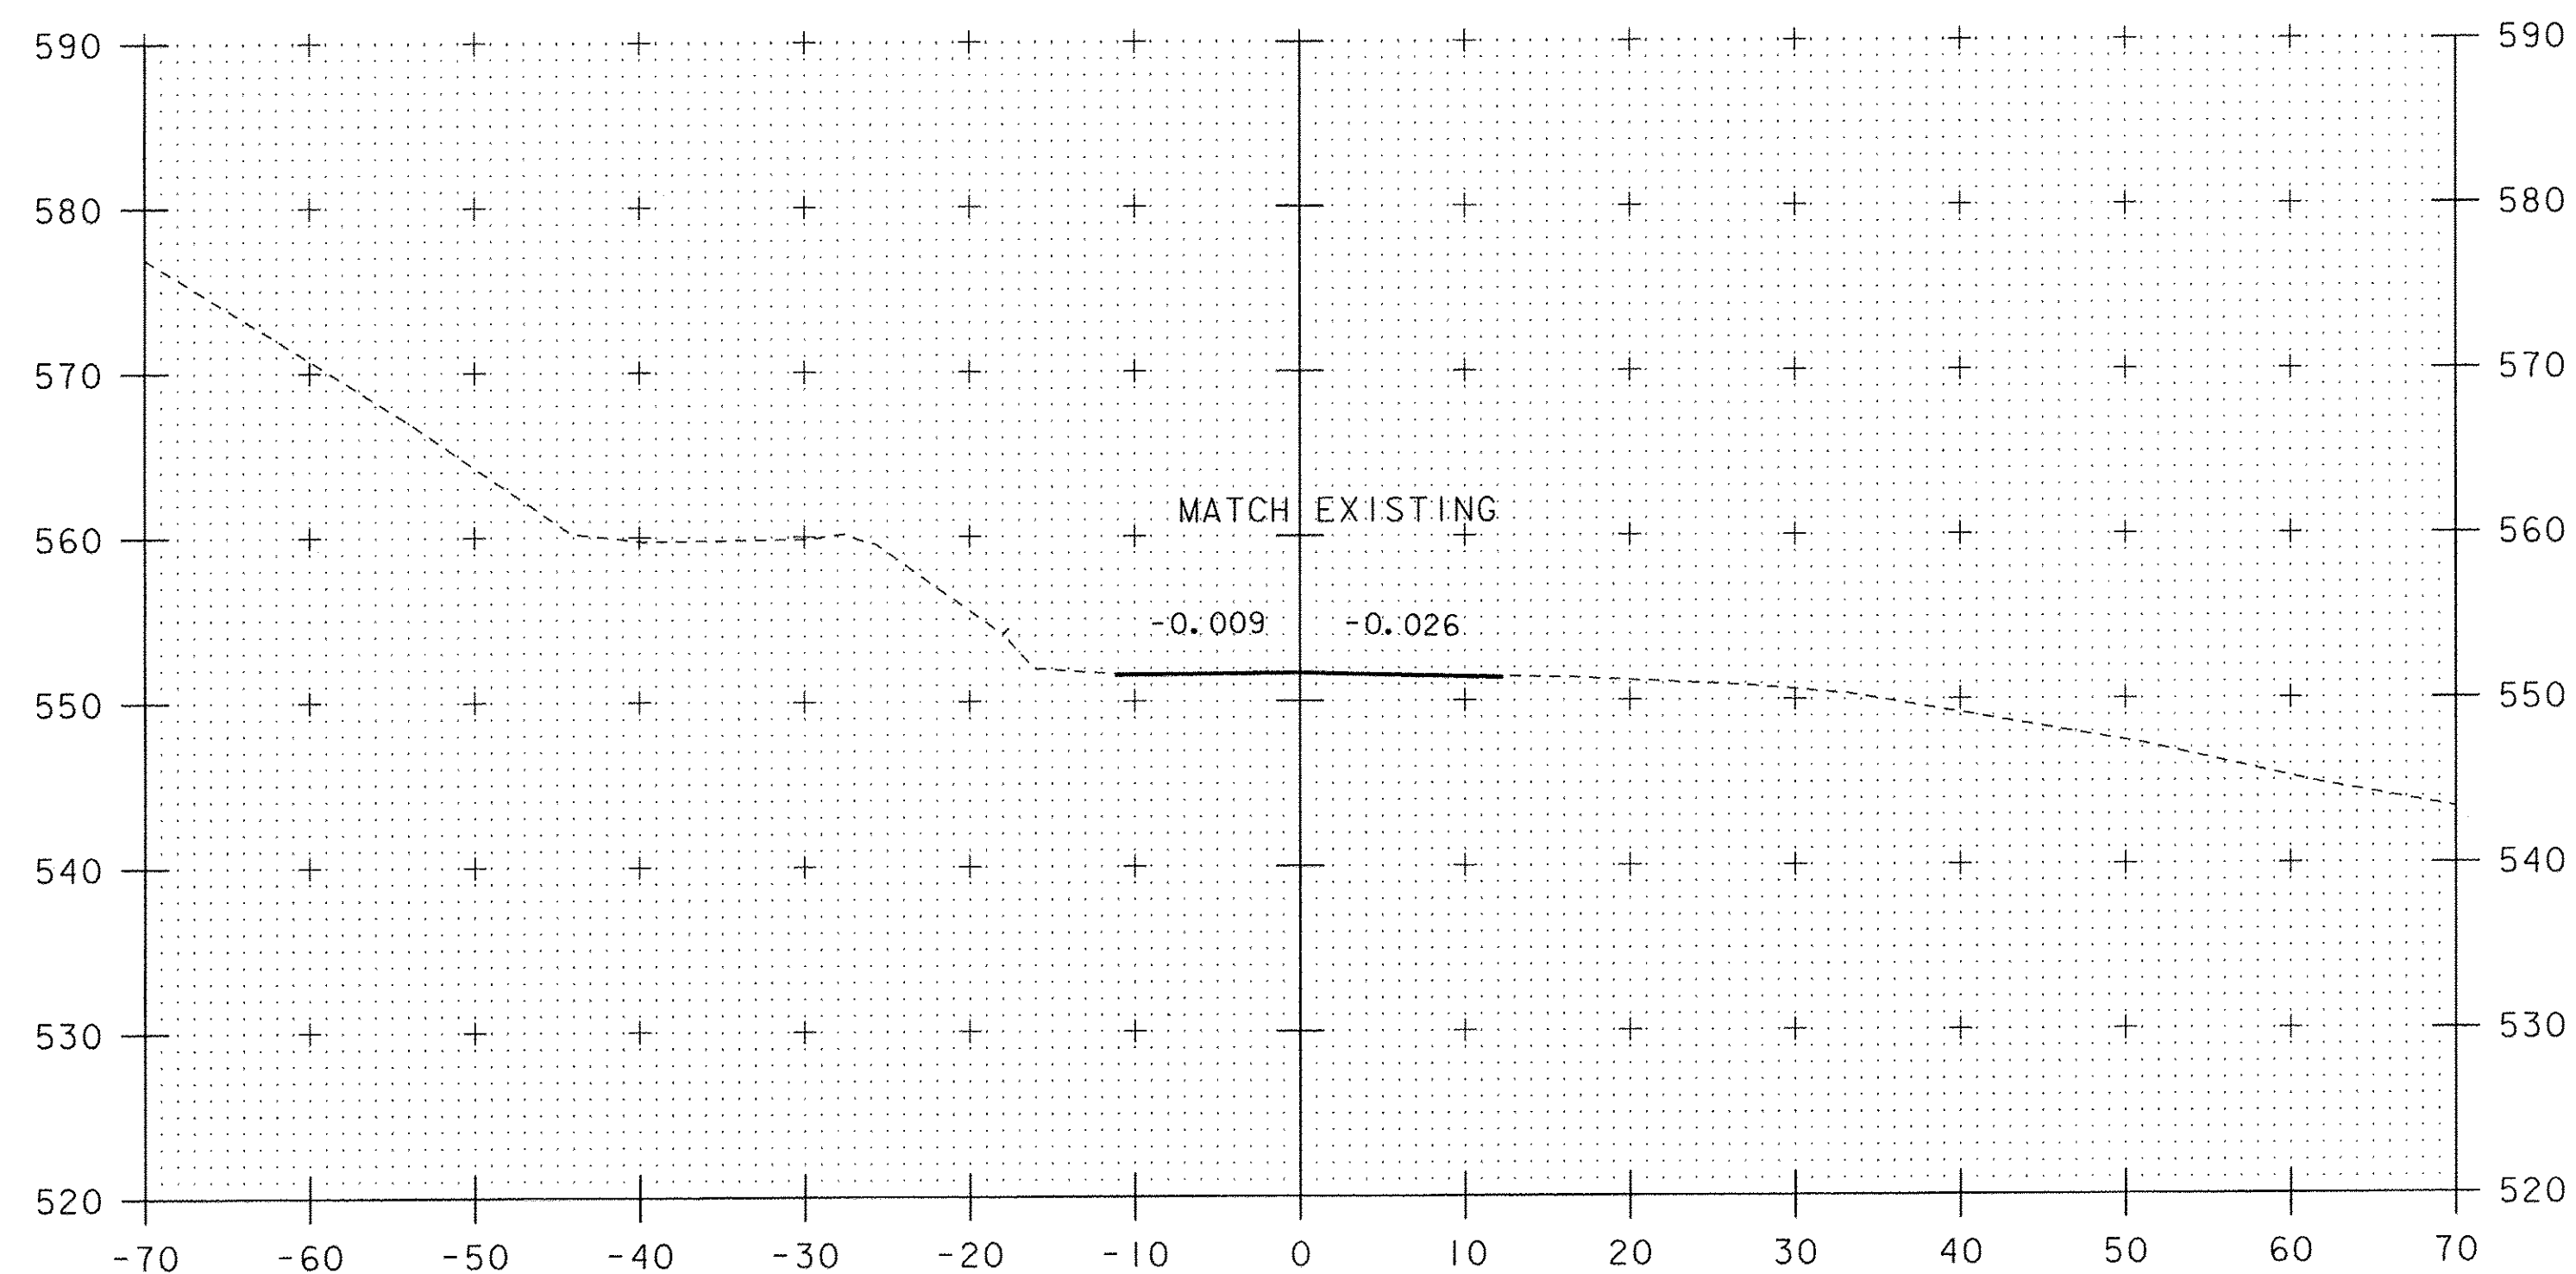


14+25

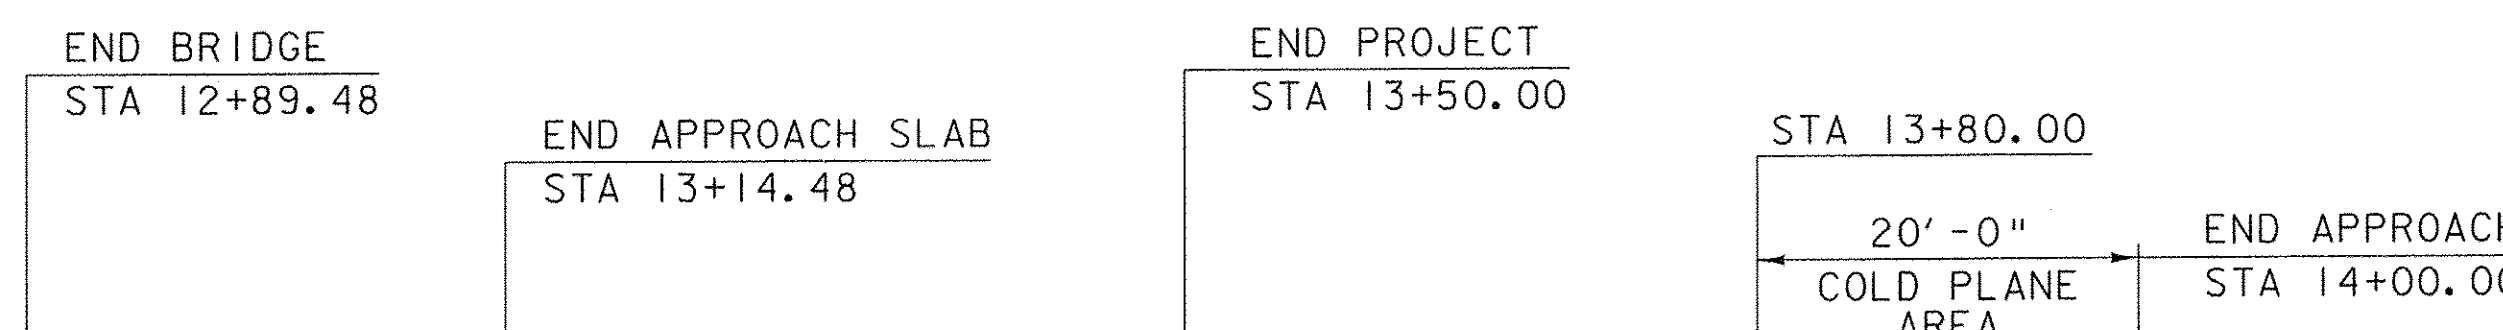

END APPROACH
14+00

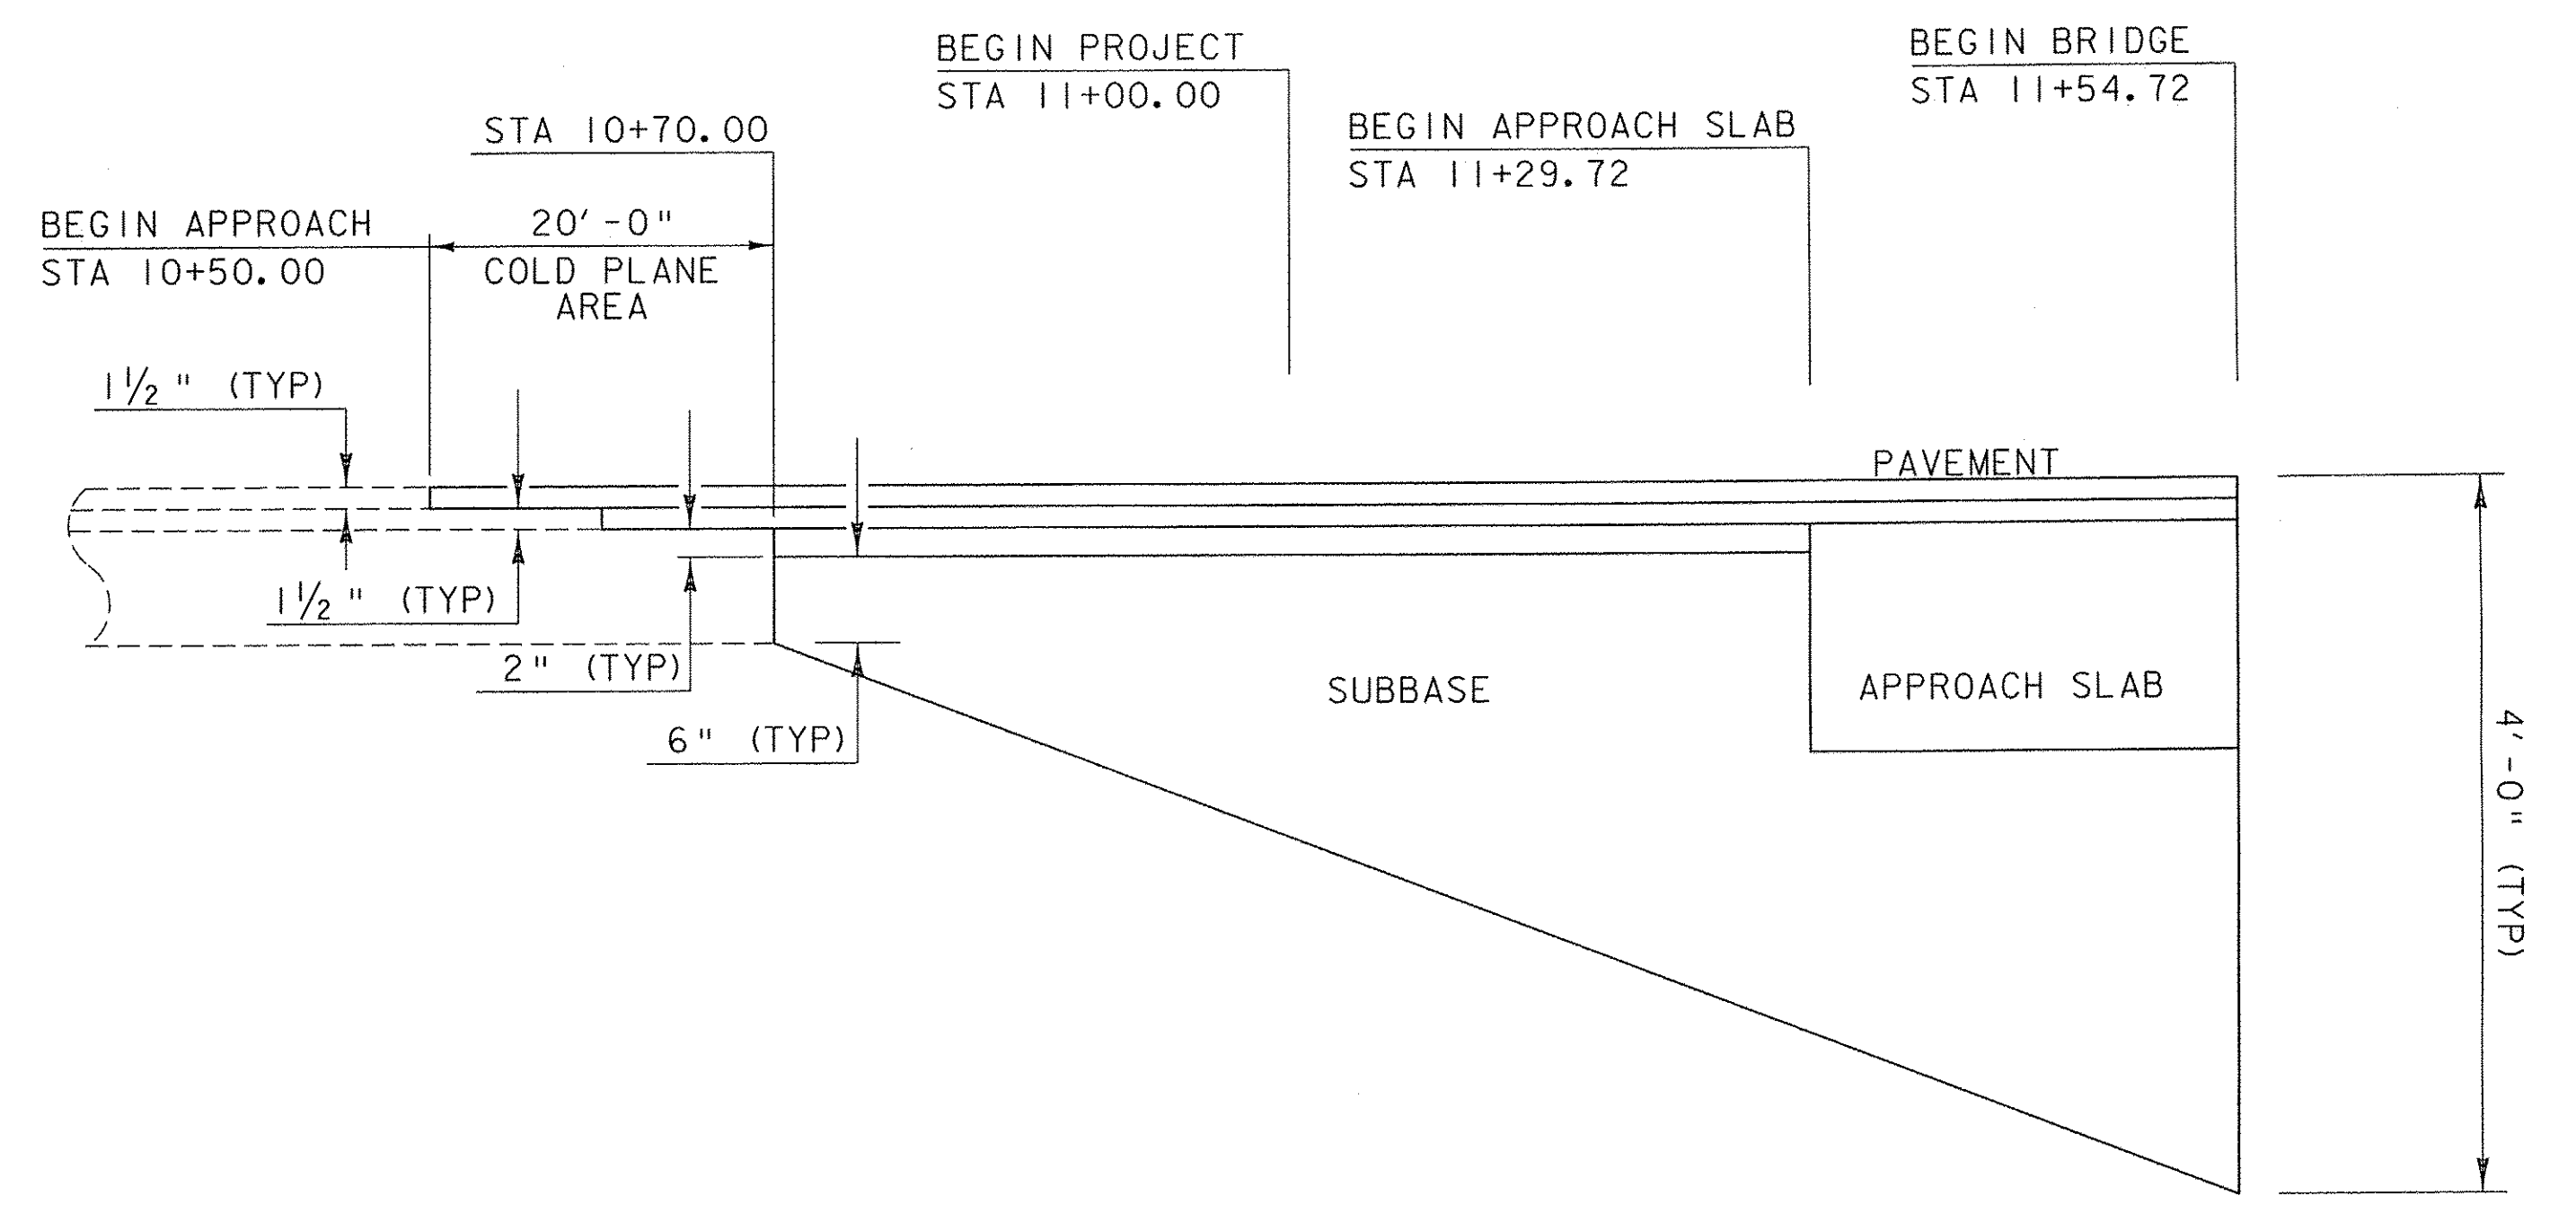

MATERIAL TRANSITION
HOR. SCALE 1" = 10'-0"
NO VERT. SCALE

SCALE 1" = 10'-0"
10 0 10

STA. 14+00 TO STA. 14+25

PROJECT NAME: SPRINGFIELD
PROJECT NUMBER: BRO 1442(26)

FILE NAME: s95j282xsl.dgn
PROJECT LEADER: K. HIGGINS
DESIGNED BY: J. SALVATORI
ROADWAY CROSS SECTIONS - 5

PLOT DATE: 30-AUG-2011
DRAWN BY: J. SALVATORI
CHECKED BY: J. LACROIX
SHEET 48 OF 52