




50+10

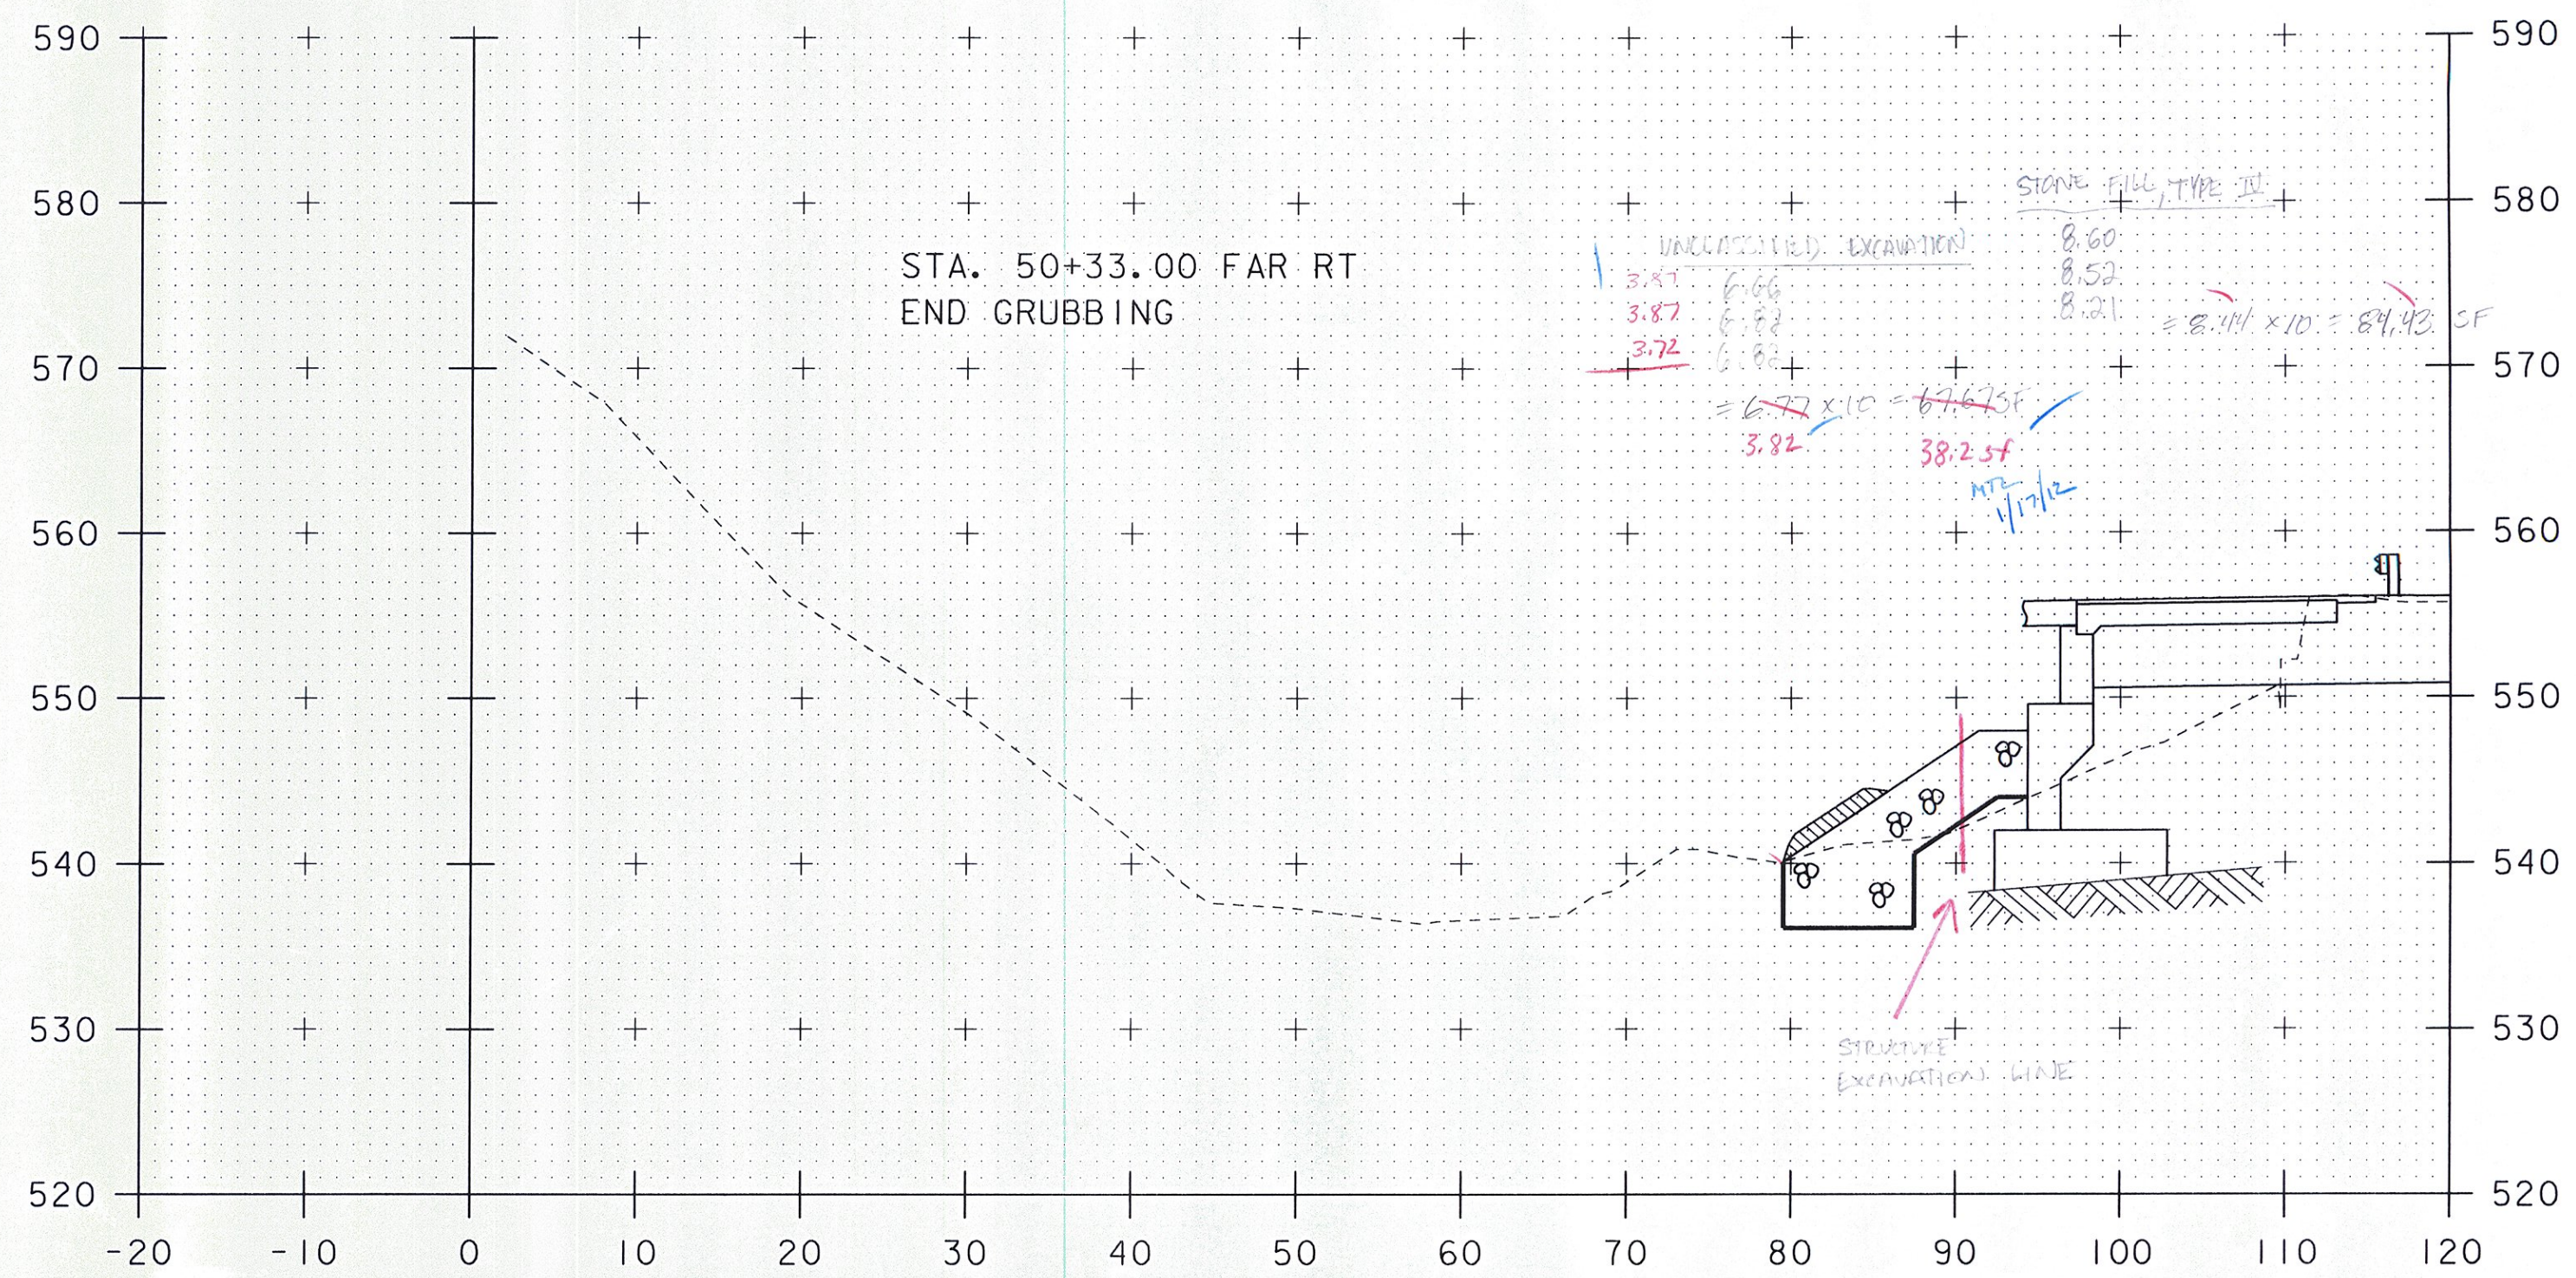

50+30

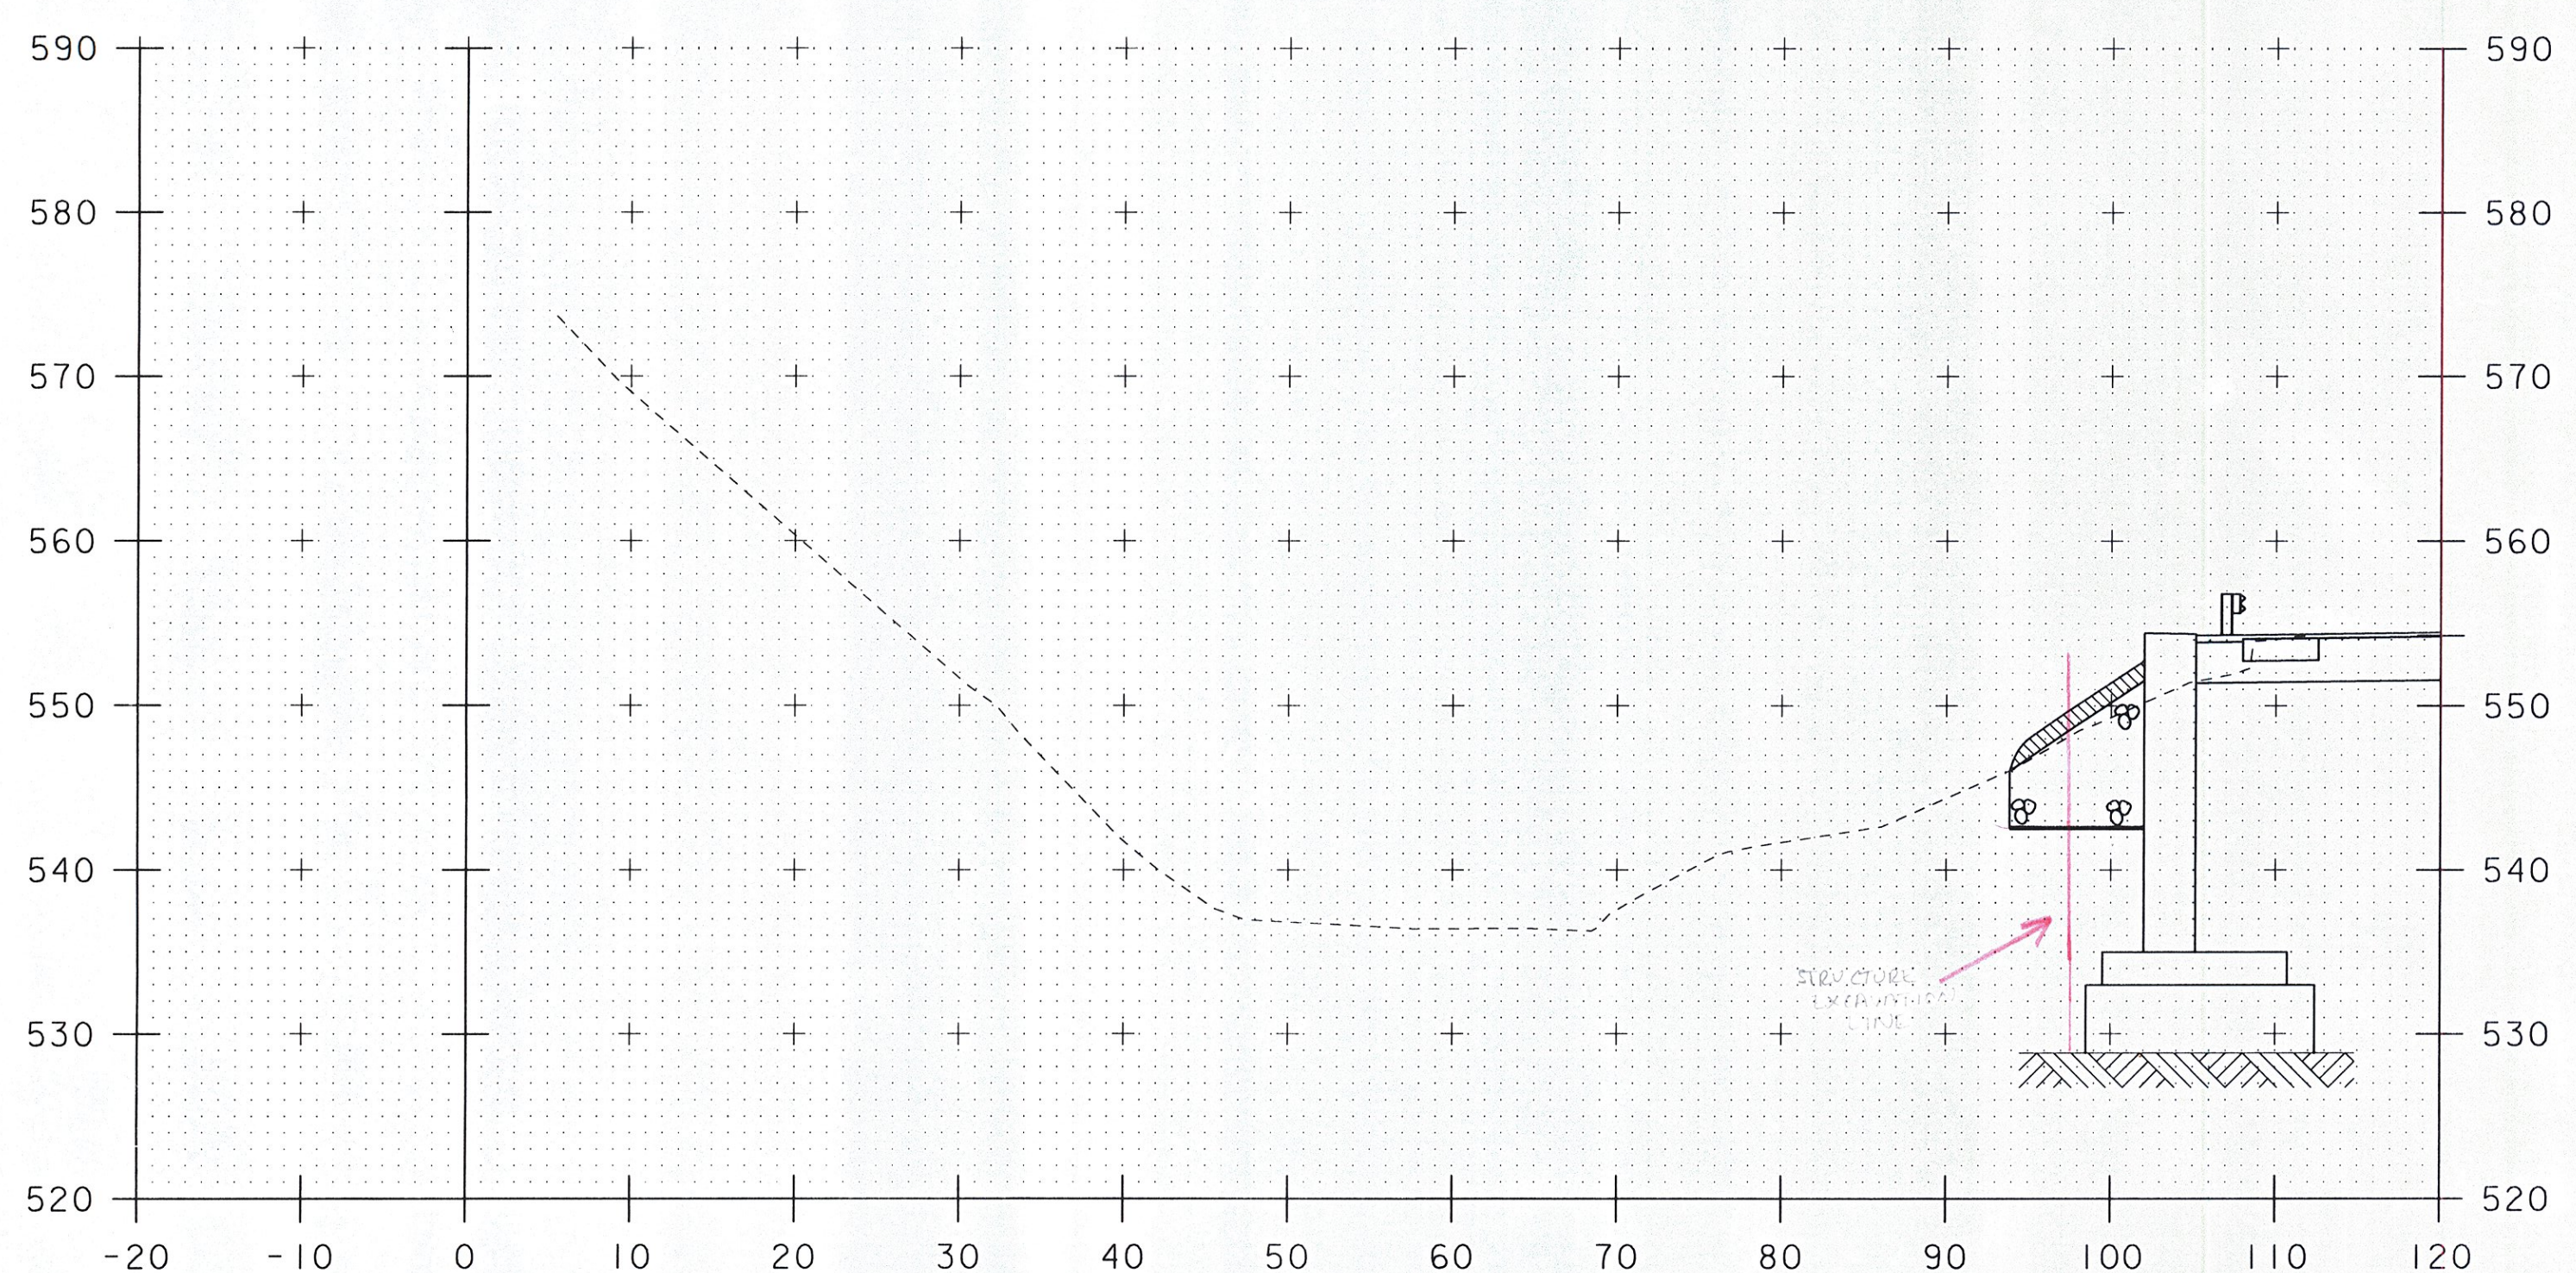

50+00

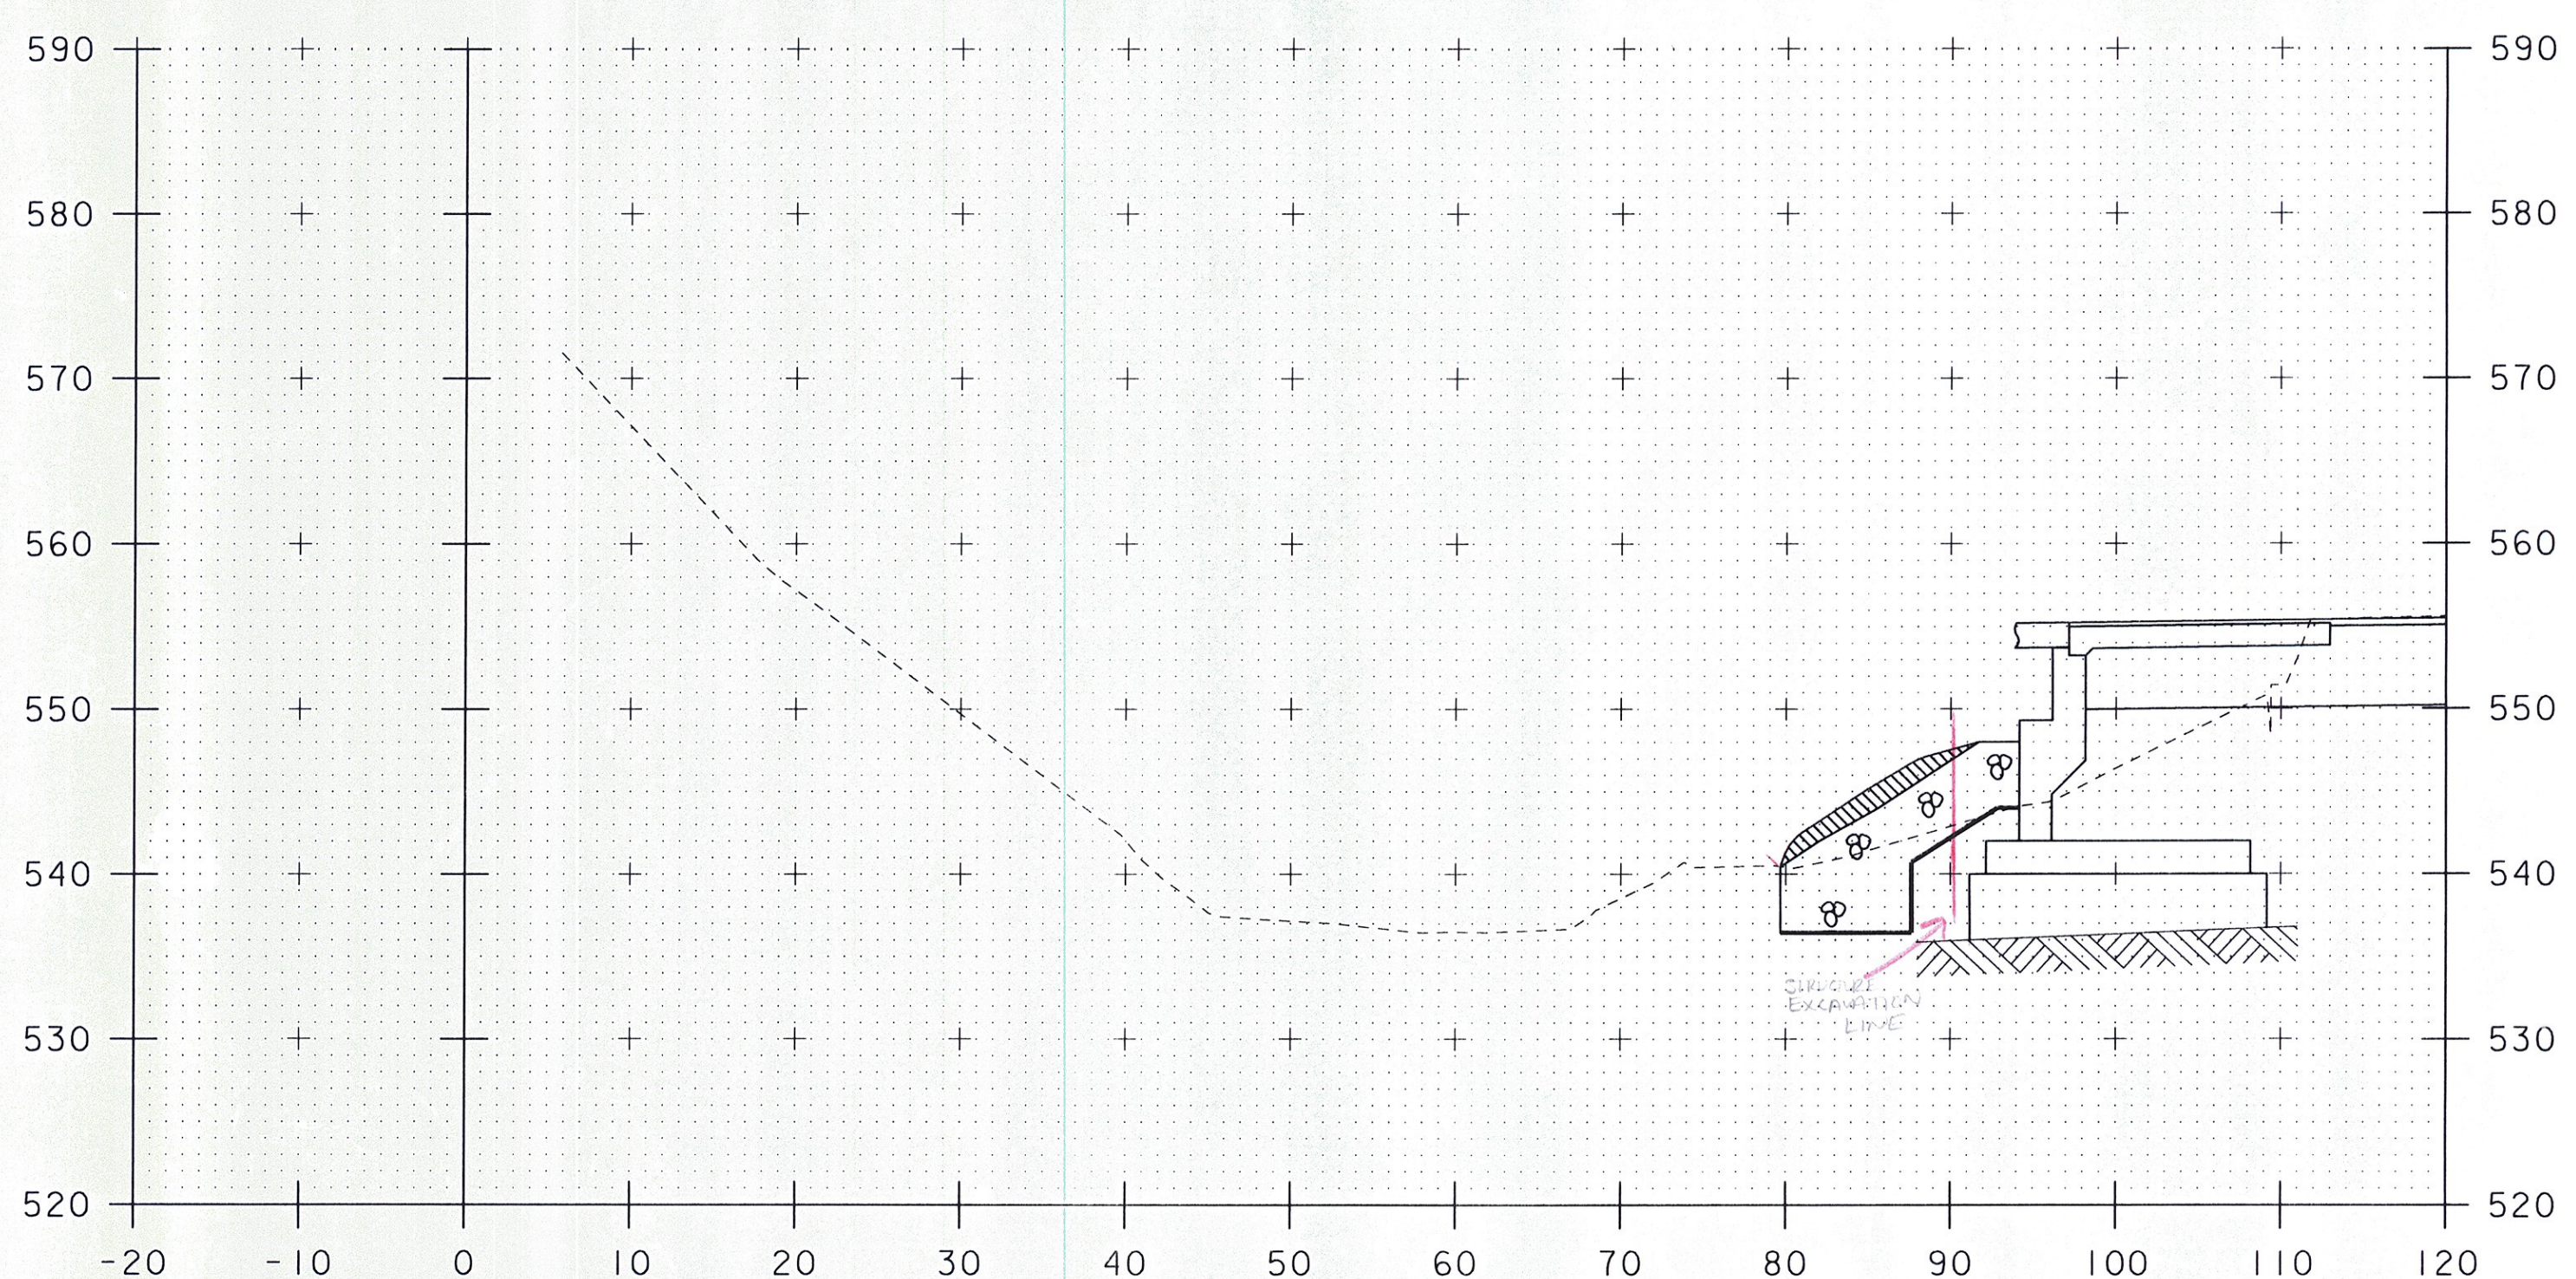

50+20

SCALE 1" = 10'-0"

STA. 50+00 TO STA. 50+30

PROJECT NAME: SPRINGFIELD	PLOT DATE: 30-AUG-2011
PROJECT NUMBER: BRO 1442(26)	DRAWN BY: J. SALVATORI
FILE NAME: s95J282xsl.dgn	CHECKED BY: J. LACROIX
PROJECT LEADER: K. HIGGINS	SHEET 49 OF 52
DESIGNED BY: J. SALVATORI	CHANNEL CROSS SECTIONS - 1