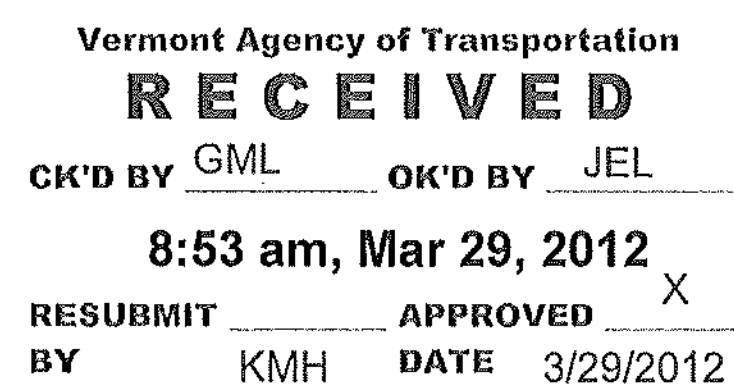
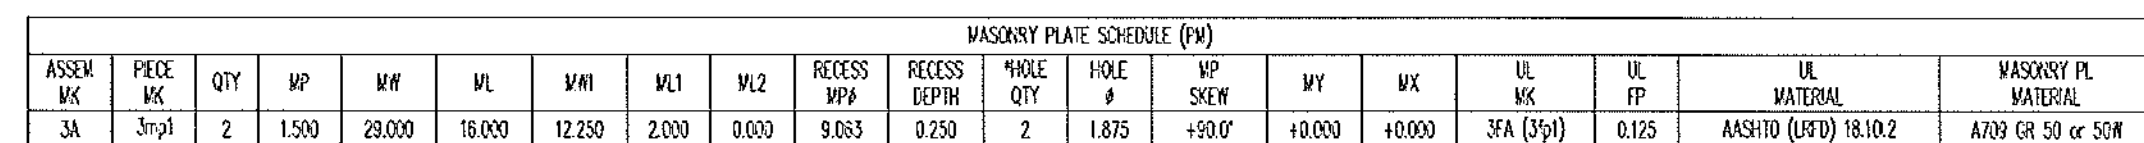


* PER PLATE
SEE SHT. 03 FOR ASSEMBLY INFORMATION & DETAILS.
SEE SHT. 05 FOR SUB-ASSEMBLY DETAILS.
ALL DIMENSIONS IN INCHES UNLESS OTHERWISE NOTED.

ALL DIMENSIONS IN INCHES UNLESS OTHERWISE NOTED.						
REV	DESCRIPTION			DATE	DET. CHK	QUANTITY
	LOCATION -- TOWN HIGHWAY B BRIDGE NO. 57					
	BRIDGE -- 57					--
	PROJECT NO. -- BRO 1442(26)					--
	PROJECT NAME -- SPRINGFIELD					--
	VIDOT					--
	CUSTOMER -- T BUCK CONSTRUCTION, INC.					--
						--
						--
DRAWN BY:	PW MULTI-DIRECTIONAL HLMR SUB-ASSEMBLY DETAIL	SHEET NO. N.T.S.	NO. OF SHEETS DA	DESIGNED BY KTG	CHKD BY JLF	POST DATE
	WINDSOR CO., VT	35079	1117			04