


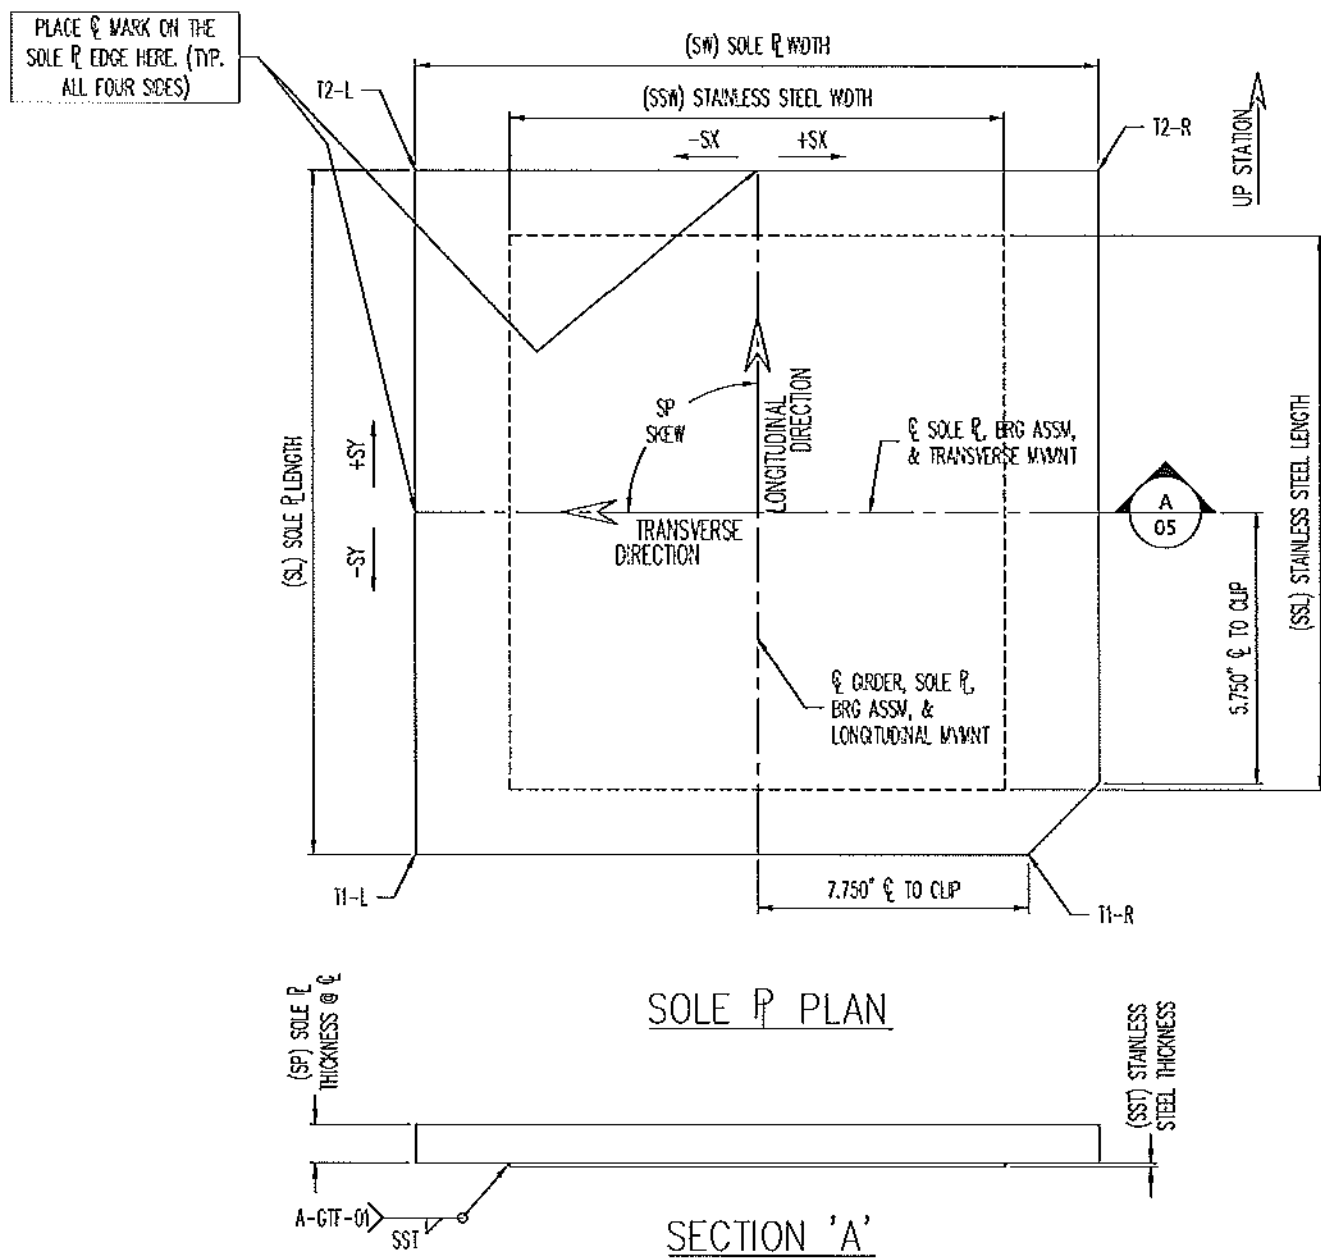

SOLE PLATE & STAINLESS STEEL SCHEDULE (IN)													
ASSUM	FEET	REV	QTY	REV	REV	REV	SP	SW	Q	SOLE PLATE MATERIAL	SP SS	SS	SP SS MATERIAL
SA	3.01	2	1.625	1.625	1.000	1.000	1.315	20.000	15.000	A102 OR S10 OR S10W	3.01	0.120	10.250

Vermont Agency of Transportation

RECEIVED

CK'D BY GML OK'D BY JEL

8:53 am, Mar 29, 2012

RESUBMIT APPROVED X

BY KMH DATE 3/29/2012



ASSEMBLY

03

SEE SHIT. 03 FOR ASSEMBLY INFORMATION & DETAILS.
SEE SHIT. 04 FOR SUB-ASSEMBLY DETAILS.
ALL DIMENSIONS IN INCHES UNLESS OTHERWISE NOTED.

REV.	DESCRIPTION	DATE	DET.	CRD.
1	LOCATION --- TOWN HIGHWAY 8 BRIDGE NO. 57			
2	BRIDGE --- 57			
3	PROJECT NO. --- BRD 1442(26)			
4	PROJECT NAME --- SPRINGFIELD			
5	DESIGNER --- VTDOT			
6	CUSTOMER --- T BUCK CONSTRUCTION, INC.			
7	PROJECT NO. --- 35029			
8	PROJECT NAME --- PM MULTI-DIRECTIONAL HLAR SUB-ASSEMBLY DETAIL			
9	PROJECT NO. --- 35029			
10	PROJECT NAME --- WINDSOR CO., VT			