

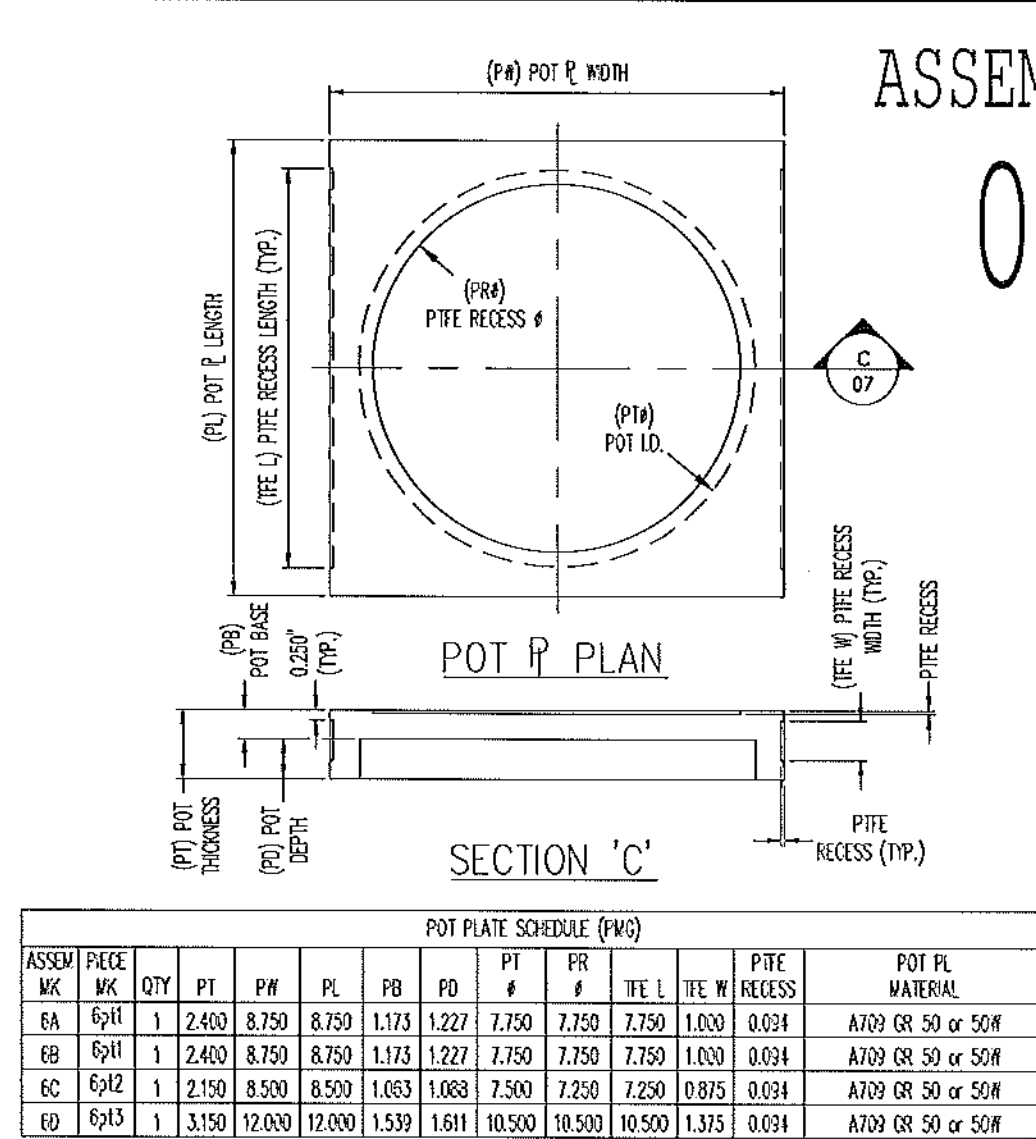


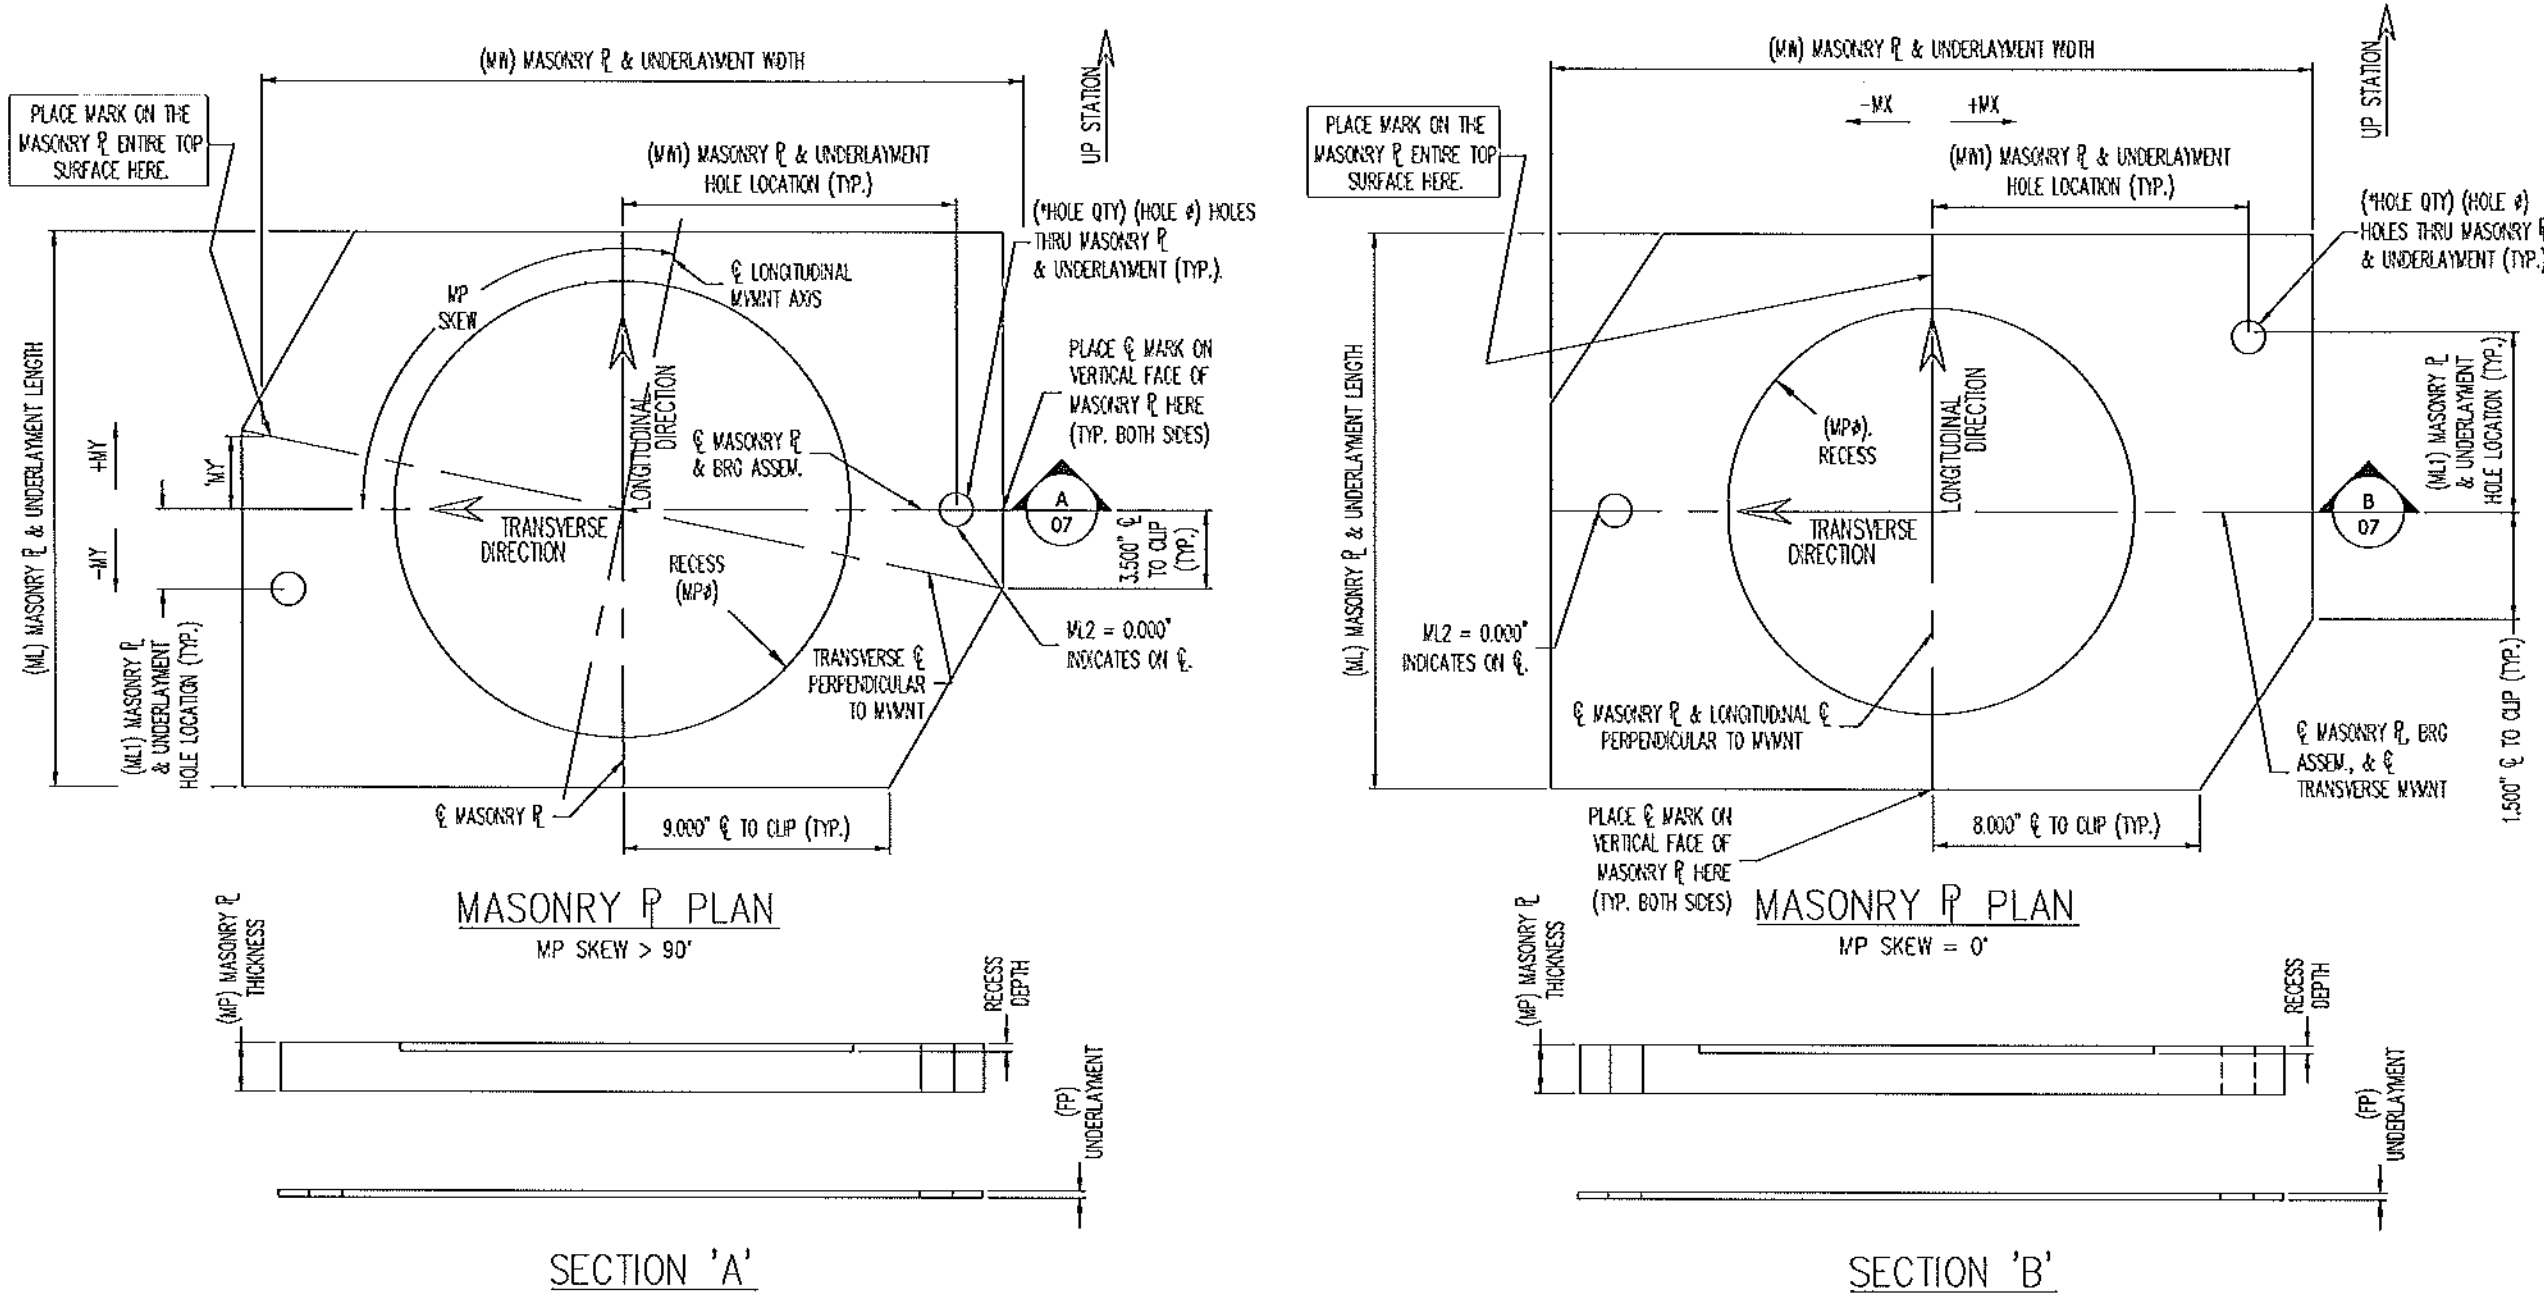

ASSEMBLY
06


POT PLATE SCHEDULE (FWG)													
ASSEM	PIECE	WK	QTY	PT	PW	PL	PB	PD	PR	TE L	TE W	PITE	POT PL MATERIAL
EA	6A	6A1	1	2.400	8.750	8.750	1.175	1.227	7.750	7.750	1.000	0.034	A709 CR 50 or 50W
EB	6B	6B1	1	2.400	8.750	8.750	1.175	1.227	7.750	7.750	1.000	0.034	A709 CR 50 or 50W
EC	6C	6C1	1	2.750	8.500	8.500	1.083	1.083	7.500	7.250	0.875	0.034	A709 CR 50 or 50W
ED	6D	6D1	1	3.150	12.000	12.000	1.539	1.611	10.500	10.500	1.375	0.034	A709 CR 50 or 50W

MASONRY PLATE SCHEDULE (FWG)													
LOCATION	ASSEM	PIECE	WK	QTY	MP	W1	W2	W3	W4	W5	W6	W7	W8
ABUTMENT 1: G2	EA	6A1	1	1.500	29.000	16.000	12.250	2.000	0.000	7.775	0.250	2	1.675
ABUTMENT 1: G3	EB	6B1	1	1.500	29.000	16.000	12.250	2.000	0.000	7.775	0.250	2	1.675
ABUTMENT 2: G1	EC	6C1	1	1.500	29.000	18.000	12.250	4.500	0.000	7.525	0.250	2	1.675
ABUTMENT 2: G4	ED	6D1	1	2.500	29.000	18.000	11.500	4.500	0.000	10.525	0.250	2	2.375

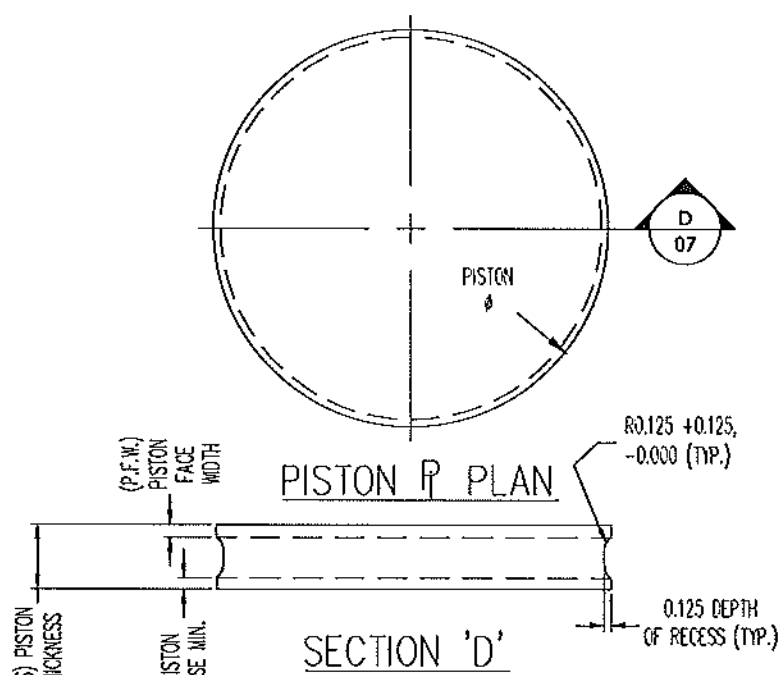

PISTON SCHEDULE (FWG)													
ASSEM	PIECE	WK	QTY	PS	PTW	PTW	PTW	PTW	PTW	PTW	PTW	PTW	PTW
EA	6A1	1	1.225	7.710	0.235	0.250	A709 CR 50 or 50W						
EB	6B1	1	1.225	7.710	0.235	0.250	A709 CR 50 or 50W						
EC	6C1	1	1.225	7.460	0.235	0.250	A709 CR 50 or 50W						
ED	6D1	1	1.600	10.460	0.235	0.250	A709 CR 50 or 50W						

Vermont Agency of Transportation
RECEIVED
CK'D BY GML OK'D BY JEL
8:53 am, Mar 29, 2012
RESUBMIT BY KMH APPROVED BY JEL
DATE 3/29/2012

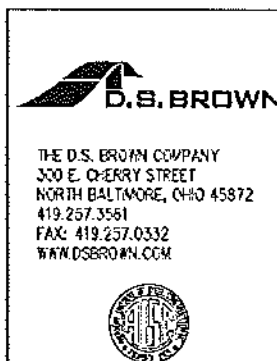

* PER PLATE
SEE SH. 05 FOR ASSEMBLY DETAILS & LOCATIONS.
SEE SH. 06 FOR ADDITIONAL SUB-ASSEMBLY DETAILS.
ALL DIMENSIONS ARE IN INCHES UNLESS OTHERWISE NOTED.

NO.	DESCRIPTION	DATE	BY	CHKD.
1	ADDED LOCATIONS TO MASONRY PLATE SCHEDULE	3/28/12	KTG	KTG
2	LOCATION — TOWN HIGHWAY 6 BRIDGE NO. 57			
3	BRIDGE — 57			
4	PROJECT NO. — BRD 1442(26)			
5	PROJECT NAME — SPRINGFIELD			
6	DESIGNER — VDOT			
7	CUSTOMER — T. BUCK CONSTRUCTION, INC.			
8	GROUP NO.			
9	FWG UNI-DIRECTIONAL HLVR SUB-ASSEMBLY DETAIL			
10	WINDSOR CO., VT			
11	DATE	3/28/12		
12	BY	KTG		
13	CHKD.	1112		
14	DATE	1		
15	BY	07		