




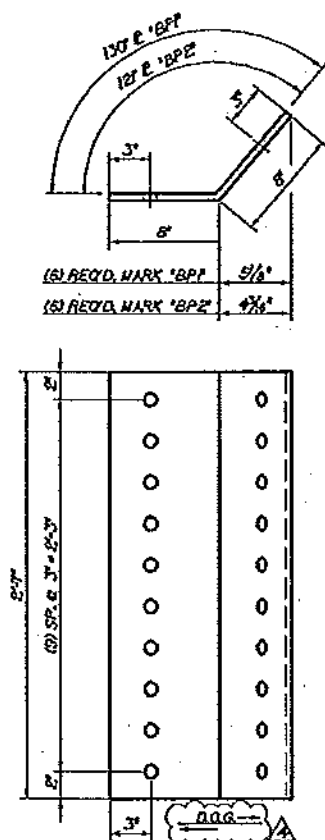


1/2 BENT CONNECTION E's
 SEE SHEET 10-1-1 FOR
 SEE SHEET 10-1-2 FOR
 SEE SHEET 10-1-3 FOR

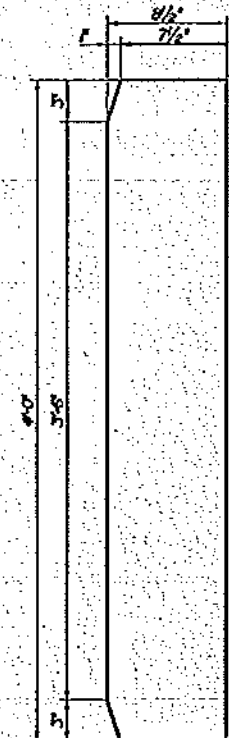


7/8 CONN. E. MARK 'P1'

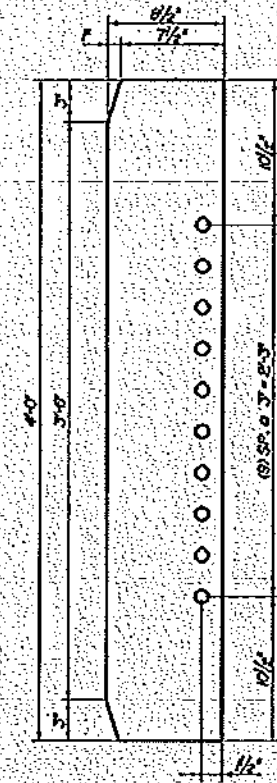

7/8 CONN. E. MARK 'P2'

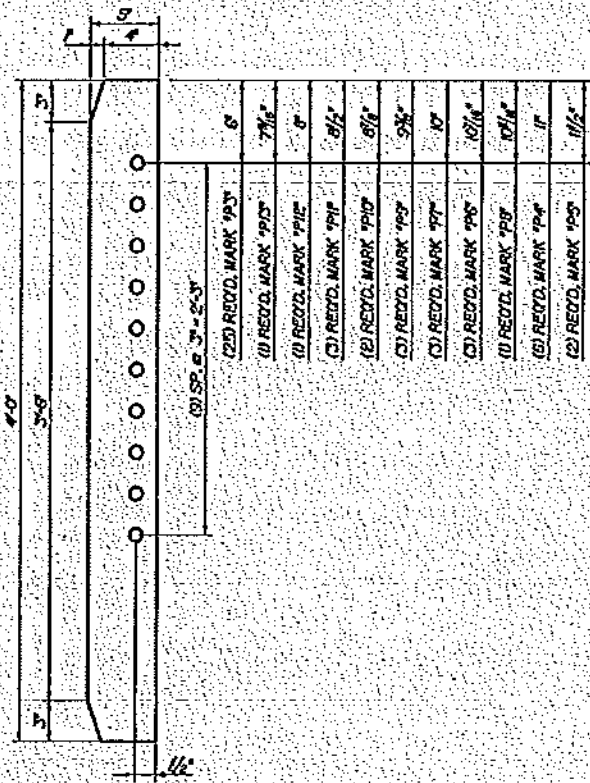




1/2 CONNECTION E's

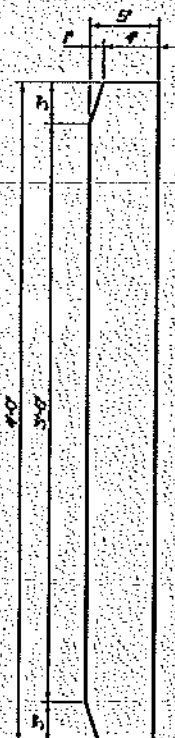

1/2 CONN. E. MARK 'P14'

BILL OF MATERIALS						
NO.	QTY.	DESCRIPTION	LENGTH	REMARKS	UNIT	PRICE
1	1	E 1/2 x 10'	10'	TOP EACH	LN	
2	1	E 1/2 x 10'	10'	TOP EACH	LN	
ALL ASBESTOS TYPE 3 BOLTS ARE TO BE USED OUTSIDE THE PAINT LIMITS
 ALL ASBESTOS TYPE 3 BOLTS ARE TO BE USED WITH PAINT LIMITS
 SEE SHEET 10-1-1 FOR

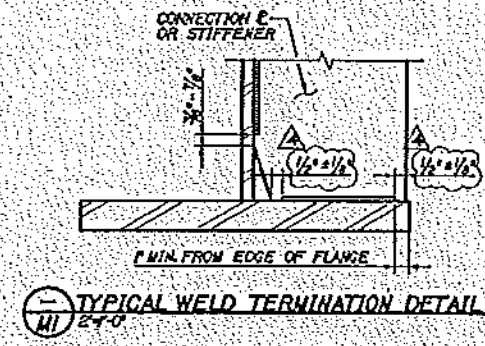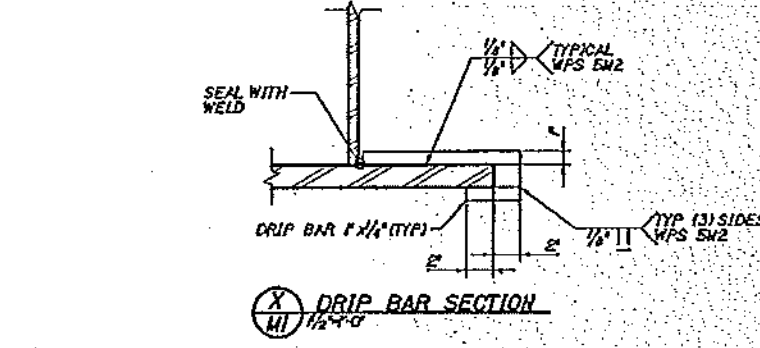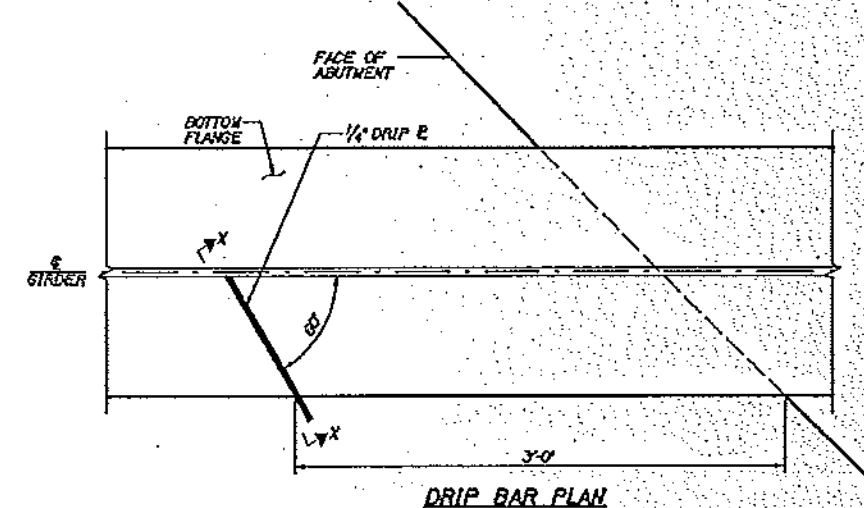

Vermont Agency of Transportation
RECEIVED
 CK'D BY GML OK'D BY JEL
 11:20 am, Mar 19, 2012
 RESUBMIT APPROVED X
 BY KMH DATE 3/19/2012

SPEC SEE EVERYWHERE - OUTSIDE PAINT LIMITS ONLY	
MATERIAL	ASBESTOS TYPE 3 BOLT
QUANTITY	100
PRICE	1.00
TOTAL	100.00
REVISIONS	
NO.	DATE
1	3/19/2012
2	3/19/2012
