




GIRDER #61 CAMBER
CAMBER DIAGRAM IS DEVELOPED
K.T.S.

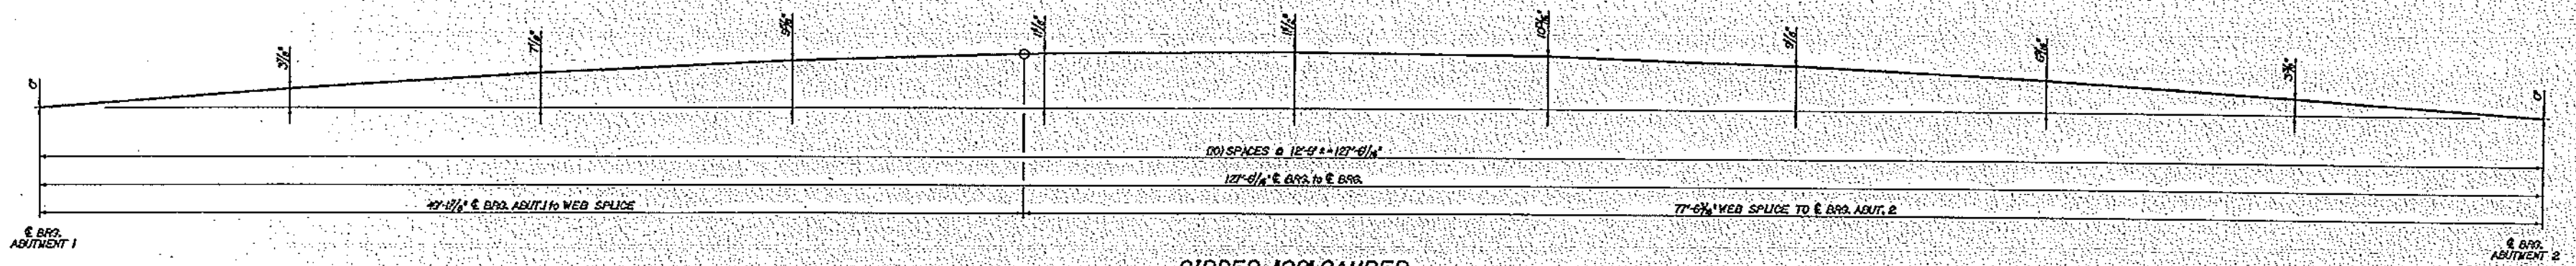

GIRDER #62 CAMBER
CAMBER DIAGRAM IS DEVELOPED
K.T.S.

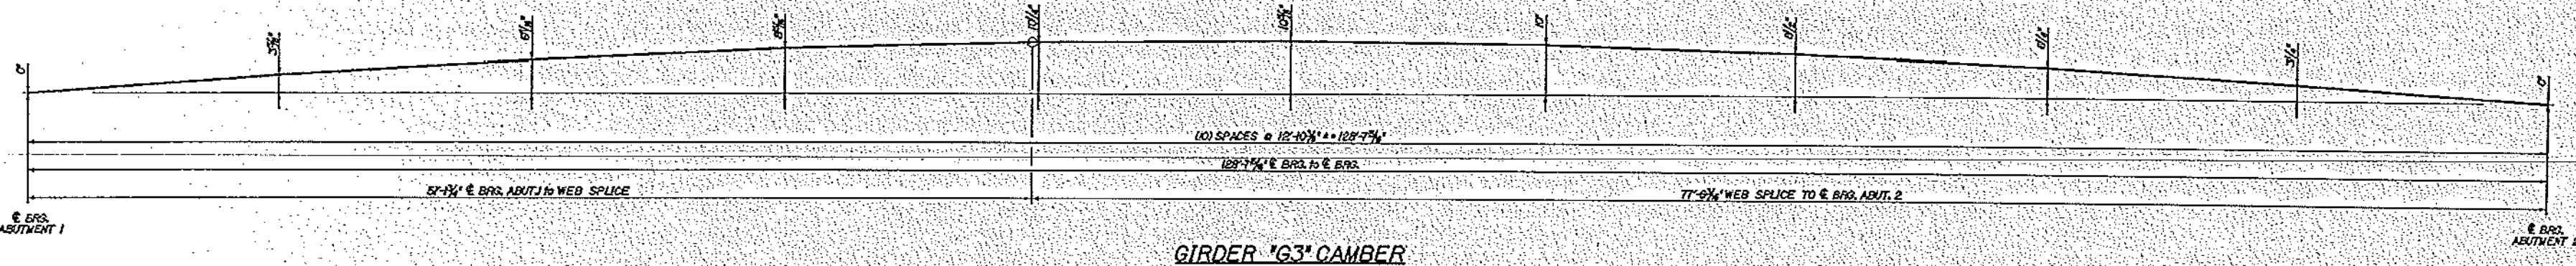

GIRDER #63 CAMBER
CAMBER DIAGRAM IS DEVELOPED
K.T.S.

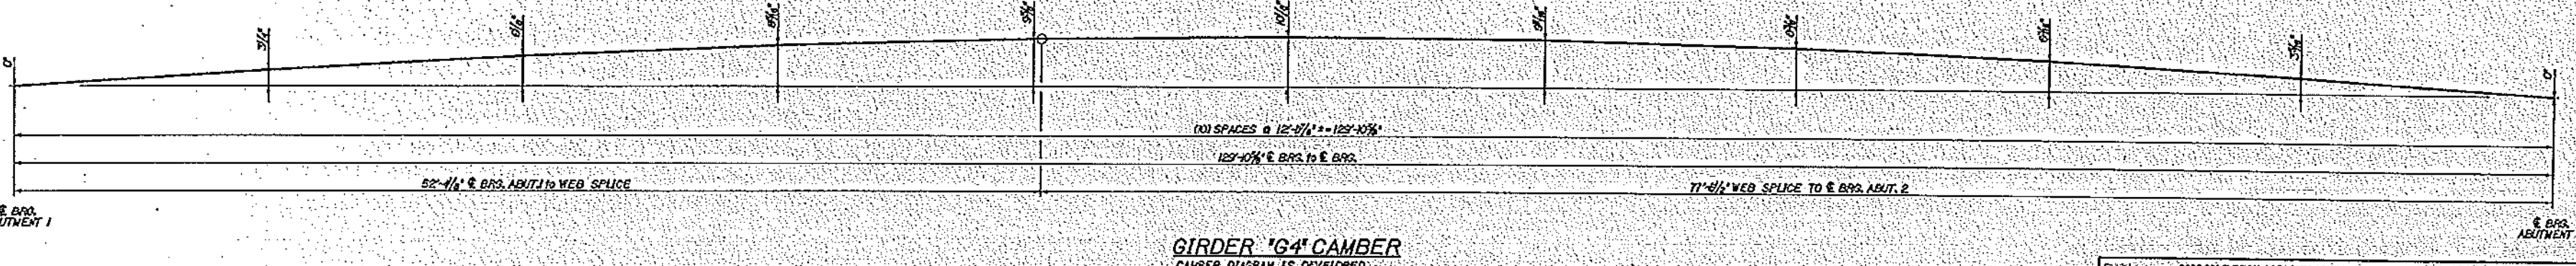

GIRDER #64 CAMBER
CAMBER DIAGRAM IS DEVELOPED
K.T.S.

Vermont Agency of Transportation
RECEIVED
CHK'D BY GML OK'D BY JEL
11:20 am, Mar 19, 2012
RESUBMIT _____ APPROVED X
BY KMH DATE 3/19/2012

FINISH: SPAC SP EVERYWHERE - OUTSIDE FANTASY ONLY	
MATERIAL: ASHED HULL WITH AND GRADE ONLY	
HOLES: 5/8" Ø DRG	
ELECTRICAL: _____	
WELDS: PER WELD PROCEDURE	
SURFACE PREP: SAND BLAST TO SA 2.5	
PAINT: BOND BR BRUSHED	NO DATE DESCRIPTION BY
REVISIONS	
DATE: 3/19/2012	BY: KMH
PROJECT NO: 610 0000	
SHEET NO: 103	
T-BUCK CONSTRUCTION	