
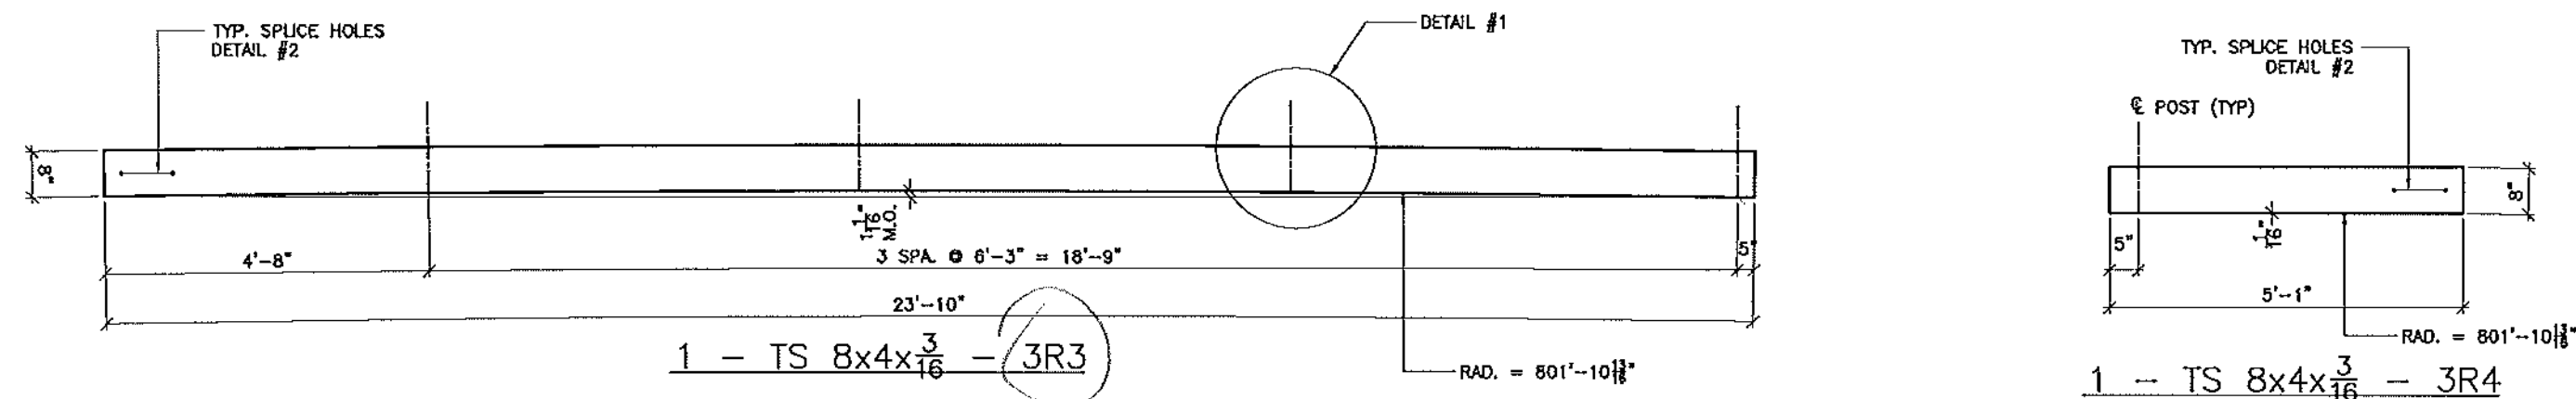
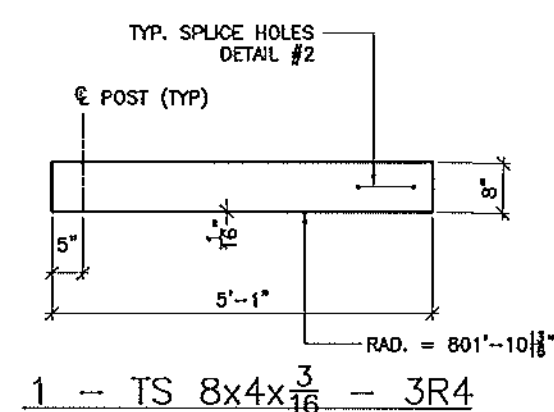
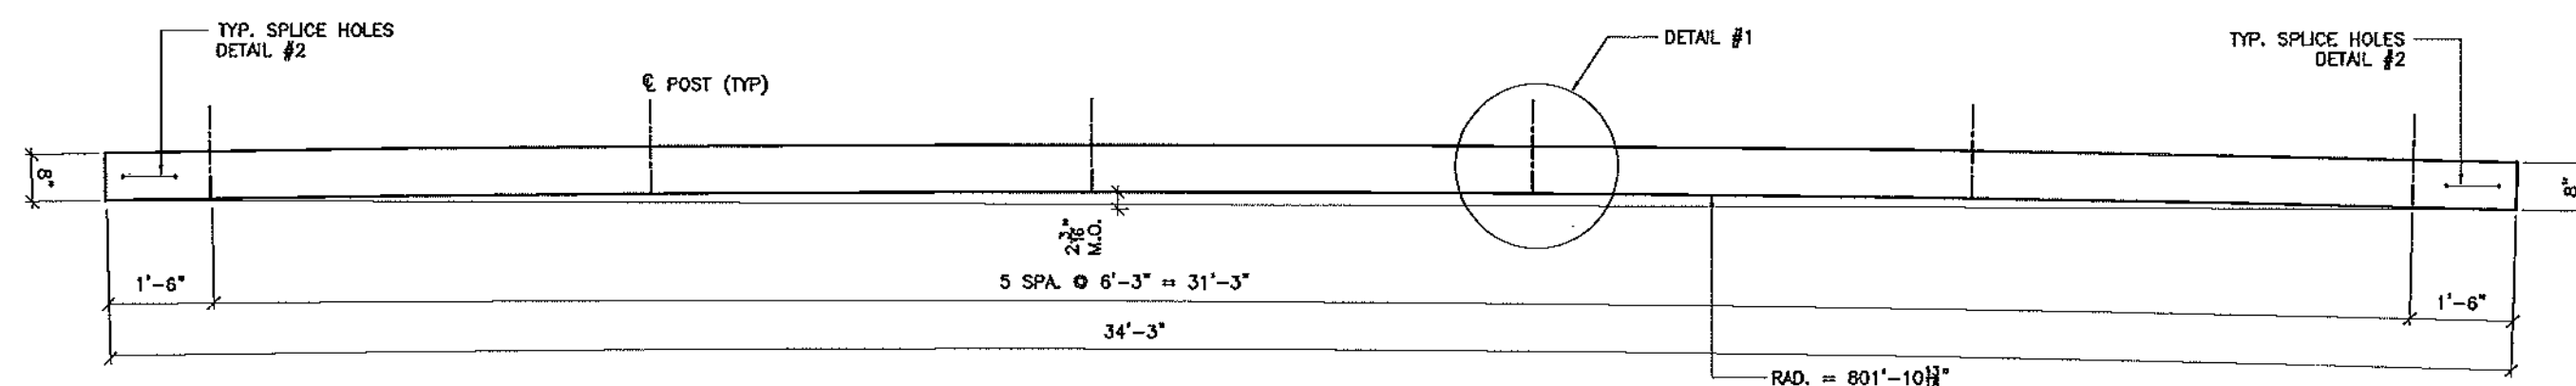



2 - TS 8x4x $\frac{3}{16}$ - 3R2


$$\frac{1 - TS \ 8 \times 4 \times \frac{3}{16}}{3R3}$$

$$\frac{1 - TS \ 8 \times 4 \times \frac{3}{16} - 3R4}{}$$


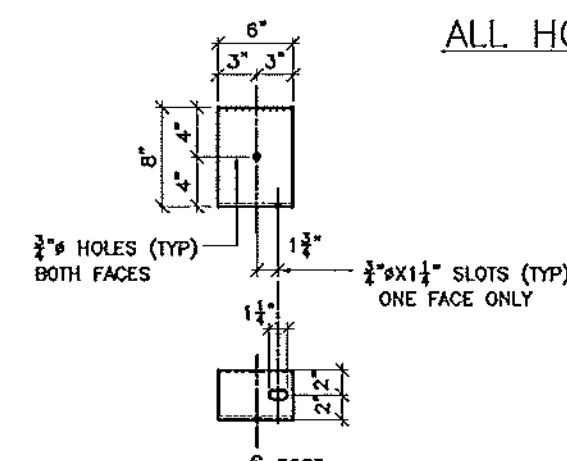
1 - TS 8x4x $\frac{3}{16}$ - 3R1

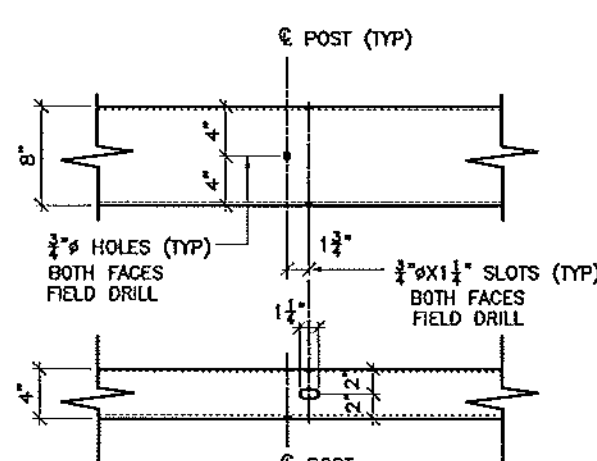

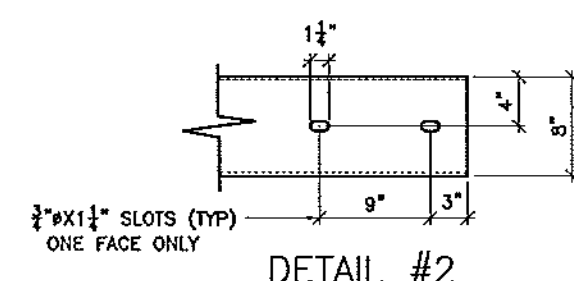DETAIL #1



DETAIL #2



92 REQ'D, TS8X4X $\frac{3}{16}$, MARK "T1"

ALL HOLES FOR POSTS ARE FIELD DRILLED

BILL OF MATERIAL

[illegible]

TUBE: ASTM A500 GR. B
GALVANIZE AFTER FABRICATION PER AASHTO M111

Vermont Agency of Transportation

RECEIVED

OK'D BY JGML OK'D BY JTS

3:46 pm, Mar 26, 2012

RESUBMIT _____ APPROVED ☒ X
BY KMH DATE 3/28/2012

SECTION BOLTS W/HAUL				WASHERS		FINISH	
QVAL	SIZE	LENGTH	TYPE	FLAT	BEY.	BULK WASHING	
FINISH				HOT DIPPED GALVANIZED			
MATERIAL				ASTM A307 GR. 36			
NUTS				AS NOTED			
ELECTRODES				PER W.P.S.			
WELDS				AS NOTED			
SURFACE PREP				SSPO-SFB			
				Δ NO 5/23/12		PER APPROVAL JAC	
				DATE		DESCRIPTION BY	

		REVISIONS ADVANCED RESOURCES & CONST. ENTERPRISES, INCORPORATED P.O. BOX 120 KINGFIELD, ME 04847 PHONE: (207) 283-2648 - FAX: (207) 283-4054	
DRAFTER JAC DATE 2/8/12 CHECKED MTD JOB 11-175		BRIDGE RAIL DETAILS VENTAGE AGENCY OF TRANSPORTATION, TOWN OF SPRAWFORD, T8 IN CLASS III, LOCAL ROAD T. BUCK CONSTRUCTION, INC.	
		PROJECT NO. BRD 14425-28 DWG. NO. R3	