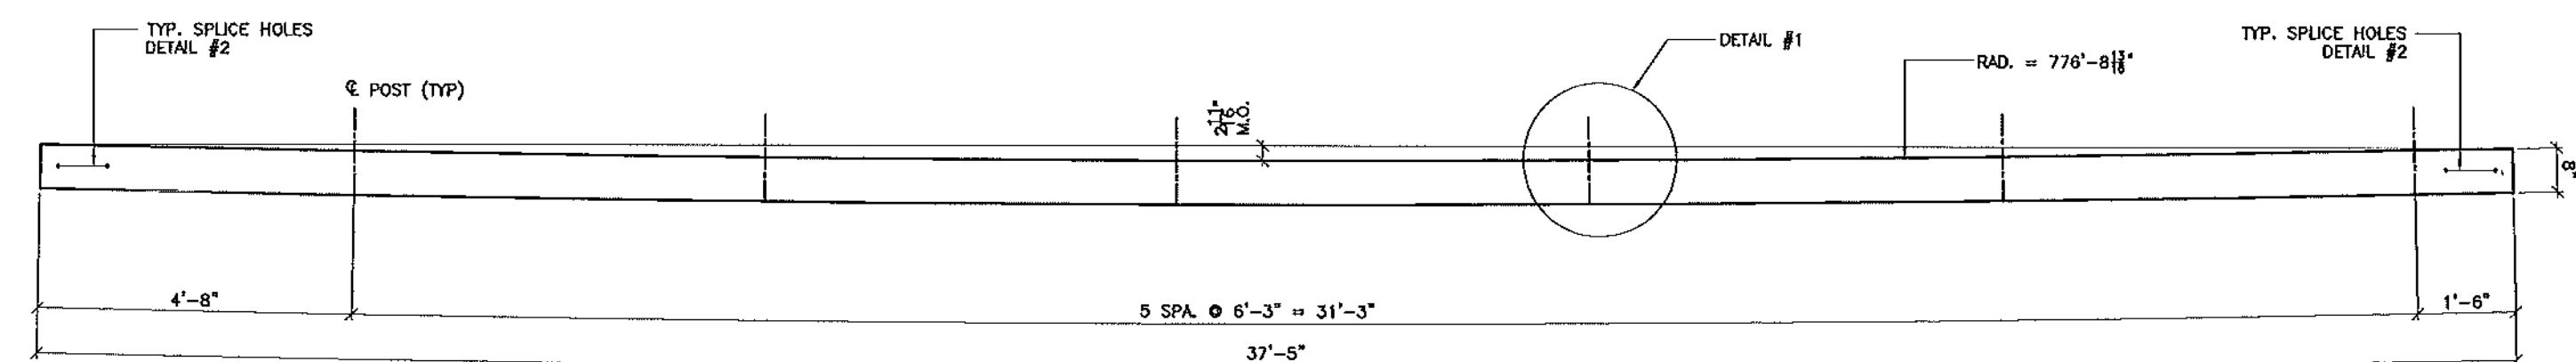
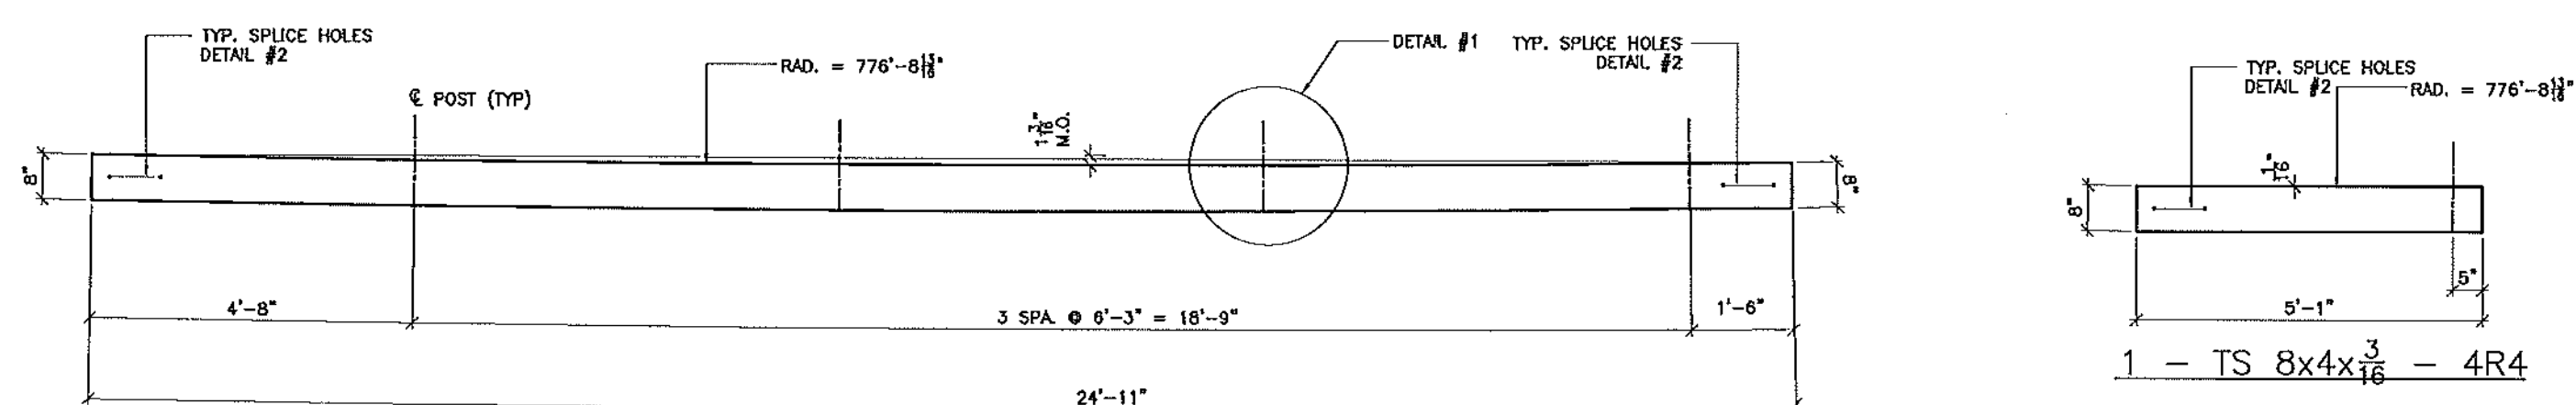


$$\frac{1 - TS \ 8 \times 4 \times \frac{3}{16}}{4R1}$$

$$2 - TS \ 8 \times 4 \times \frac{3}{16} = 4R2$$

$$\frac{1 - TS \cdot 8 \times 4 \times \frac{3}{16}}{4R3}$$

SEE DWG R3 FOR B.O.M. & DETAILS NOT SHOWN

TUBE: ASTM A500 GR. B
GALVANIZE AFTER FABRICATION PER AASHTO M111

Vermont Agency of Transportation

RECEIVED

CK'D BY GML OK'D BY JTS

3:46 pm, Mar 26, 2012

RESUBMIT _____ APPROVED ^X _____
BY KMH DATE 3/28/2012

[illegible]

		REVISIONS	
		ADVANCED RESOURCES & CONST. ENTERPRISES, INCORPORATED P.O. BOX 120 KNOXVILLE, TN 37901 PHONE: (703) 265-2848 - FAX: (703) 265-4054	
DRAFTER DATE <u>2/9/12</u> CHECKED JOB <u>11-175</u>	BRIDGE RAIL DETAILS VERMONT AGENCY OF TRANSPORTATION, TOWN OF SPRAWFORD, TN 6 CLASS & LOCAL ROAD O.C.		PROJECT NO. BRD 1442(26) DWS. NO. R4
T. BUCK CONSTRUCTION, INC.			