


SEE SHEET 2 FOR INDEX OF SHEETS

STATE OF VERMONT AGENCY OF TRANSPORTATION

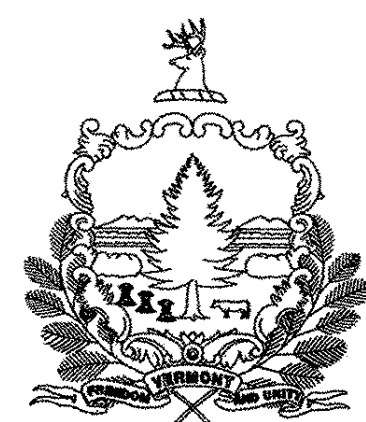

PROPOSED IMPROVEMENT BRIDGE PROJECT


TOWN OF WEATHERSFIELD
COUNTY OF WINDSOR

ROUTE NO : T.H. 32 CLASS 3 BRIDGE NO : 24


PROJECT LOCATION : BEGINNING AT A POINT APPROXIMATELY 1.29 KM FROM THE INTERSECTION OF
VT 106 AND T.H. 32 AND PROCEEDING EASTERLY 0.07 KM ALONG T.H. 32.

PROJECT DESCRIPTION : REPLACEMENT OF EXISTING BRIDGE WITH A NEW STRUCTURE, INCLUDING
ASSOCIATED CHANNEL AND ROADWAY APPROACH WORK.


LENGTH OF STRUCTURE : 9.620 METERS.
LENGTH OF ROADWAY : 40.380 METERS.
LENGTH OF PROJECT : 50.000 METERS.

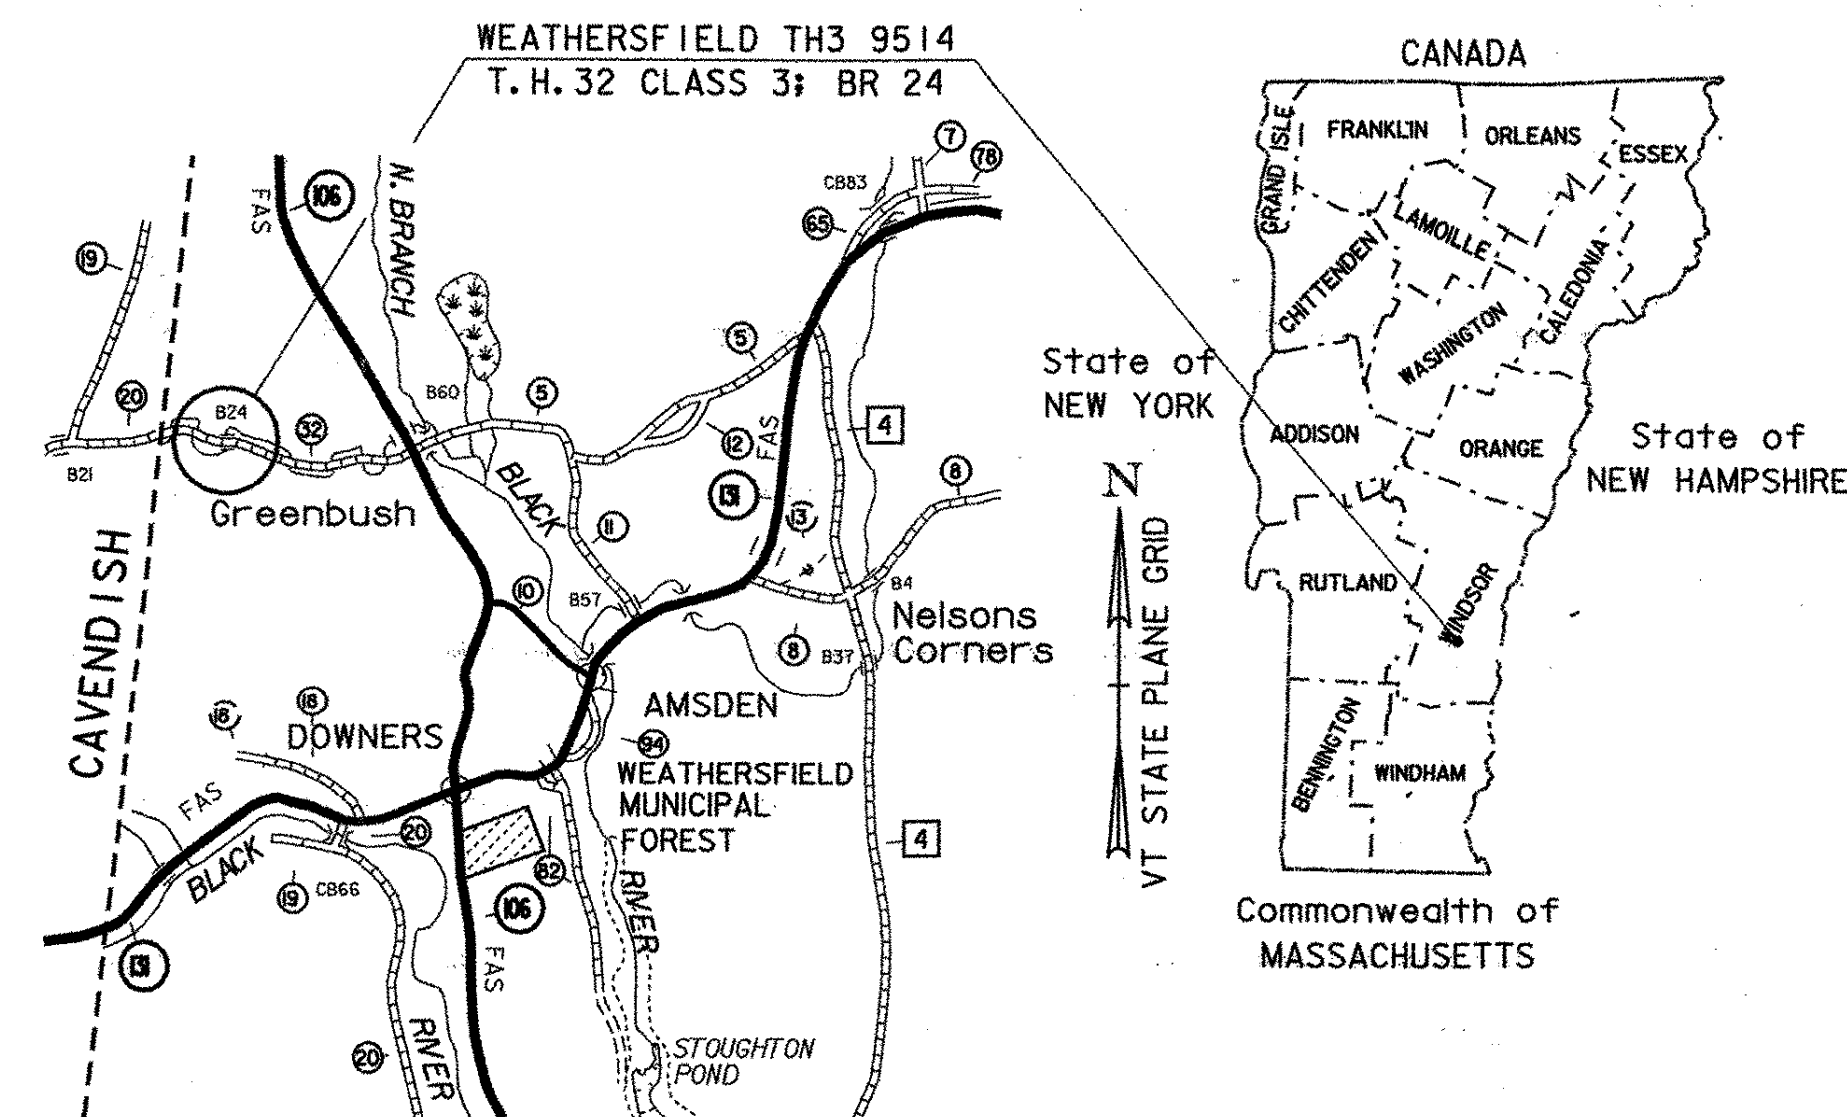

LOCATION MAP

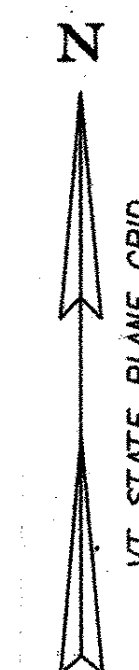


RECORD PLANS	
CONTRACTOR:	MILLER CONSTRUCTION - WINDSOR, VT
RESIDENT ENGINEER:	BUTCH COLBY
CONSTRUCTION BEGAN:	MAY 11, 2004
CONSTRUCTION COMPLETE:	OCTOBER 4, 2004
RECORD PLANS BY:	BUTCH COLBY
I HEREBY CERTIFY THAT ALL THE CONSTRUCTION REQUIRED BY THIS SET OF DRAWINGS HAS BEEN ACCOMPLISHED AS INDICATED HEREIN.	
BY:	<i>Butch Colby</i> RESIDENT ENGINEER
DATE:	7/7/05
NOTE: Any further information concerning final quantities, amounts or other details relative to this project may be found at Central Files in the electronic archives.	

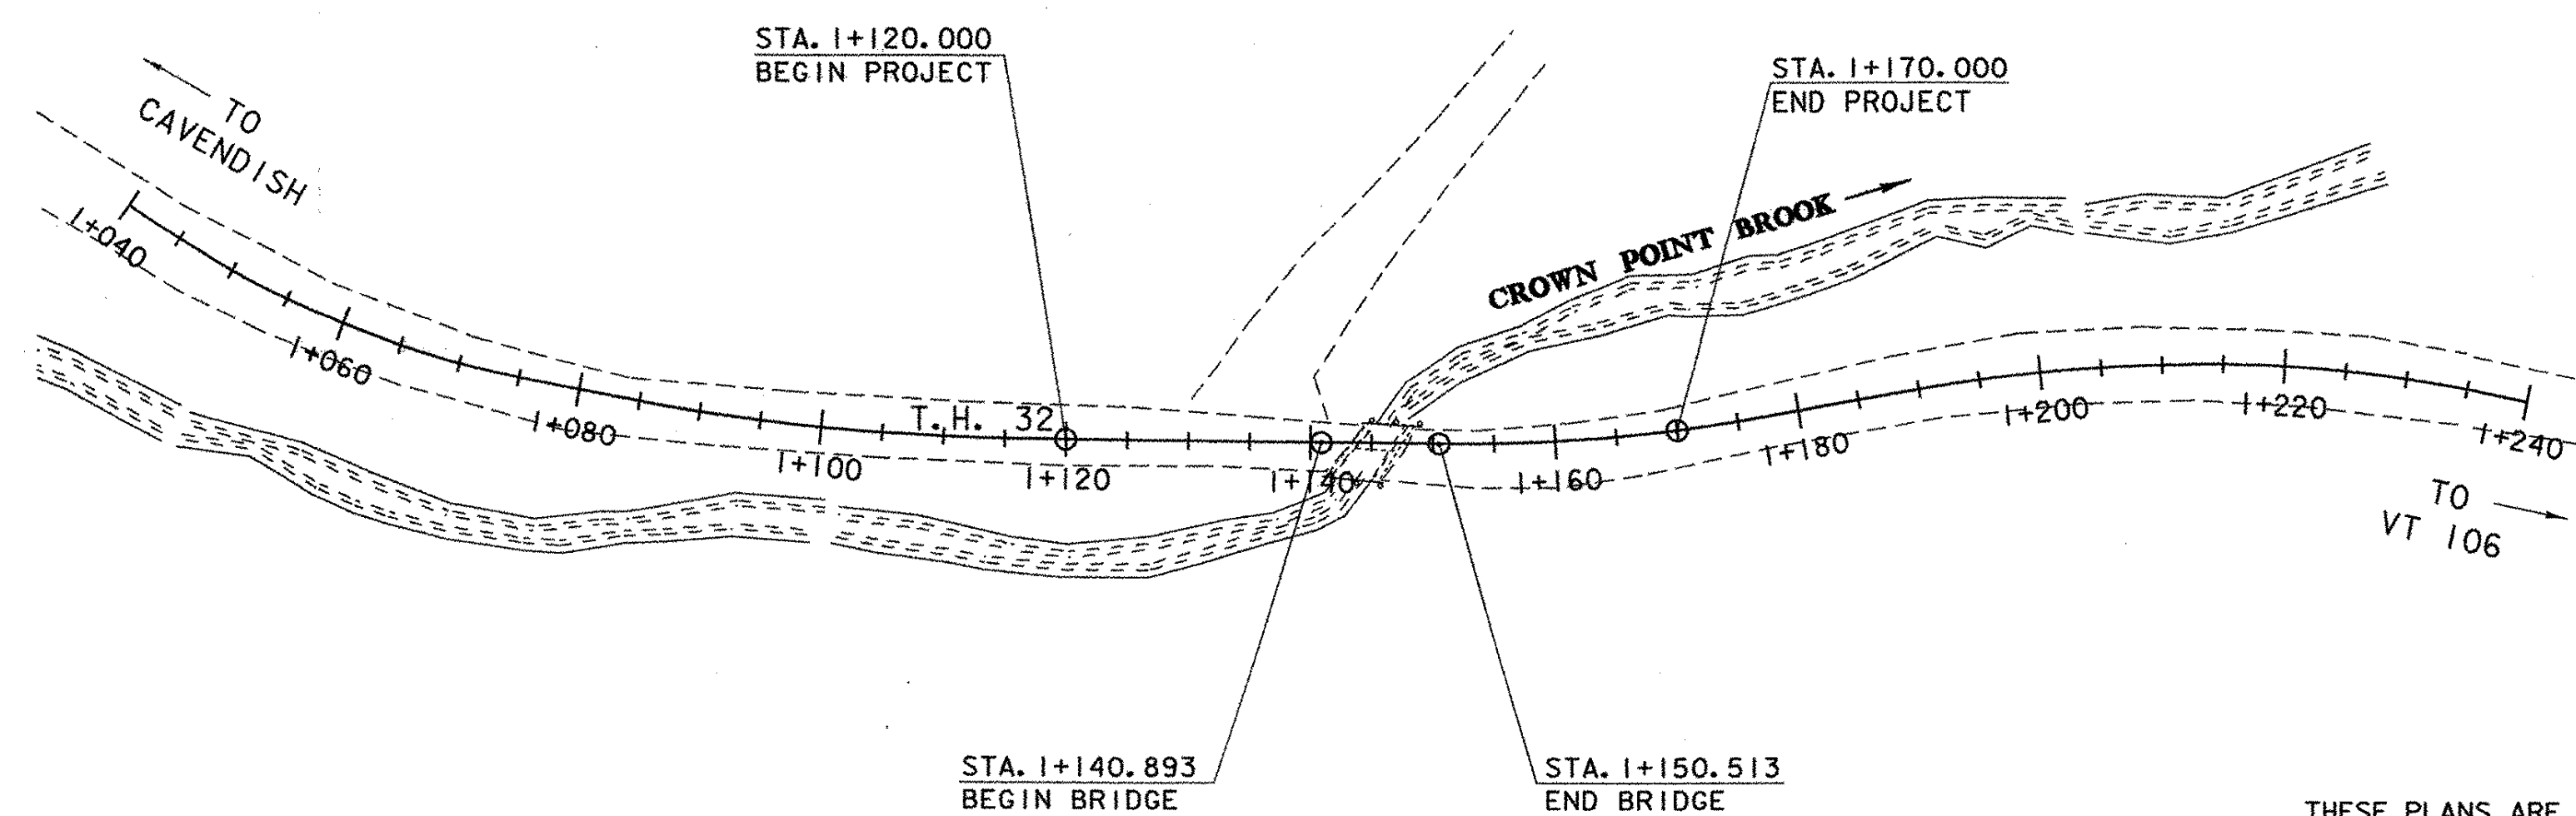

CONVENTIONAL SYMBOLS	
COUNTY LINE	
TOWN LINE	
LIMITS OF ACCESS	
POINT OF ACCESS	
FENCE LINE	
STONE WALL	
TRAVELED WAY	
GUARD RAIL	
RAILROAD	
SURVEY LINE	
CULVERT	
POWER POLE	
TELEPHONE POLE	
TREES	
CONTROL OF ACCESS	
PROPERTY LINE	
R.O.W. TAKING LINE	
SLOPE RIGHTS	
TOP OF CUT	
TOE OF SLOPE	

SURVEYED BY : R. GILMAN
SURVEYED DATE : 03/96

DATUM
VERTICAL NAVD 88
HORIZONTAL NAD 83 (92)

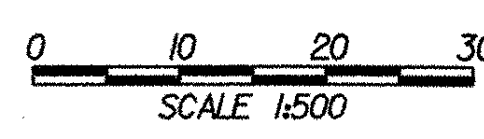

THESE PLANS ARE SUBJECT TO SUCH ENGINEERING CHANGES AS MAY BE REQUIRED BY THE FEDERAL HIGHWAY ADMINISTRATION OR THE DIRECTOR OF PROGRAM DEVELOPMENT.

CONSTRUCTION IS TO BE CARRIED ON IN ACCORDANCE WITH THESE PLANS AND THE STANDARD SPECIFICATIONS FOR CONSTRUCTION DATED 2001, AS APPROVED BY THE FEDERAL HIGHWAY ADMINISTRATION ON JANUARY 4, 2001 FOR USE ON THIS PROJECT, INCLUDING ALL SUBSEQUENT REVISIONS AND SUCH REVISED SPECIFICATIONS AND SPECIAL PROVISIONS AS ARE INCORPORATED IN THESE PLANS.

Metric

UNLESS NOTED OTHERWISE
STATIONS ARE IN KILOMETERS
ELEVATIONS ARE IN METERS
DIMENSIONS ARE IN MILLIMETERS

DIRECTOR OF PROGRAM DEVELOPMENT	
APPROVED <i>[Signature]</i>	DATE 2/10/04
PROJECT MANAGER : ROGER R. WHITCOMB	
PROJECT NAME : WEATHERSFIELD	
PROJECT NUMBER : TH3 9514	
SHEET 1 OF 31 SHEETS	