

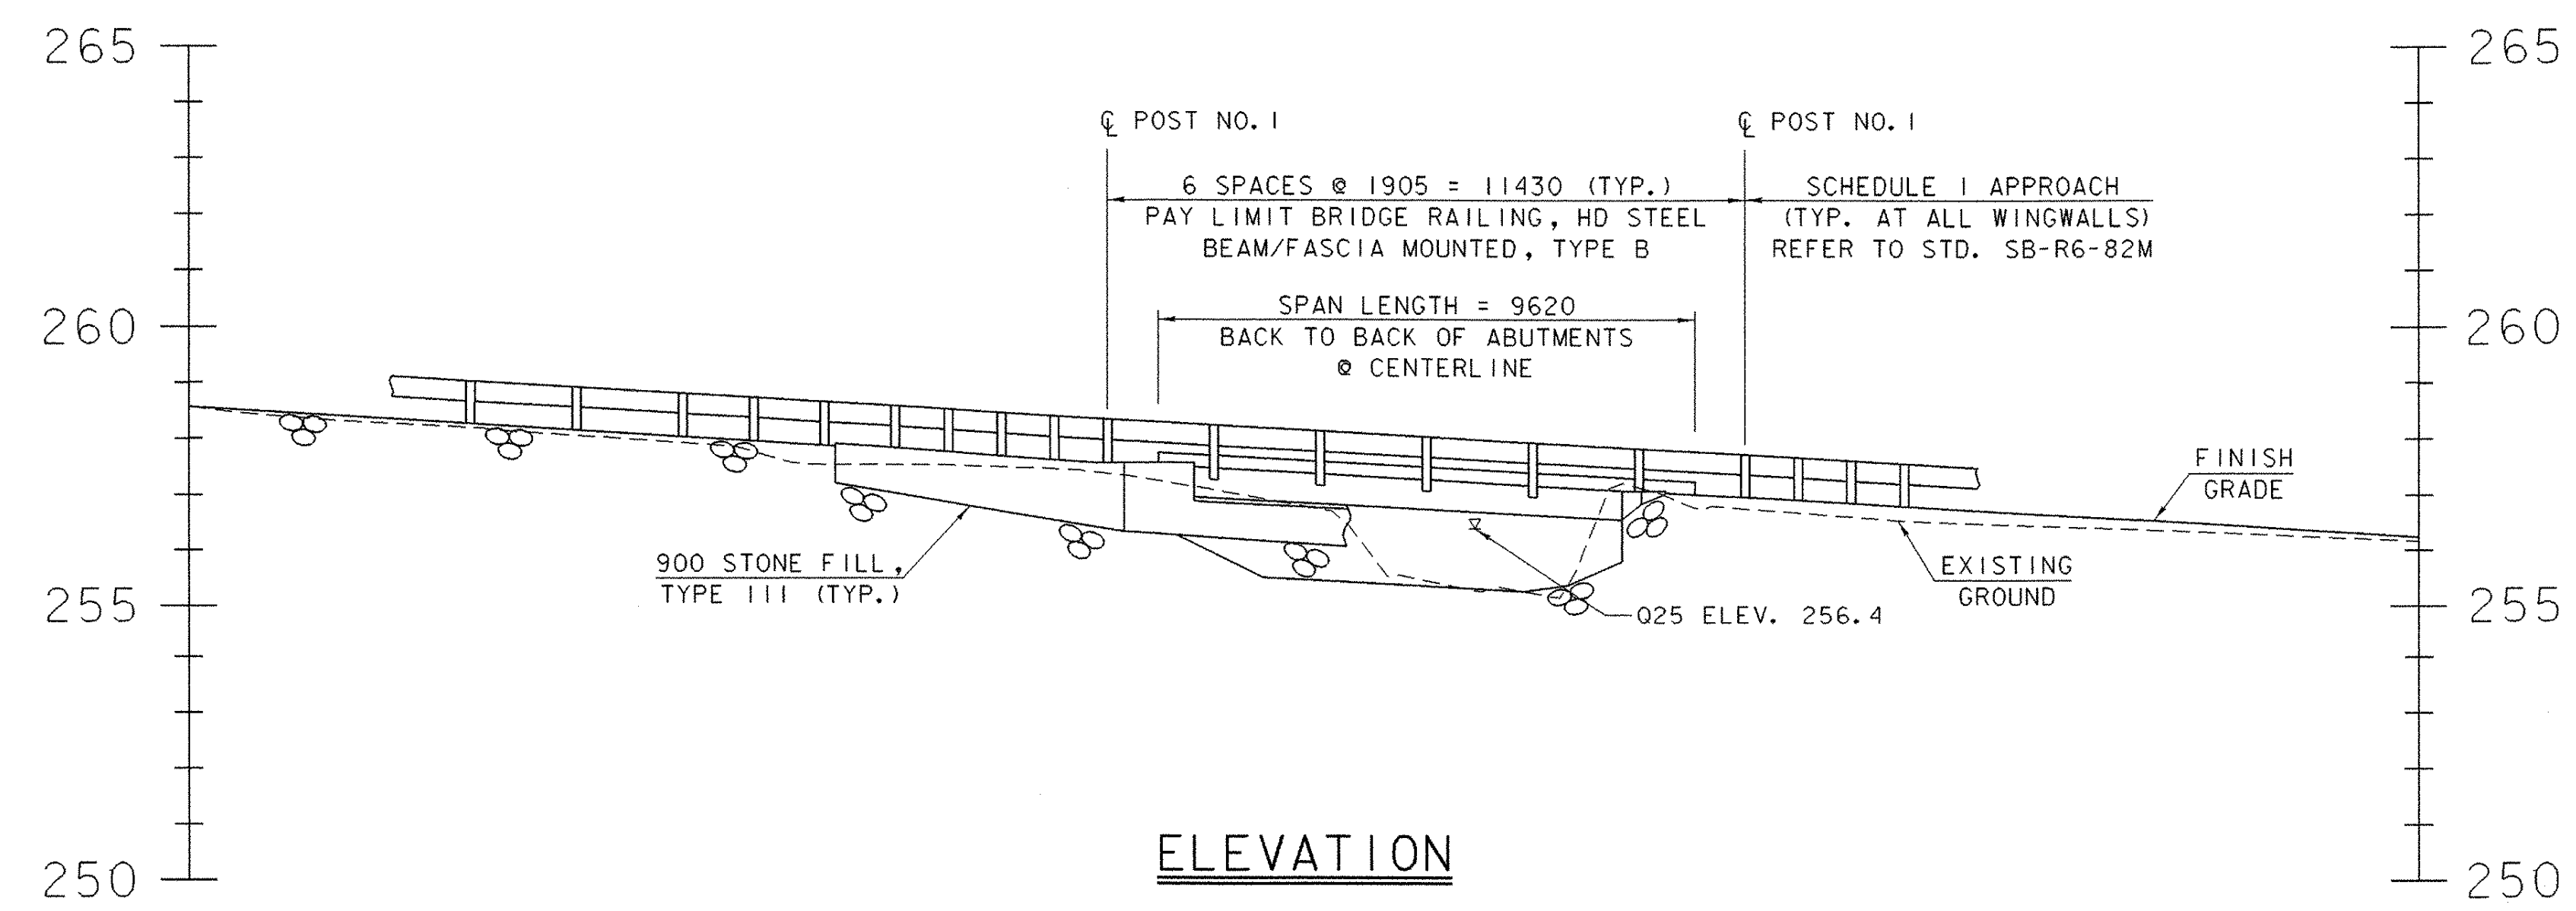


PLAN

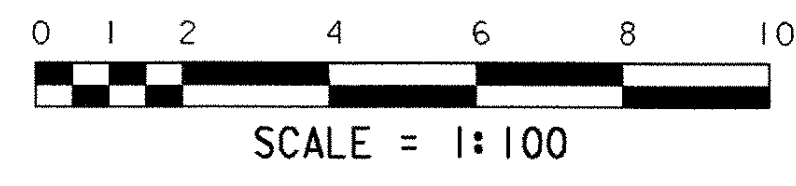

ELEVATION

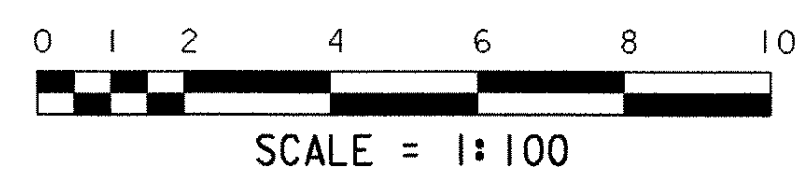

PROJECT NAME: WEATHERSFIELD	
PROJECT NUMBER: TH3 9514	
FILE NAME: /str3/95J284/sj284pe.i	PLOT DATE: 12-FEB-2004
PROJECT LEADER: R. WHITCOMB	DRAWN BY: J. LACROIX
DESIGNED BY: J. LACROIX	CHECKED BY: J. LACROIX
PLAN AND ELEVATION SHEET	SHEET 12 OF 31