


EXISTING BRIDGE DATA

CONCRETE SLAB DECK SUPPORTED BY
 CONCRETE FACED LAID-UP STONE ABUTMENTS
 BRIDGE LENGTH: 4.1m
 BRIDGE WIDTH: 4.5m

LEGEND

- WETLAND RESOURCE
- ARCHAEOLOGICAL RESOURCE
- CRITICAL HABITAT
- - - - ORDINARY HIGH WATER LINE

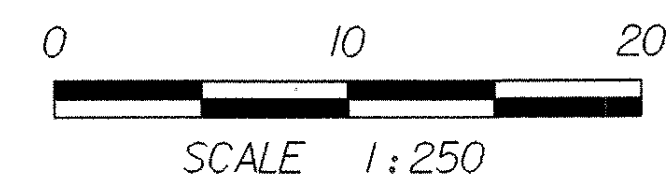

PROJECT NAME: WEATHERSFIELD
 PROJECT NUMBER: TH3 9514

FILE NAME: /str3/95J284/sj285rsl
 PROJECT LEADER: R. WHITCOMB
 DESIGNED BY: T. SUMNER
 RESOURCE & EXISTING SITE CONDITION SHEET

PLOT DATE: 9/4/01
 DRAWN BY: J. LACROIX
 CHECKED BY: S. SCRIBNER
 SHEET 14 OF 31