



ABUTMENT NO. 1 PLAN

SCALE = 1:50

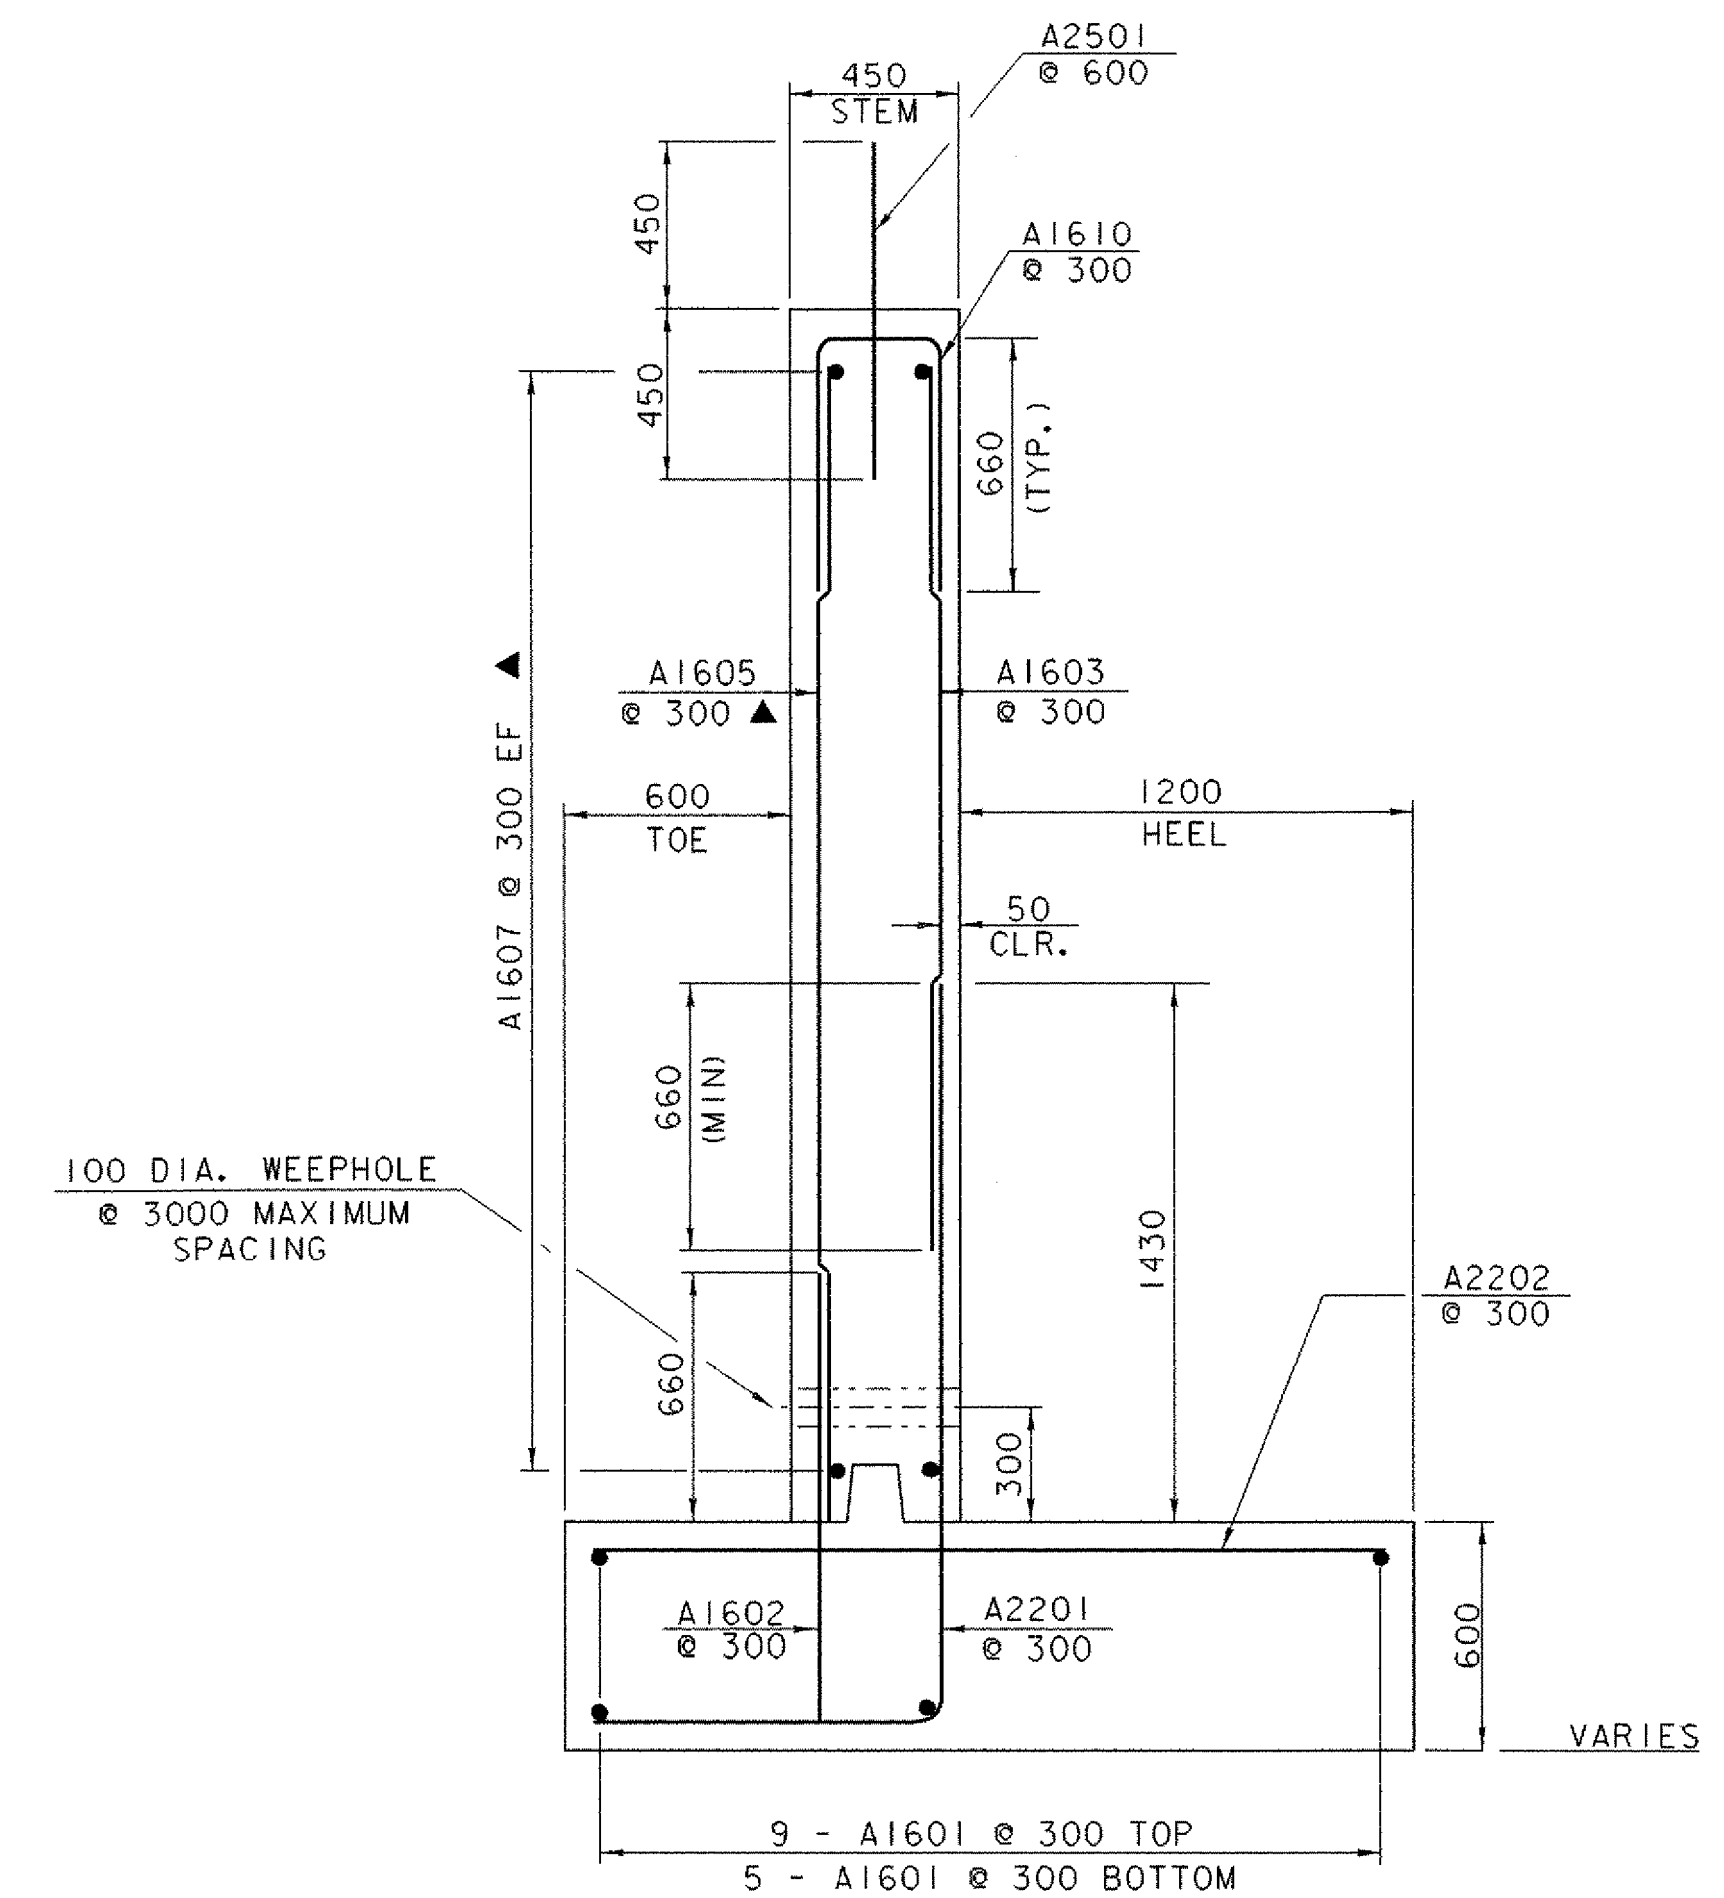

ABUTMENT TYPICAL

SCALE = 1:20

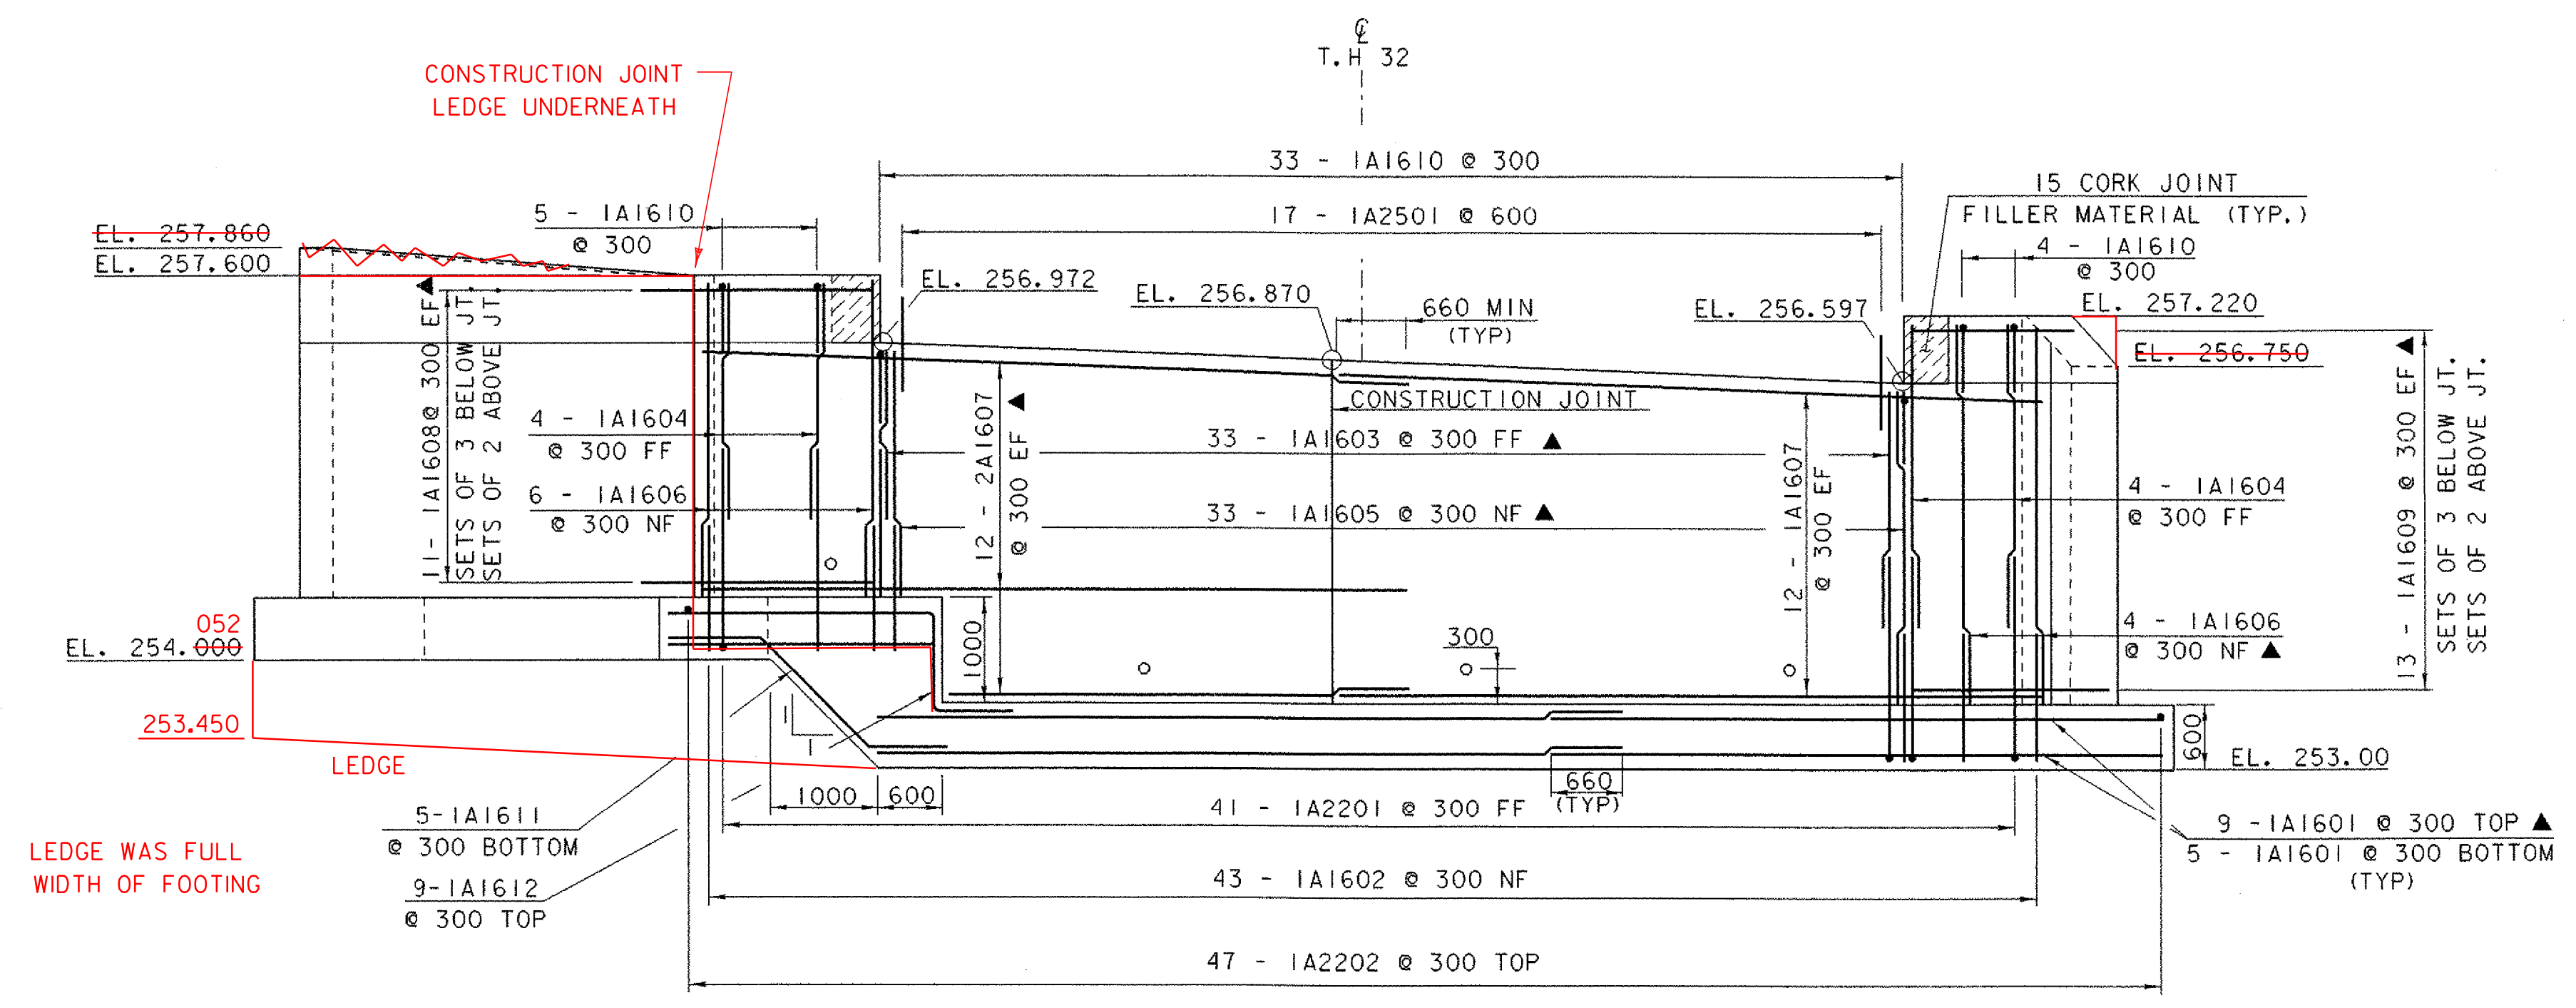

ABUTMENT NO. 1 ELEVATION

SCALE = 1:50

NOTE:

- NF = NEAR FACE
 - FF = FAR FACE
 - EF = EACH FACE
 - ▲ = CUT TO FIT IN FIELD
- 80 CLEAR UNLESS OTHERWISE SPECIFIED ON PLANS

STATE OF VERMONT AGENCY OF TRANSPORTATION	
Town of WEATHERSFIELD	Bridge No. 24
Highway No. T.H. 32	Log Sta. T.H. 32 OVER CROWN POINT BROOK
ABUTMENT NO. 1 DETAILS	
Designed By J. LACROIX	Drawn By J. LACROIX
Checked By T.A. SUMNER Date 9/10/01	Project Manager R. WHITCOMB Date 9/10/01
PROJECT WEATHERSFIELD	PROJECT NO. TH3 9514
I.G.C. Info. str3/951284/s1284abdgn	s1284abl1
Bridge Sheet No.	Sheet 18 of 31