



MATERIAL TRANSITION DETAIL

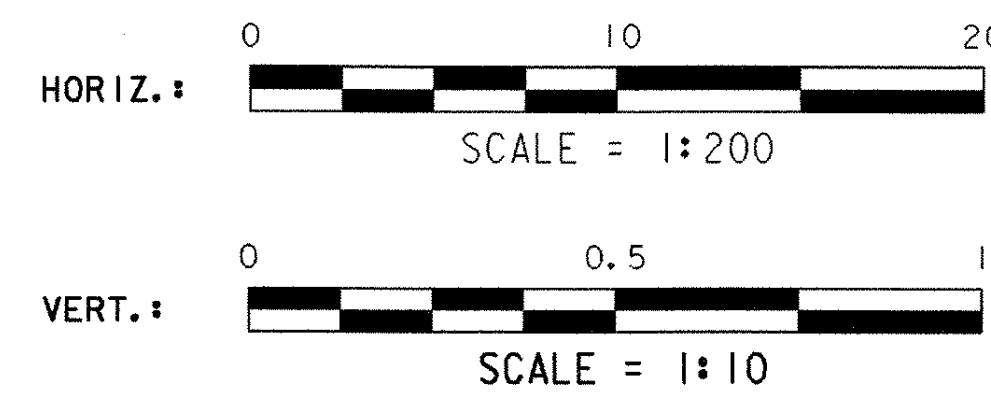


NOTES:

1. SEE ROADWAY CROSS SECTIONS TO DETERMINE CUT OR FILL.
2. SEE PROJECT TYPICAL SECTIONS SHEET FOR ADDITIONAL ABUTMENT EARTHWORK DETAILS.

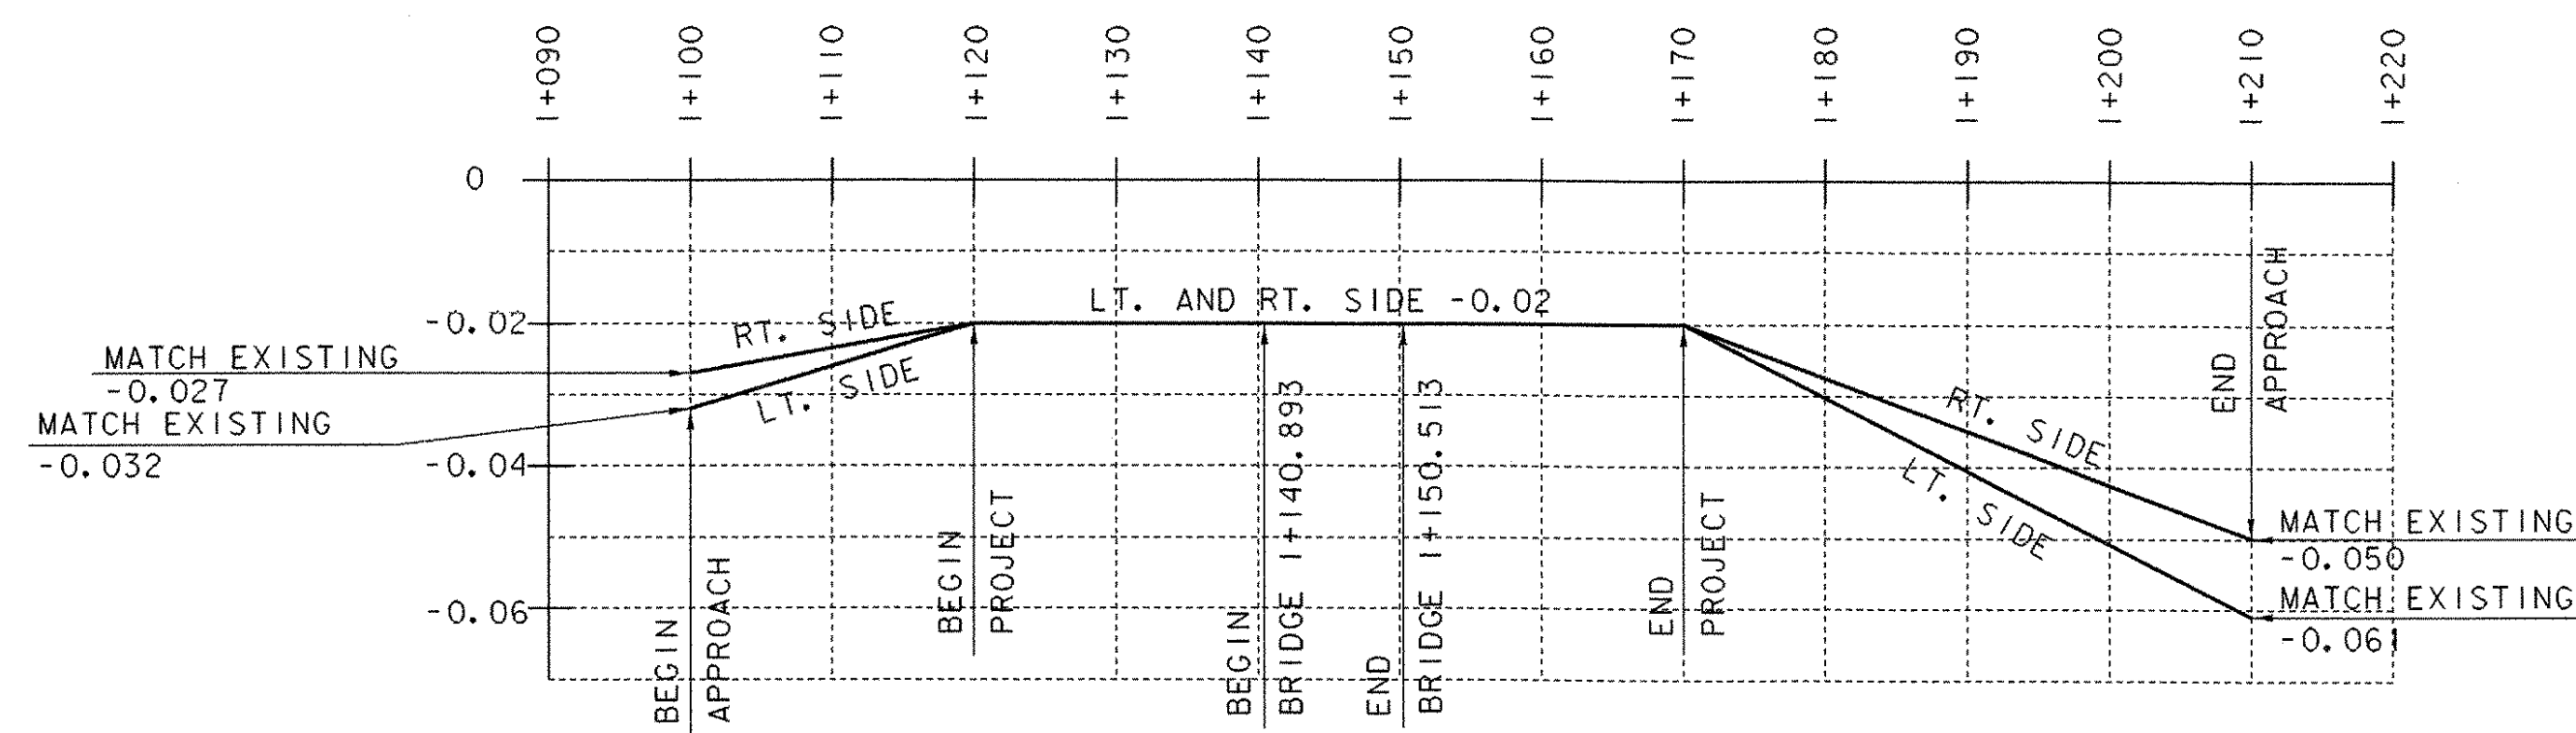

BANKING TRANSITION DETAIL

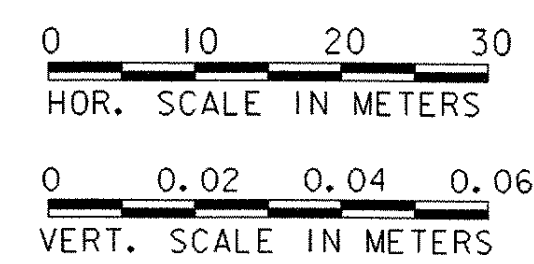

PROJECT NAME: WEATHERSFIELD
 PROJECT NUMBER: TH3 9514

FILE NAME: /s/r3/95j284/sj284mat.1
 PROJECT LEADER: R. WHITCOMB
 DESIGNED BY: J. LACROIX
 MATERIAL TRANSITION DETAILS

PLOT DATE: 8/31/01
 DRAWN BY: J. LACROIX
 CHECKED BY: S. SCRIBNER
 SHEET 23 OF 31