
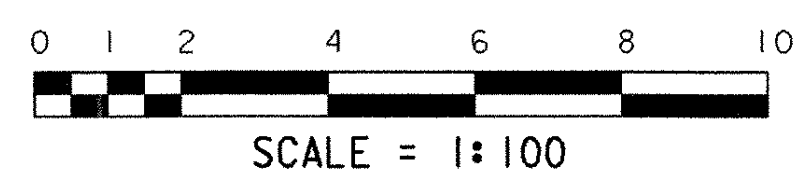
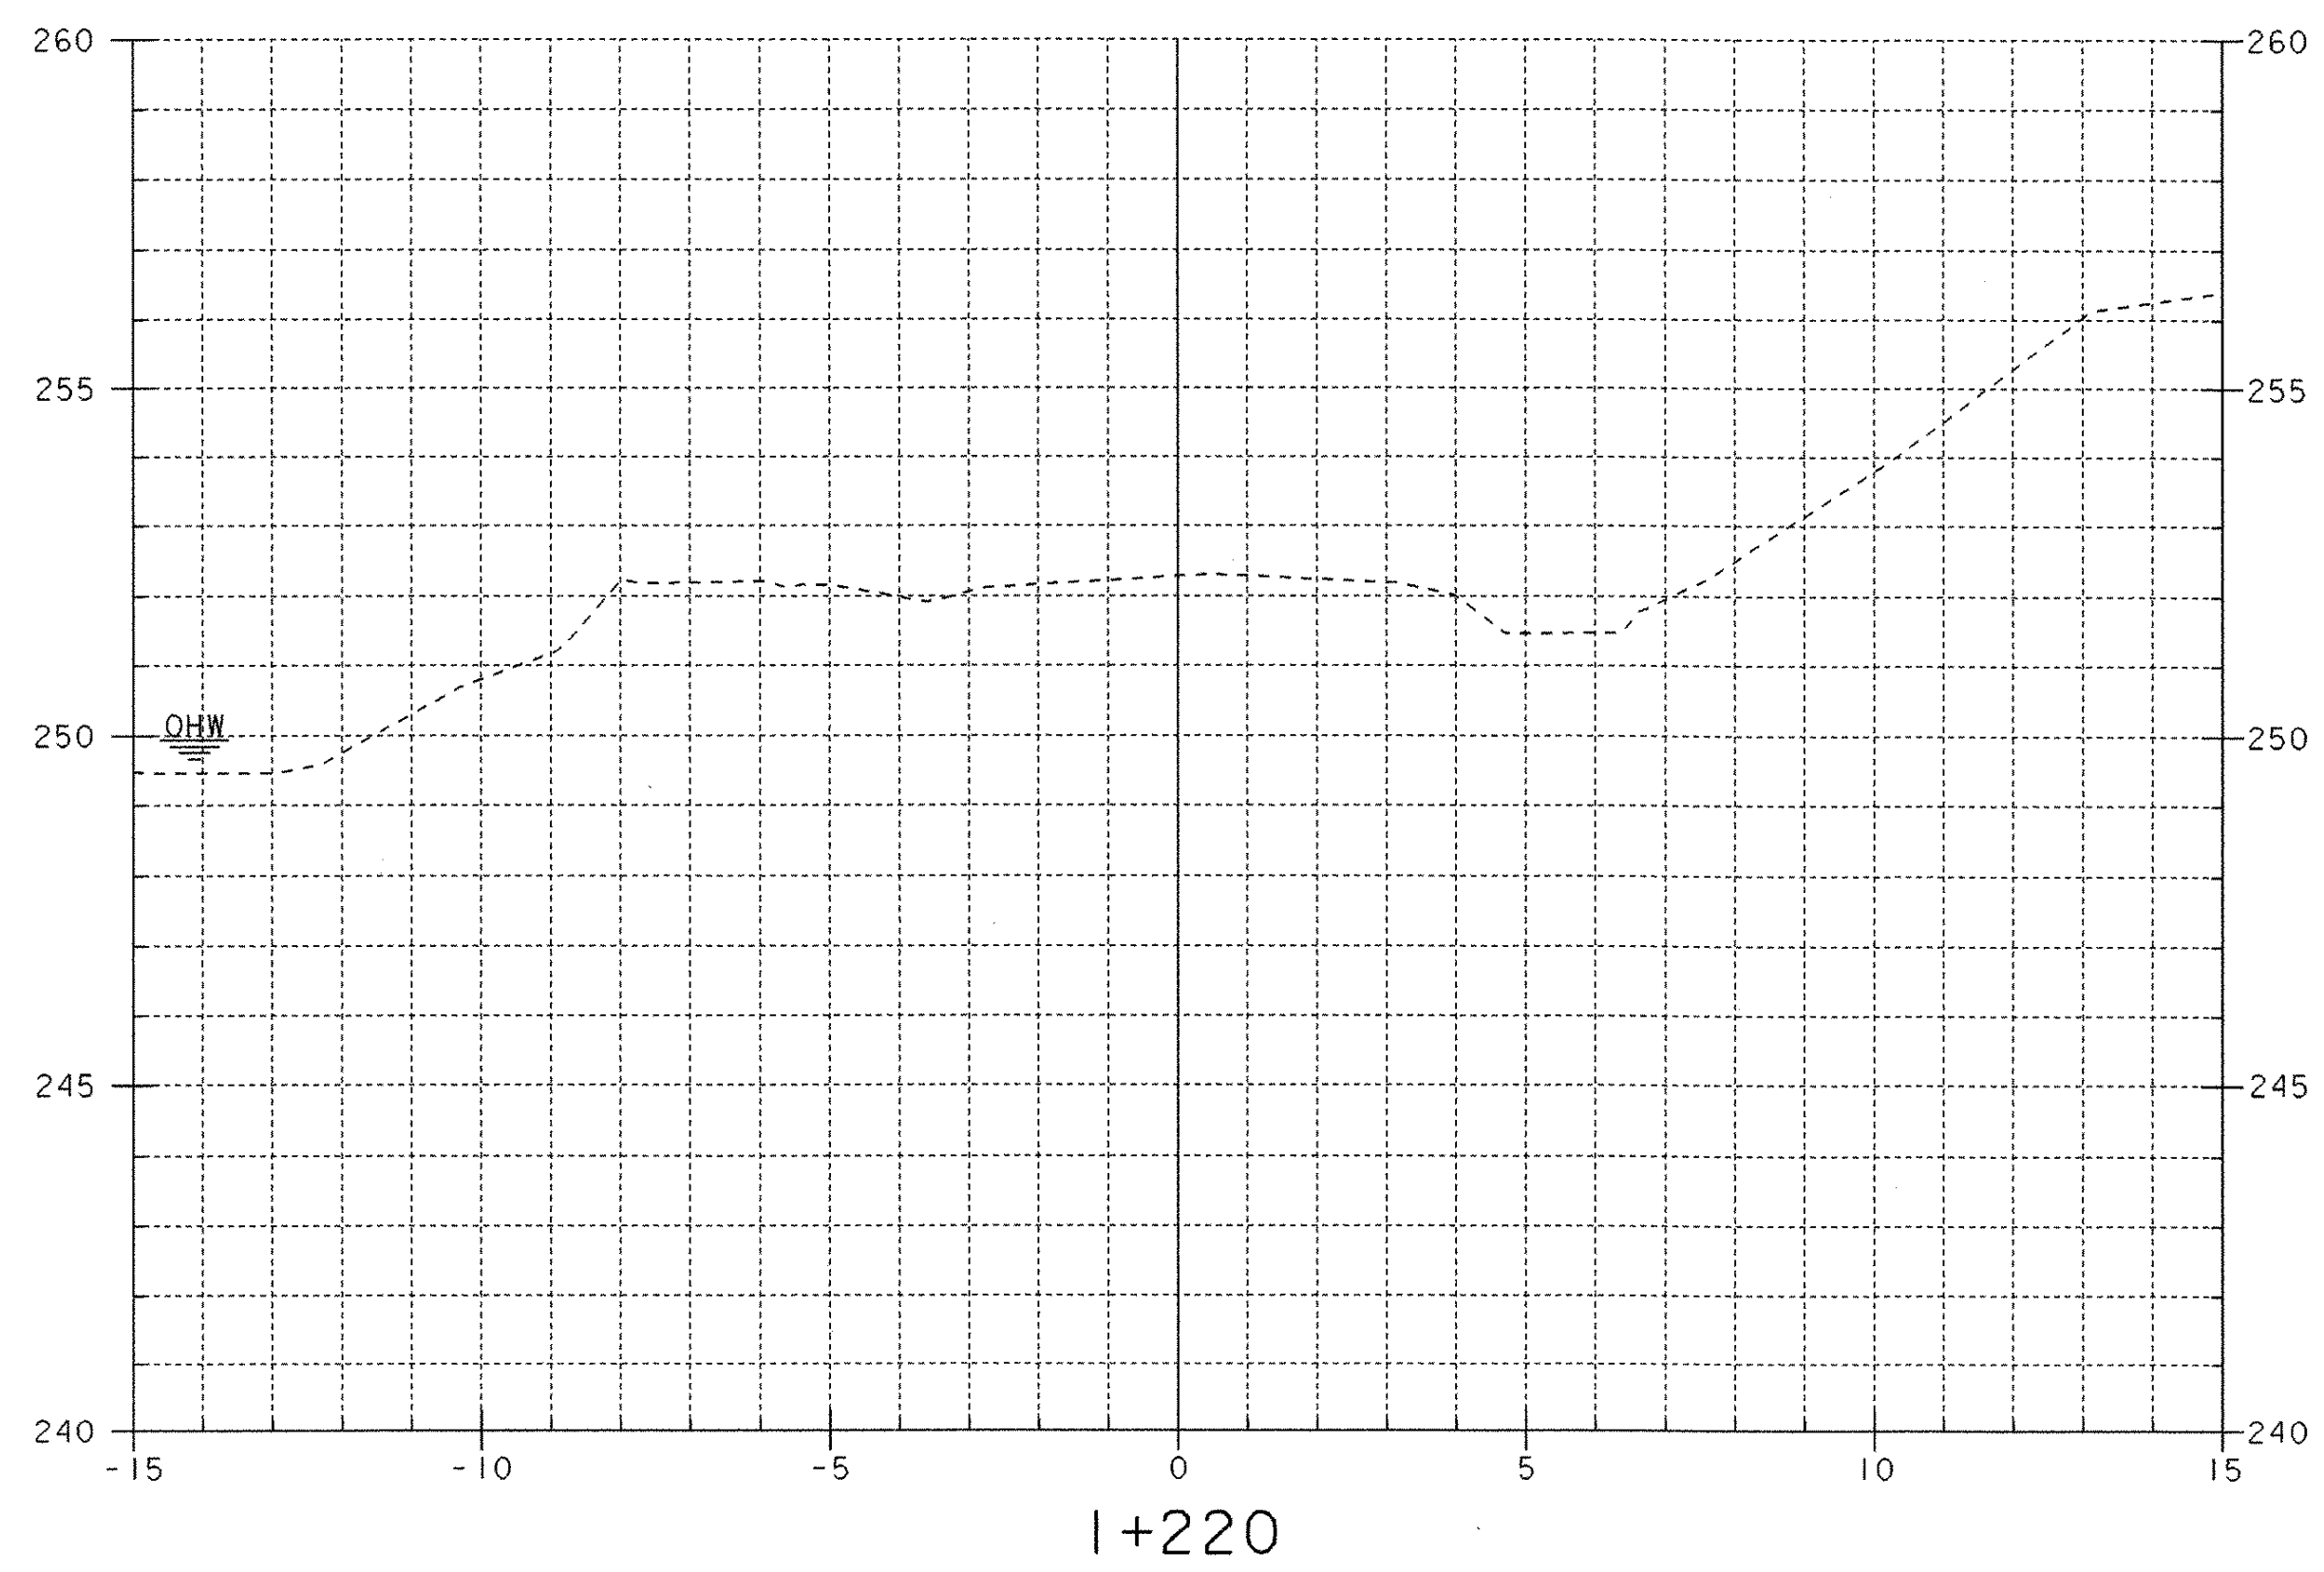


CULVERT CROSS PROFILE  
STA. I+129.94 LT. - STA. I+147.59 LT.

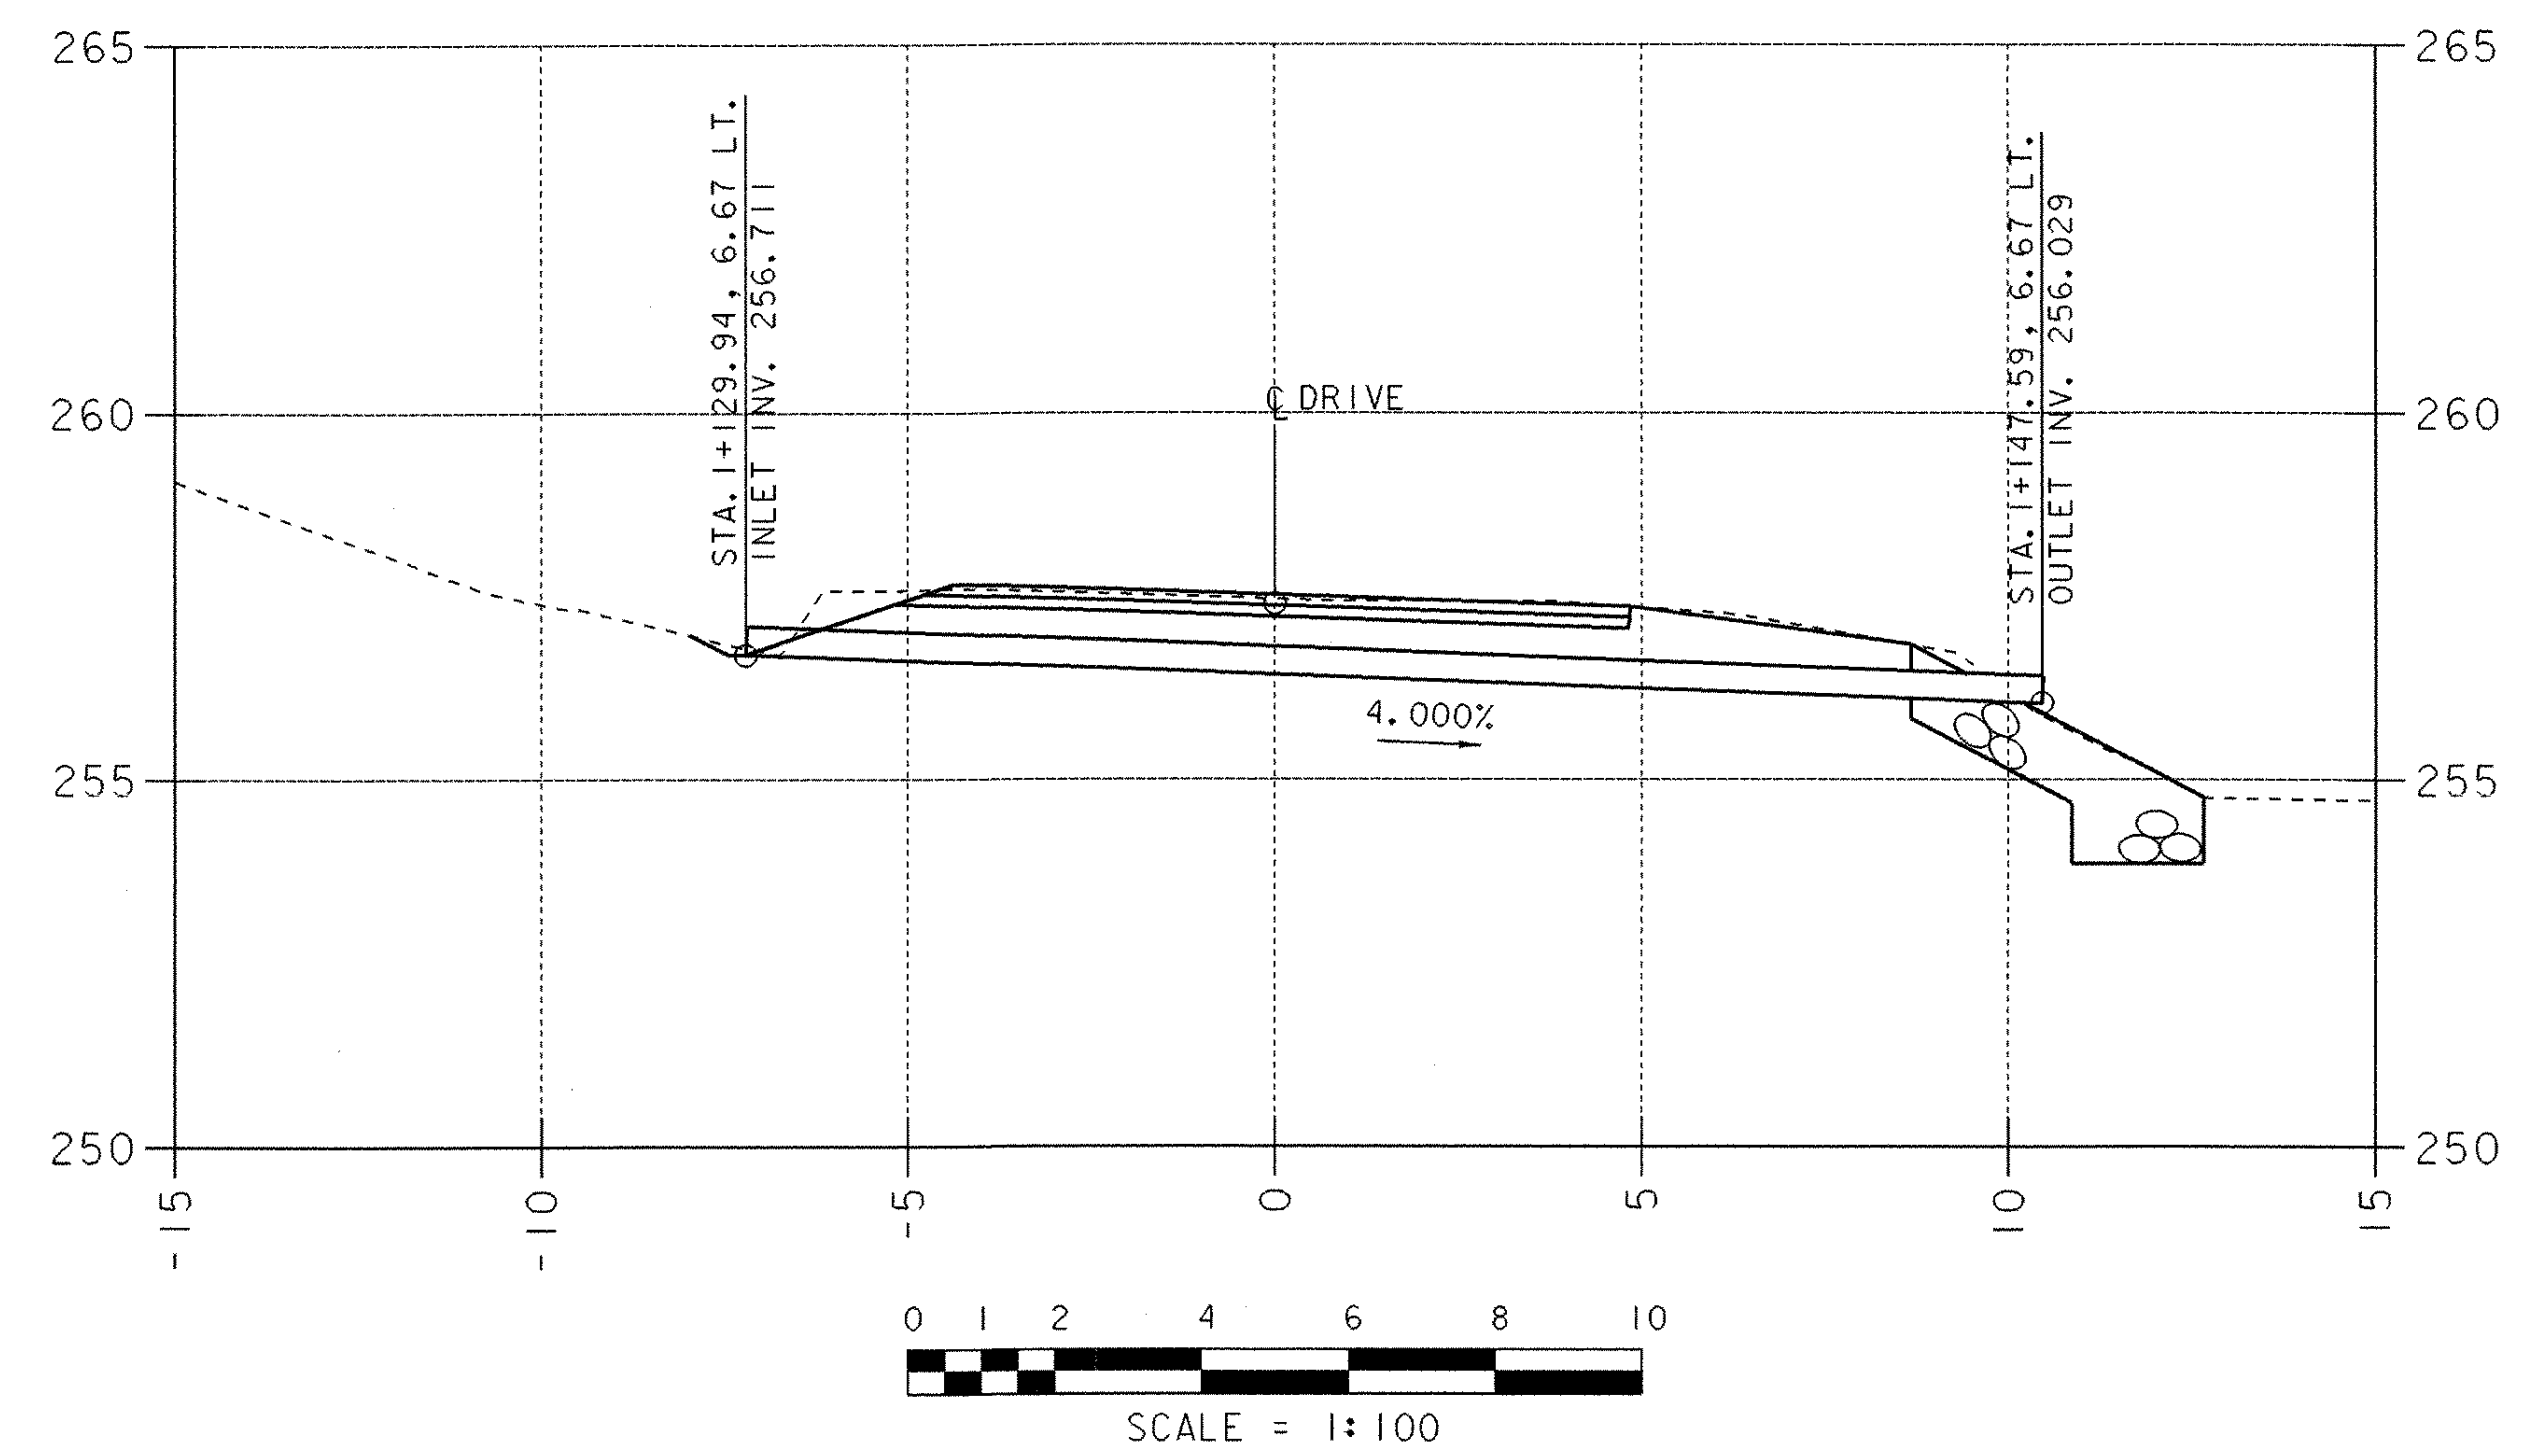

PROJECT NAME:	WEATHERSFIELD
PROJECT NUMBER:	TH3 9514
FILE NAME:	/s/r3/95j284/sj284m05.i
PROJECT LEADER:	R. WHITCOMB
DESIGNED BY:	J. LACROIX
ROADWAY CROSS SECTION	
PLOT DATE:	8/31/01
DRAWN BY:	J. LACROIX
CHECKED BY:	S. SCRIBNER
SHEET	28 OF 31