


STA. 5+006.8 LT.
 BEGIN UNCLASS. CHANNEL EXCAVATION
 GEOTEXTILE UNDER STONE FILL
 STONE FILL, TYPE III
 GRUBBING MATERIAL

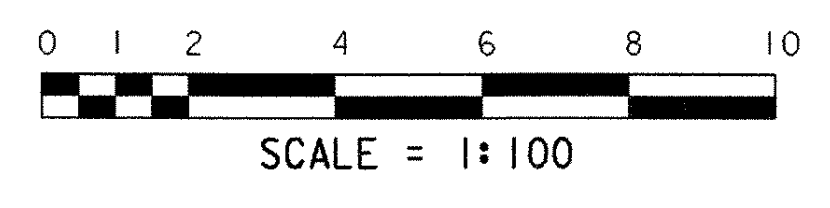

PROJECT NAME: WEATHERSFIELD	PLOT DATE: 8/31/01
PROJECT NUMBER: TH3 9514	DRAWN BY: J. LACROIX
FILE NAME: /s+r3/95j284/sj284c01.f	CHECKED BY: S. SCRIBNER
PROJECT LEADER: R. WHITCOMB	SHEET 29 OF 31
DESIGNED BY: J. LACROIX	
CHANNEL CROSS SECTION	