


STA. 5+026.9 RT.
 BEGIN UNCLASS. CHANNEL EXCAVATION
 GEOTEXTILE UNDER STONE FILL
 STONE FILL, TYPE III
 GRUBBING MATERIAL

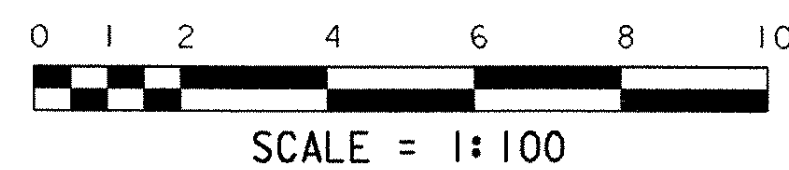

PROJECT NAME: WEATHERSFIELD
 PROJECT NUMBER: TH3 9514

FILE NAME: /str3/95J284/sj284c02.1
 PROJECT LEADER: R. WHITCOMB
 DESIGNED BY: J. LACROIX
 CHANNEL CROSS SECTION

PLOT DATE: 8/31/01
 DRAWN BY: J. LACROIX
 CHECKED BY: S. SCRIBNER
 SHEET 30 OF 31