


Profile

NOTE:

GRADES SHOWN TO THE NEAREST HUNDRETH ARE THE OLD GROUND ALONG THE CENTERLINE. GRADES SHOWN TO THE NEAREST THOUSANDTH ARE THE PROPOSED FINISHED GRADE ALONG THE CENTERLINE.

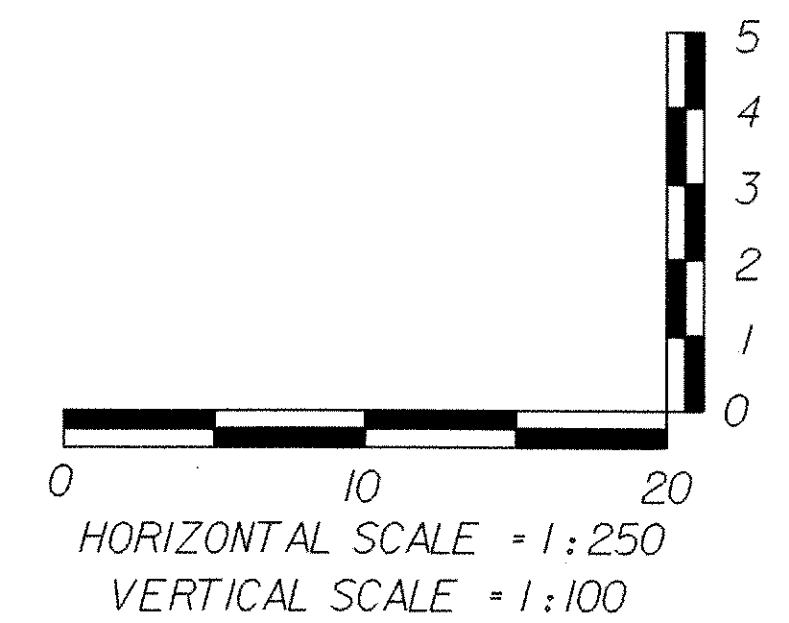

SHEET NAME: MAINLINE PROFILE	
PROJECT NAME: CLARENDON	HIGHWAY NO.: TH 16
PROJECT NUMBER: BRO 1443(34)	BRIDGE NO.: 24
	OVER: CLARENDON RIVER
FILE NAME: /PW/95j286/sj286xsl.dgn	PLOT DATE: 01-DEC-2005
PROJECT MANAGER: R. WHITCOMB	DRAWN BY: STRI
DESIGNED BY: C. CARLSON	IPARM NAME: sj286pl.i
BRIDGE SHEET NUMBER:	SHEET 10 OF 43