


LEGEND	
	WETLANDS
	RIPARIAN BUFFER

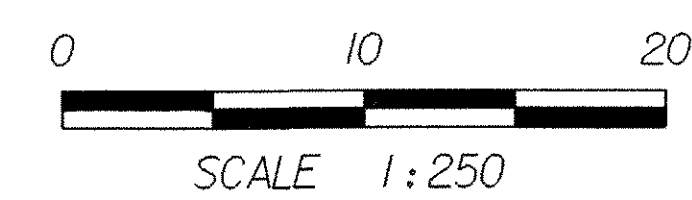

SHEET NAME:	FINAL CONDITIONS SITE PLAN	
PROJECT NAME:	CLARENDON	HIGHWAY NO.: TH 16
PROJECT NUMBER:	BRO 1443(34)	BRIDGE NO.: 24
		OVER: CLARENDON RIVER
FILE NAME:	/PW/951286/sj286ec.dgn	PLOT DATE: 01-DEC-2005
PROJECT MANAGER:	R.R. WHITCOMB	DRAWN BY: J. PERRIGO
DESIGNED BY:	C. CARLSON	IPARM NAME: sj286ec3.i
BRIDGE SHEET NUMBER:		SHEET 20 OF 43