



2 1/4 R
VC-812
COLORS:
BLACK BORDER AND TEXT NON (REFL.)
YELLOW BACKGROUND (REFL.)

REMOVING SIGNS
(LEGAL LOAD LIMIT 3 TONS) BEFORE PROJECT RT
(LEGAL LOAD LIMIT 3 TONS) STA 1+078.035 LT

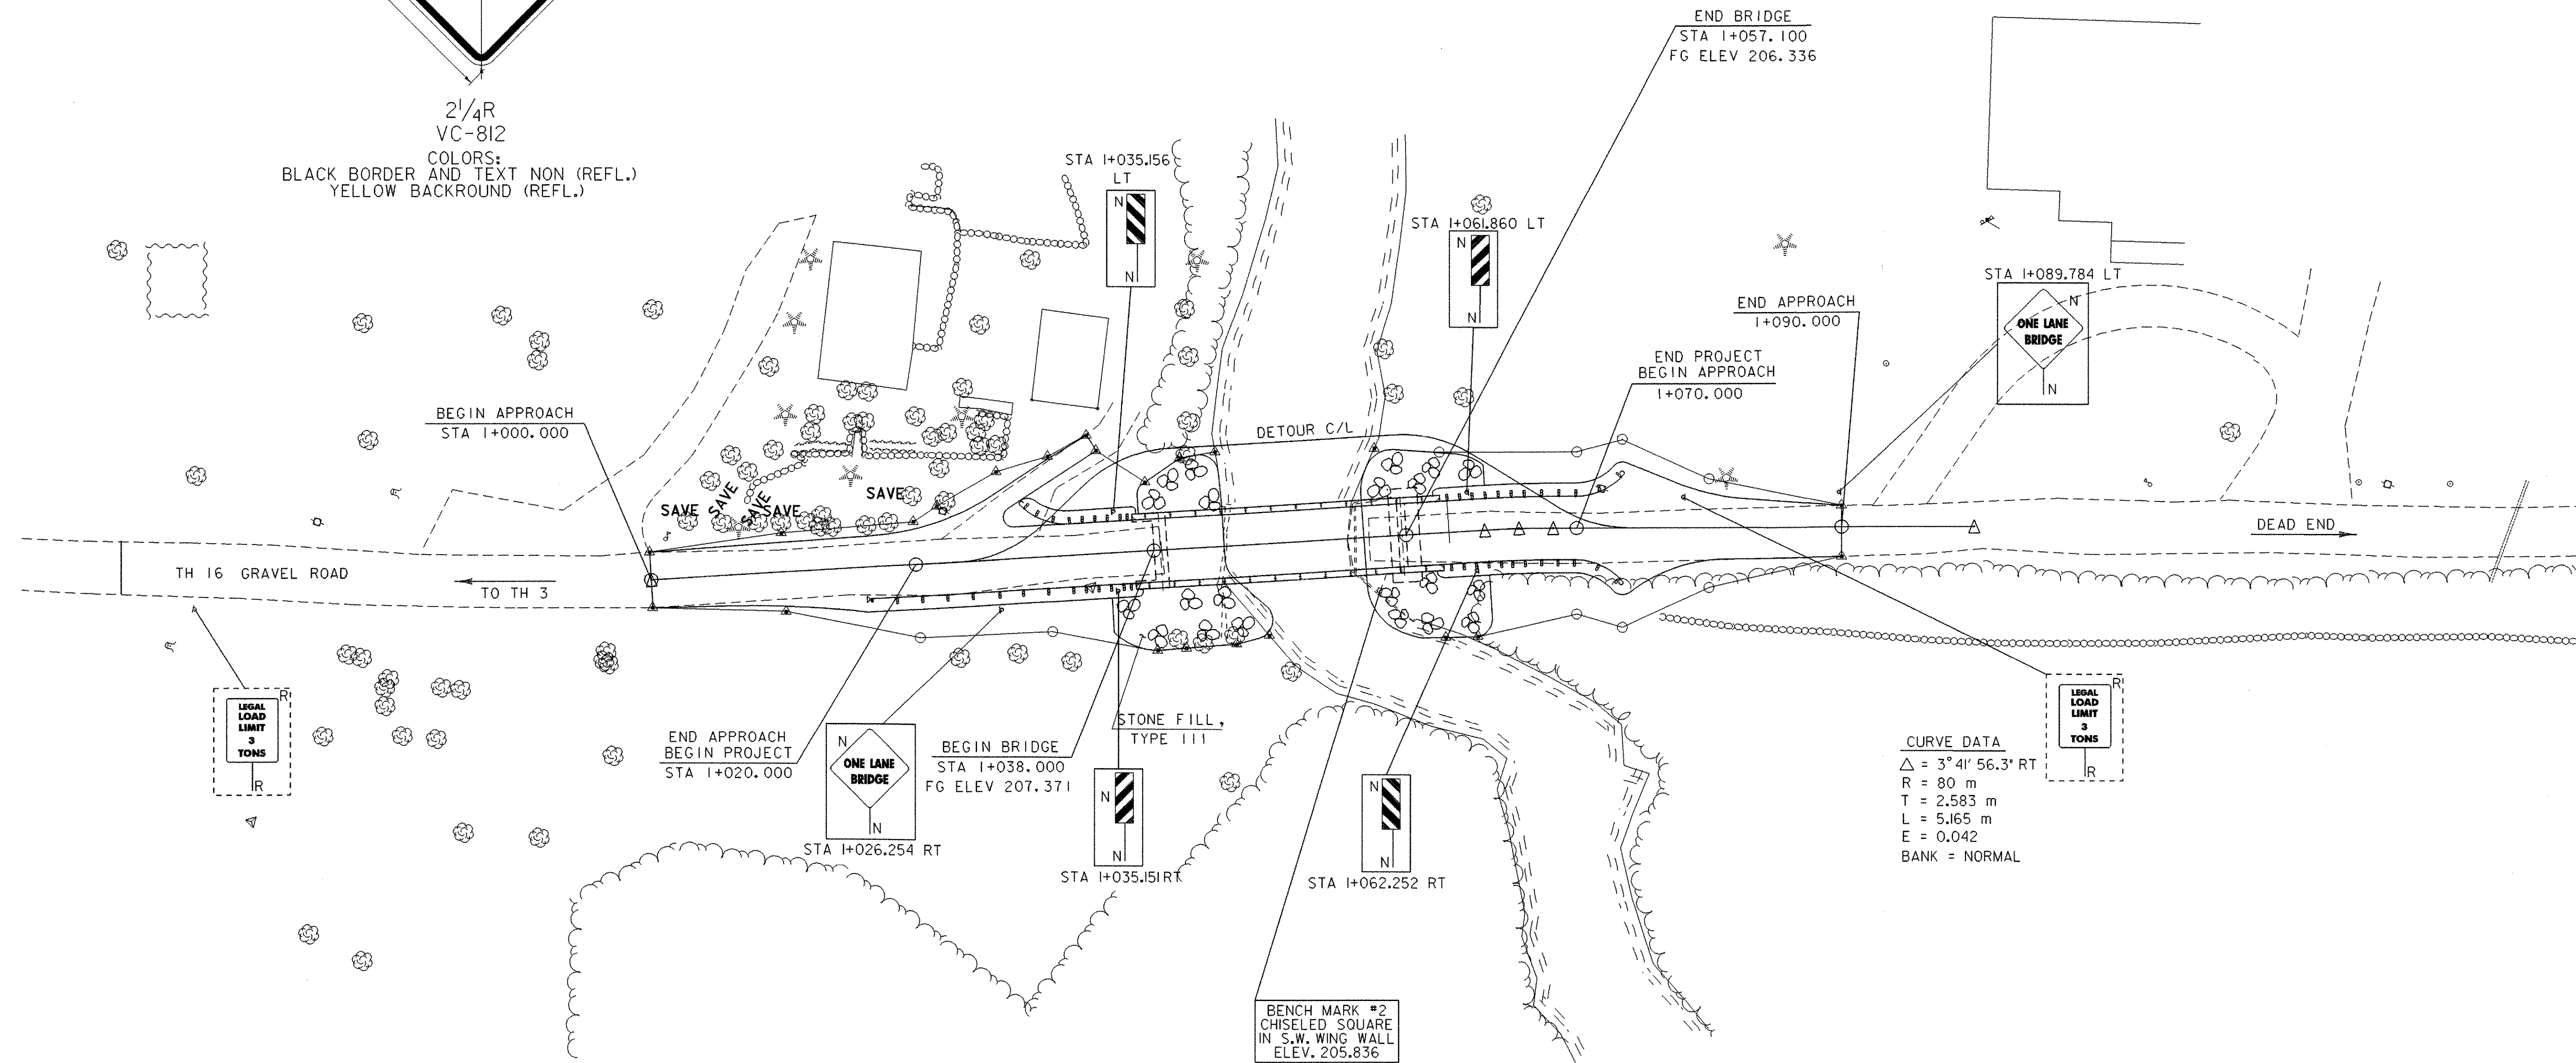

CURVE DATA
Δ = 3° 41' 56.3" RT
R = 80 m
T = 2.583 m
L = 5.165 m
E = 0.042
BANK = NORMAL

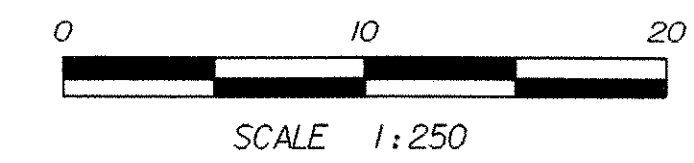

SIGN LEGEND

- R - REMOVE
- N - NEW
- - NEW
- - EXISTING

SHEET NAME: SIGN LAYOUT SHEET	
PROJECT NAME: CLARENDON	HIGHWAY NO.: TH 16
PROJECT NUMBER: BRO 1443(34)	BRIDGE NO.: 24
	OVER: CLARENDON RIVER
FILE NAME: /PW/95J286/sj286sgn.dgn	PLOT DATE: 01-DEC-2005
PROJECT MANAGER: R. WHITCOMB	DRAWN BY: J. GILMORE
DESIGNED BY: C. CARLSON	IPARM NAME: sj286sls.l
BRIDGE SHEET NUMBER:	SHEET 34 OF 43