

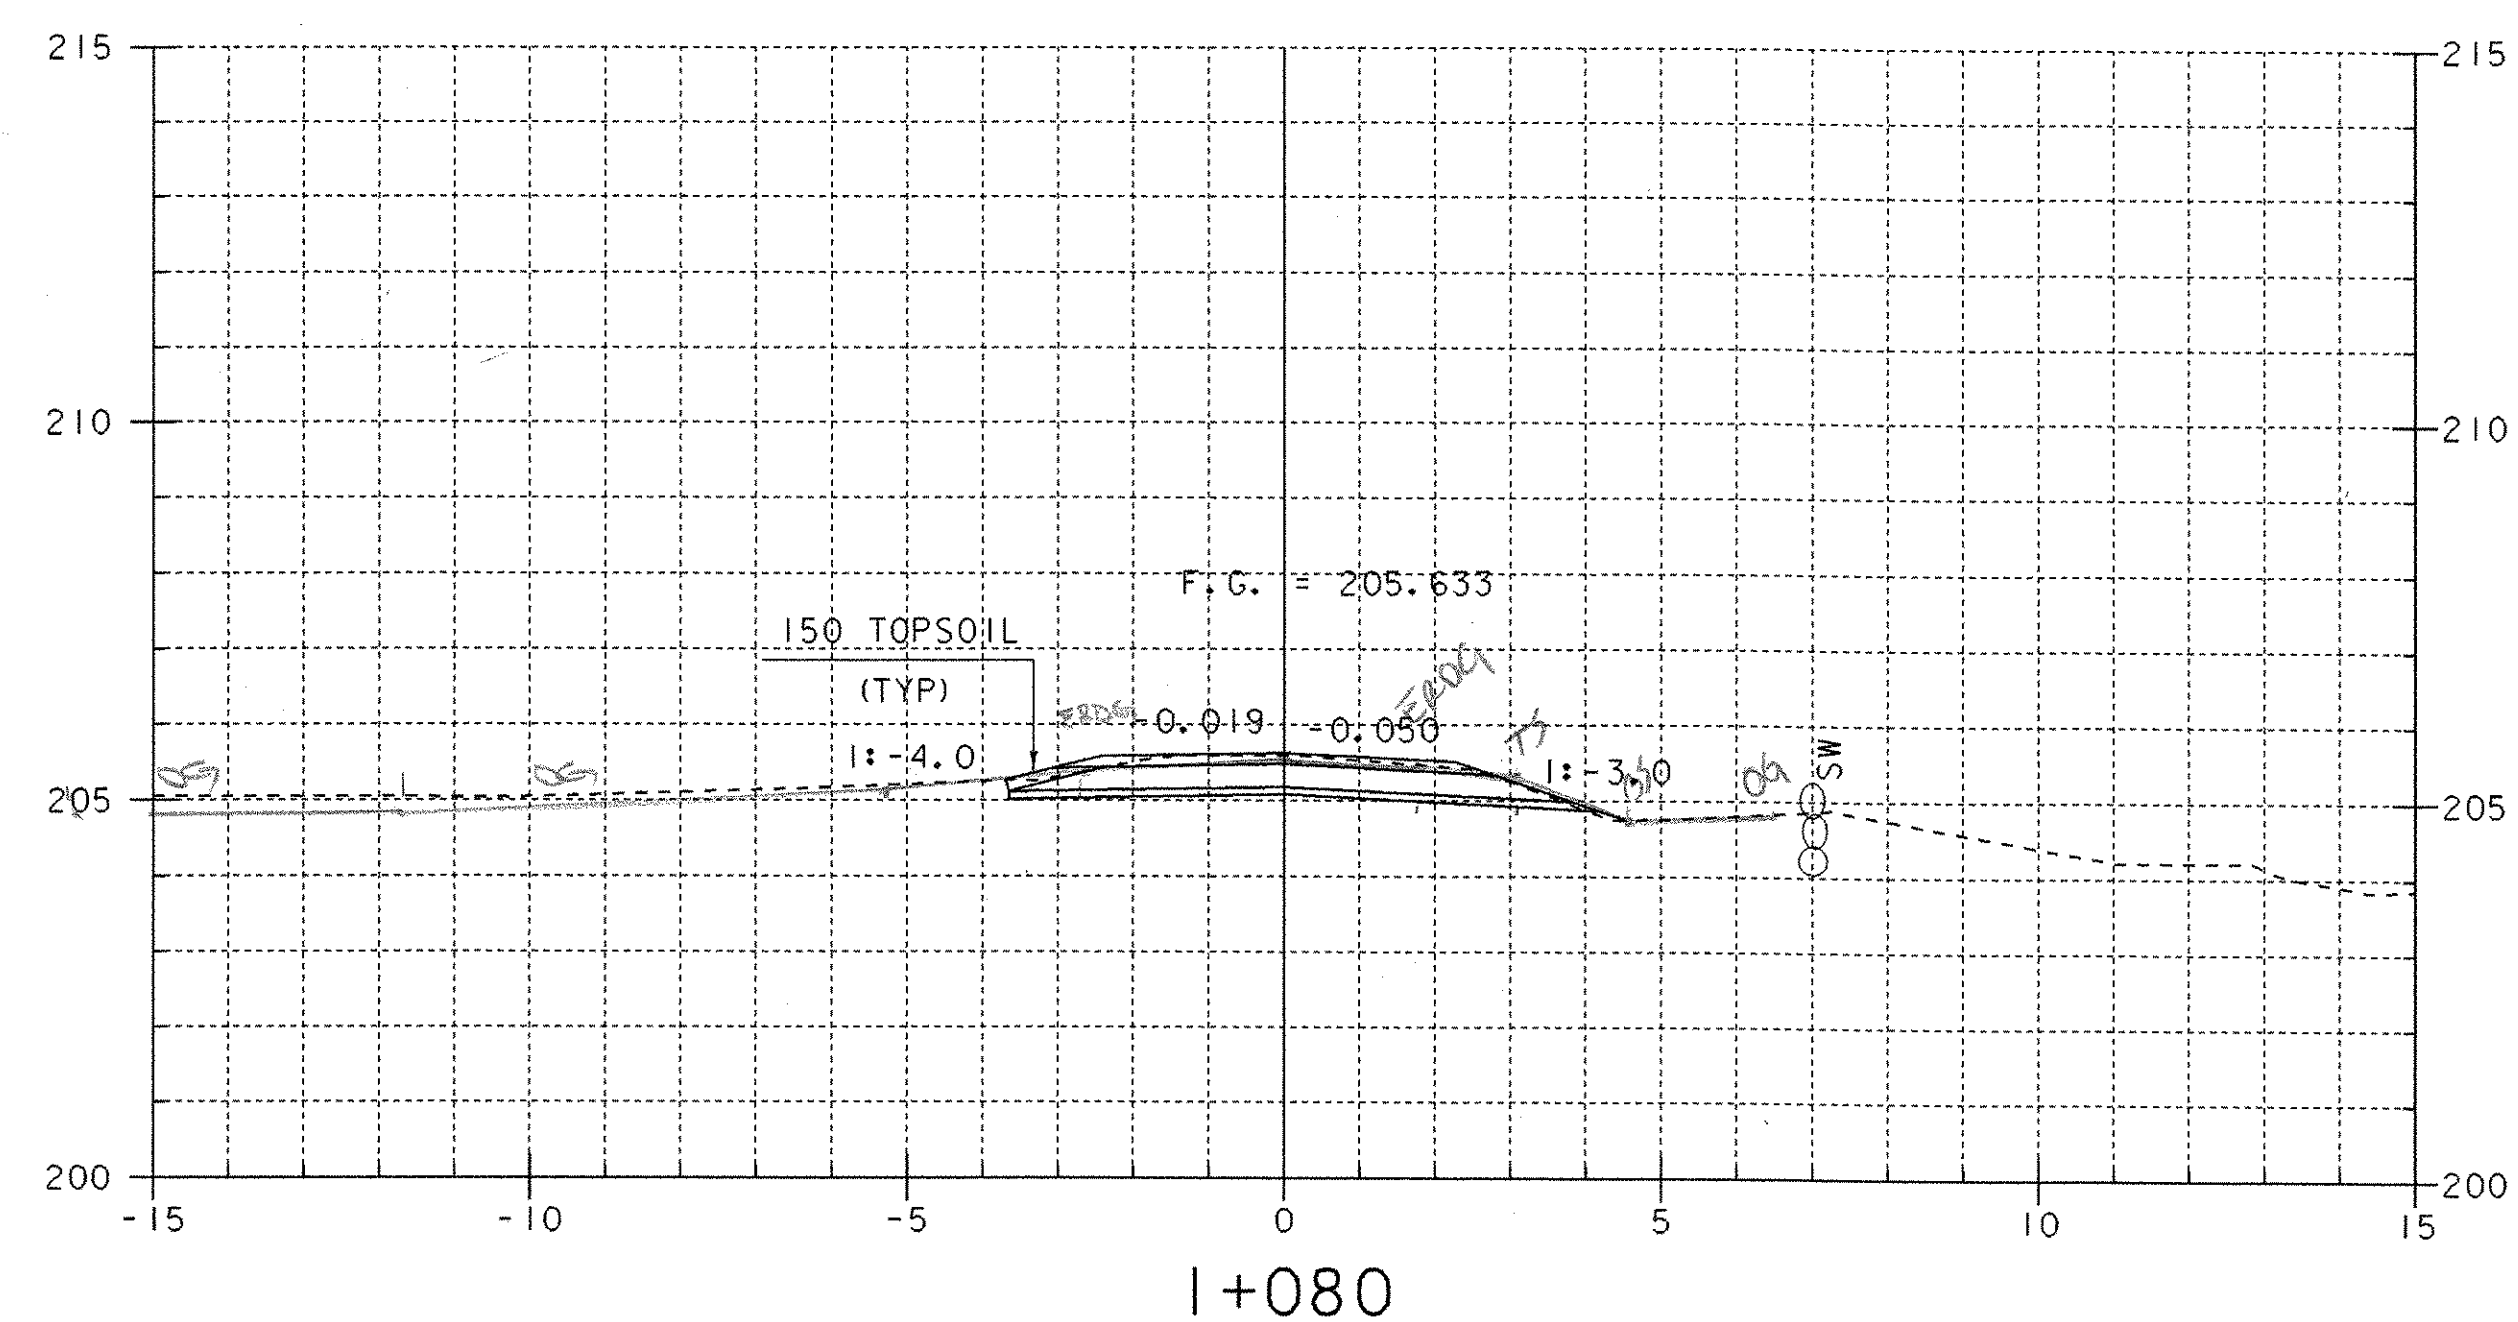


I+090
END APPROACH

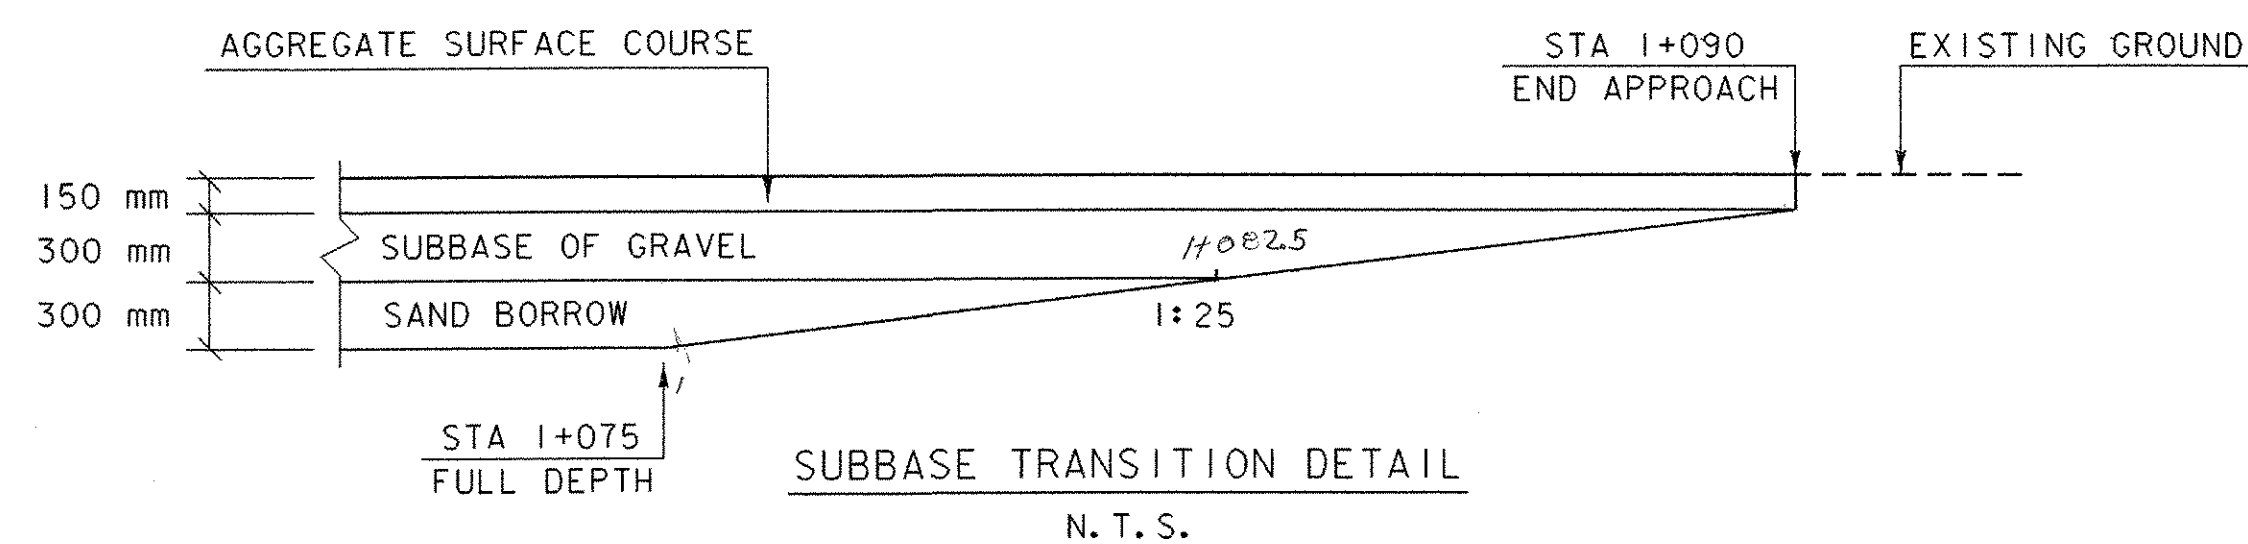

I+080

*FINAL SECTIONS
BEFORE TO ORIGINAL
SURVEY NOTES BY L. CARLSON
DATED 11/1/06 FOR DETAILS
DATE 2/16/07*

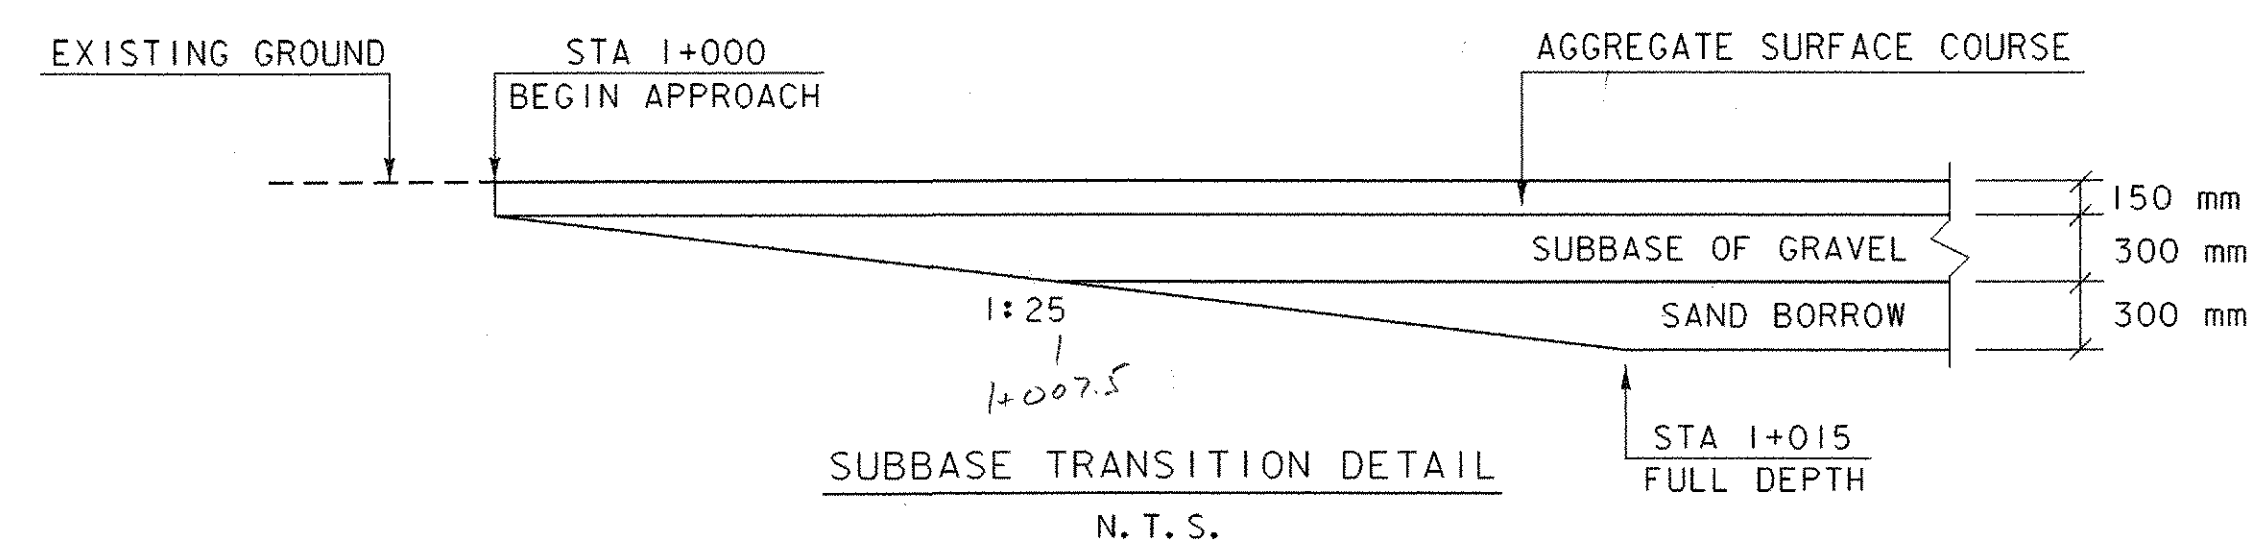

SHEET NAME: MAINLINE SECTIONS	
PROJECT NAME: CLARENDON	HIGHWAY NO.: TH 16
PROJECT NUMBER: BRO 1443(34)	BRIDGE NO.: 24
	OVER: CLARENDON RIVER
FILE NAME: /PW/95j286/sj286xsl.dgn	PLOT DATE: 01-DEC-2005
PROJECT MANAGER: R. WHITCOMB	DRAWN BY: STRI
DESIGNED BY: C. CARLSON	IPARM NAME: sj286m4.1
BRIDGE SHEET NUMBER:	SHEET 40 OF 43