



4+994.00

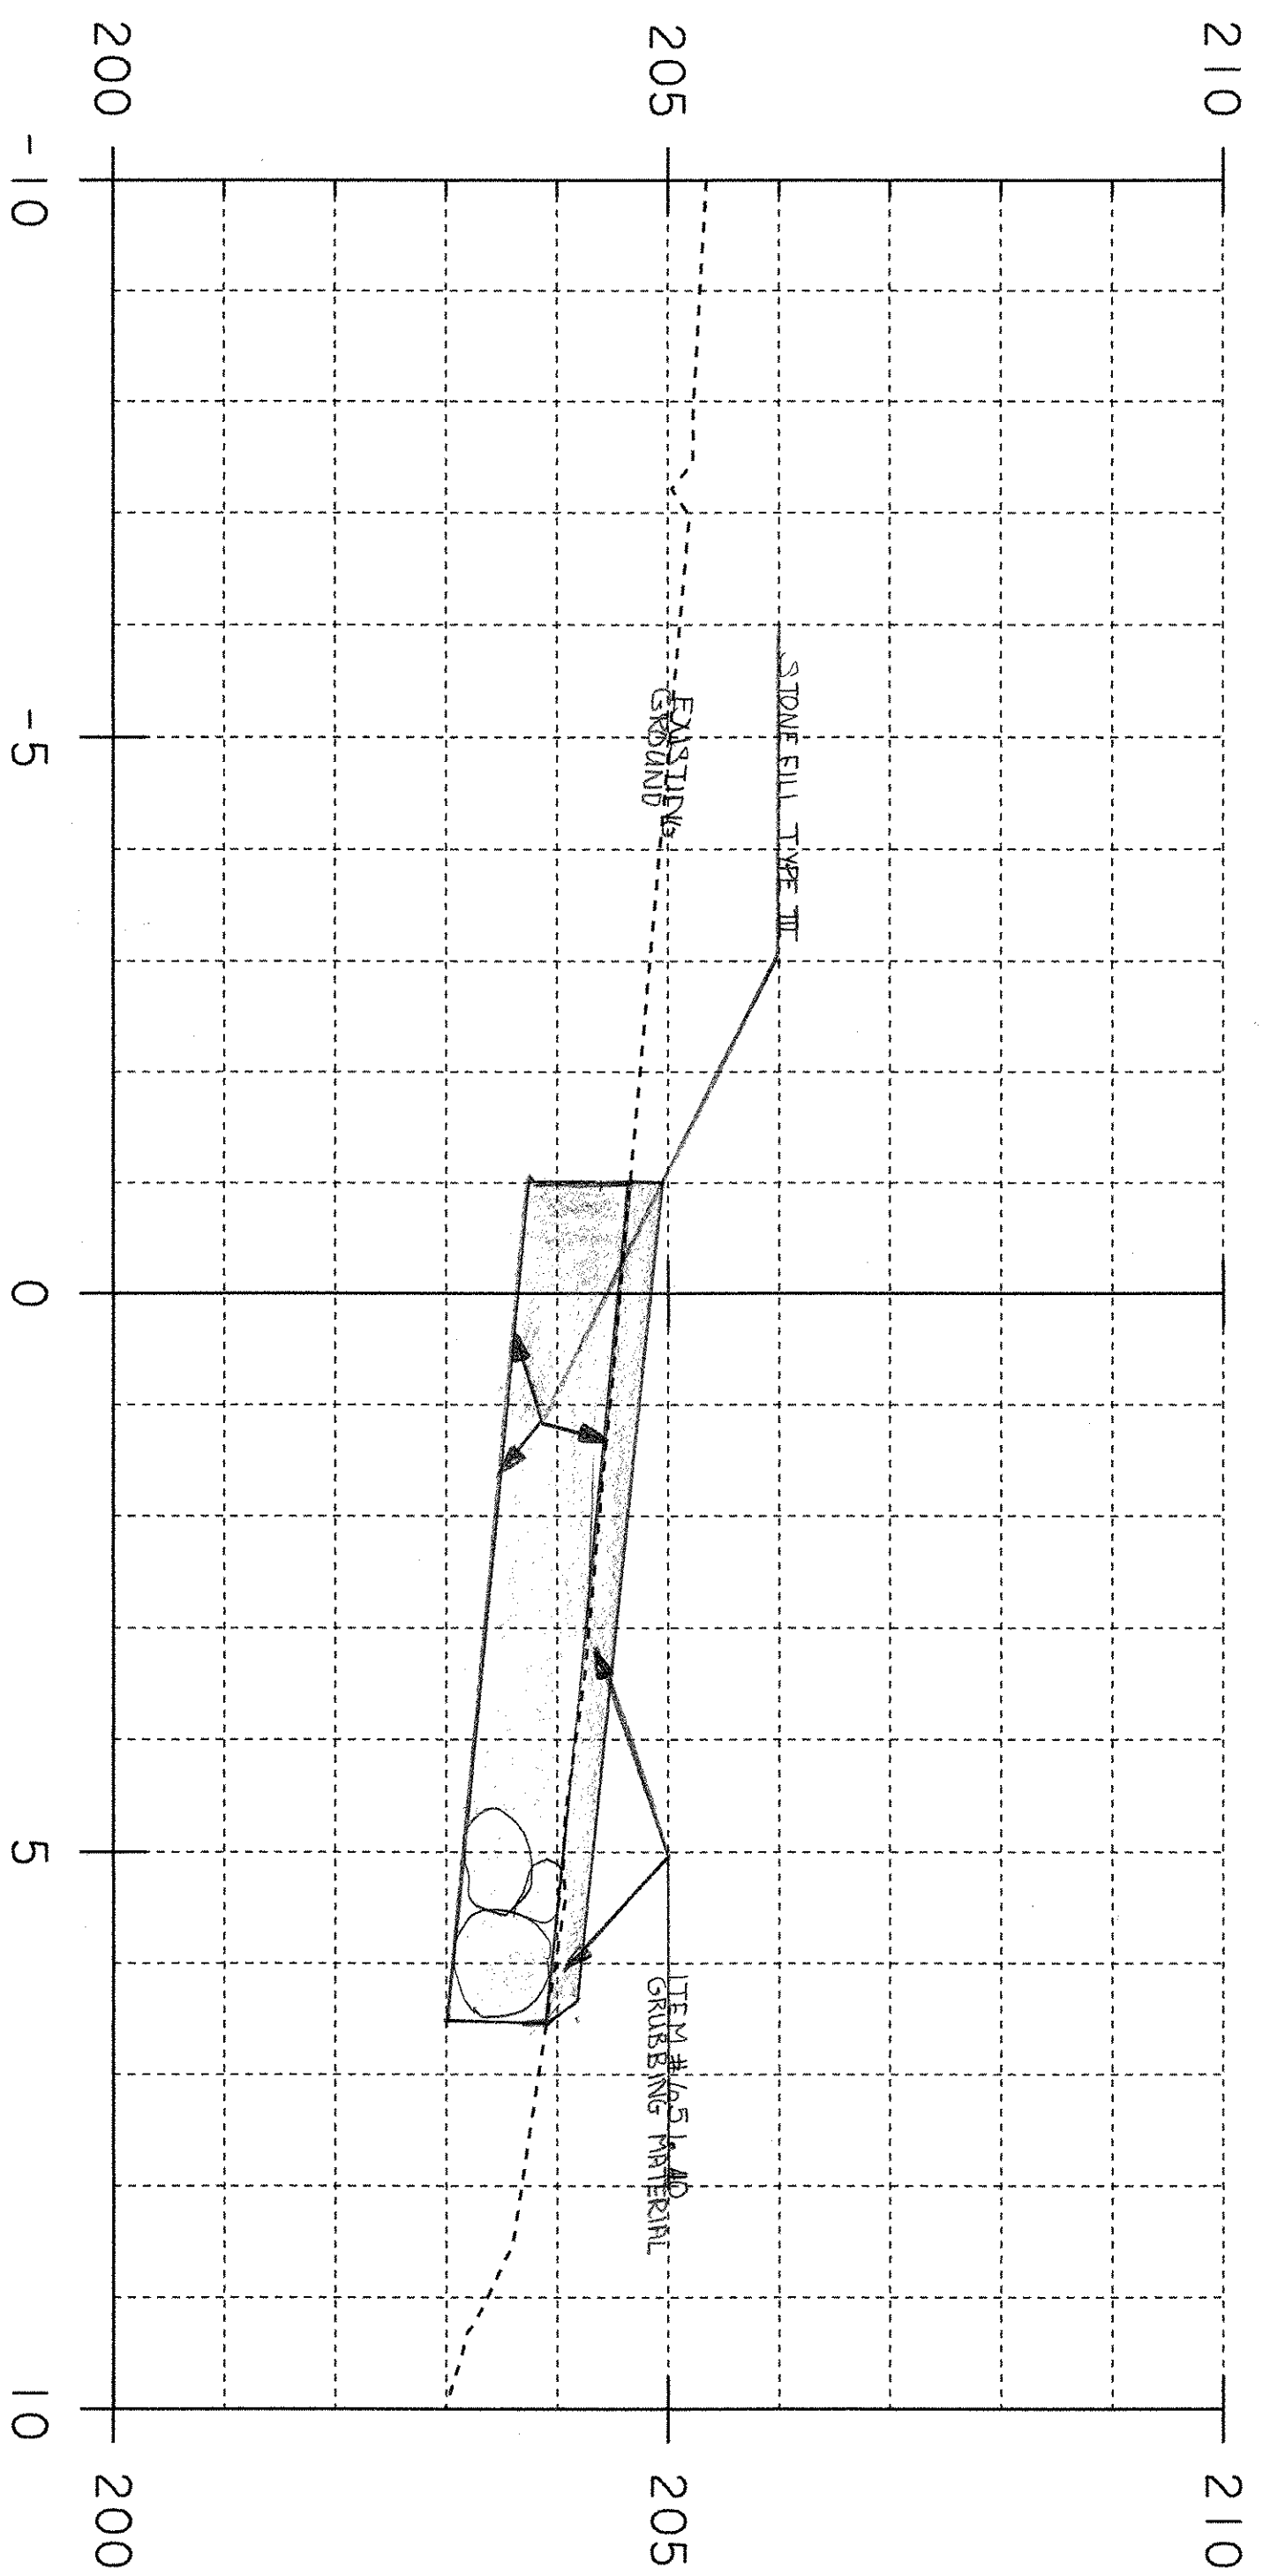

4+992.50

Basin Stone Fill  
(Burr Strain)

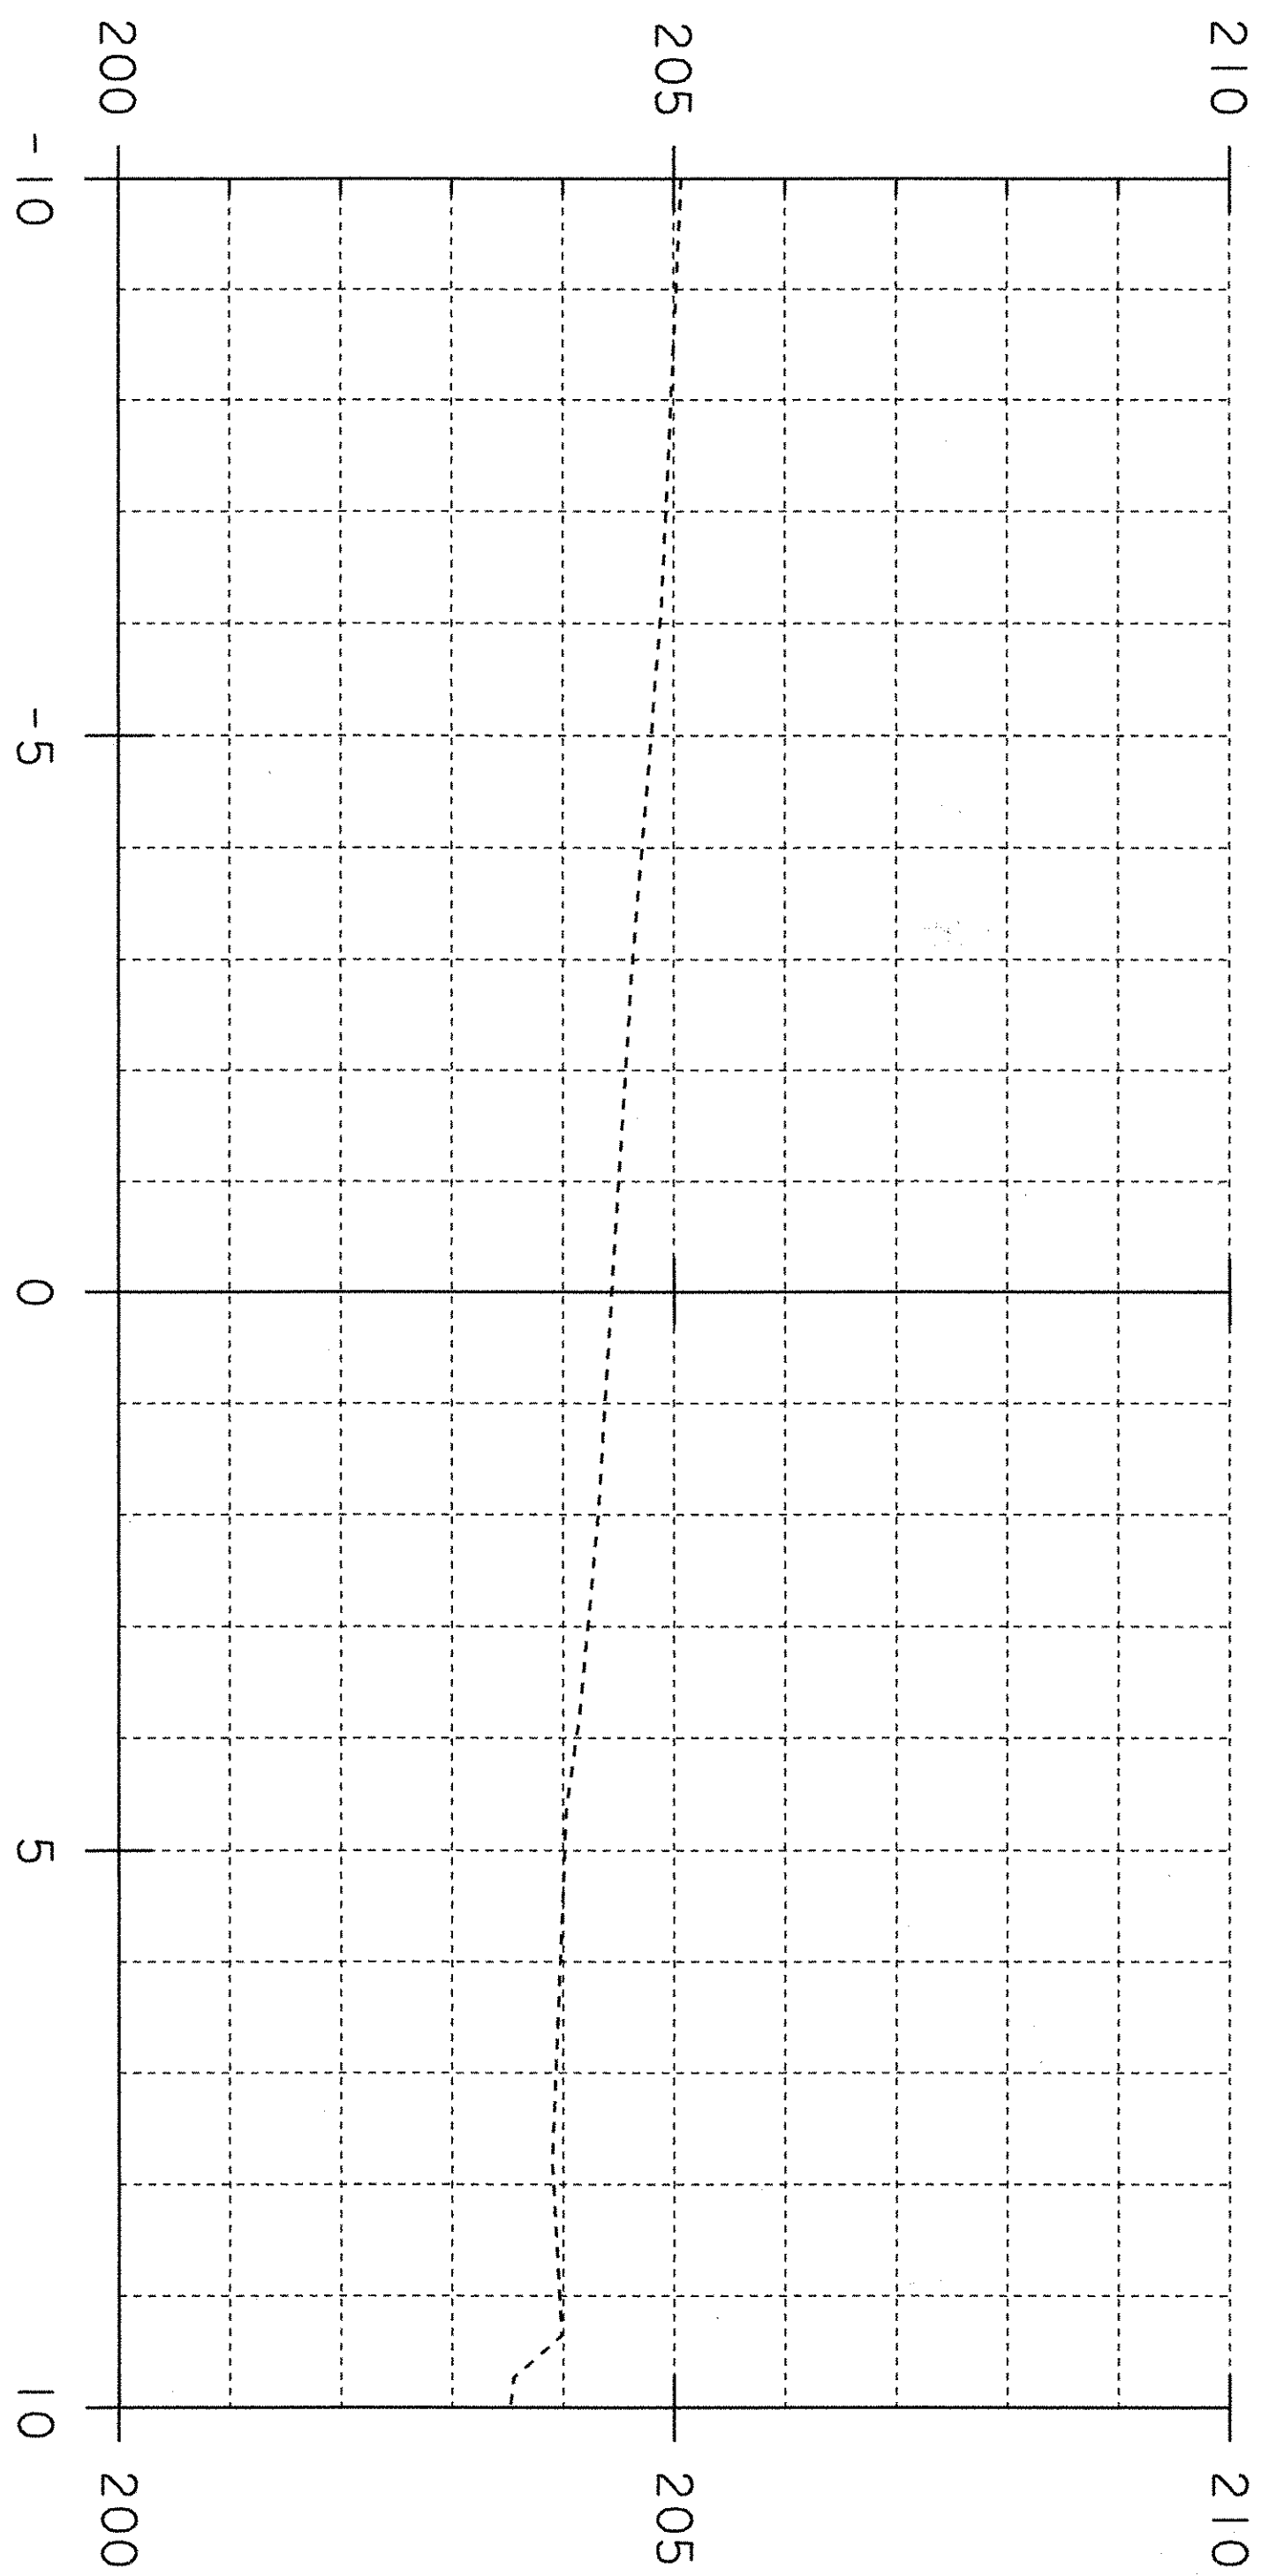

4+990.00  
OUTSIDE LIMITS OF WORK

PROJECT NAME: Clarendon  
PROJECT NUMBER: BRO 1443(34)

FILE NAME: 95j286\survey\work.dgn  
PROJECT LEADER:  
DESIGNED BY:

PLOT DATE: 05-APR-2006  
DRAWN BY: R. Bullock  
CHECKED BY:  
SHEET 2 OF 8