



10+004.00  
9+994.00

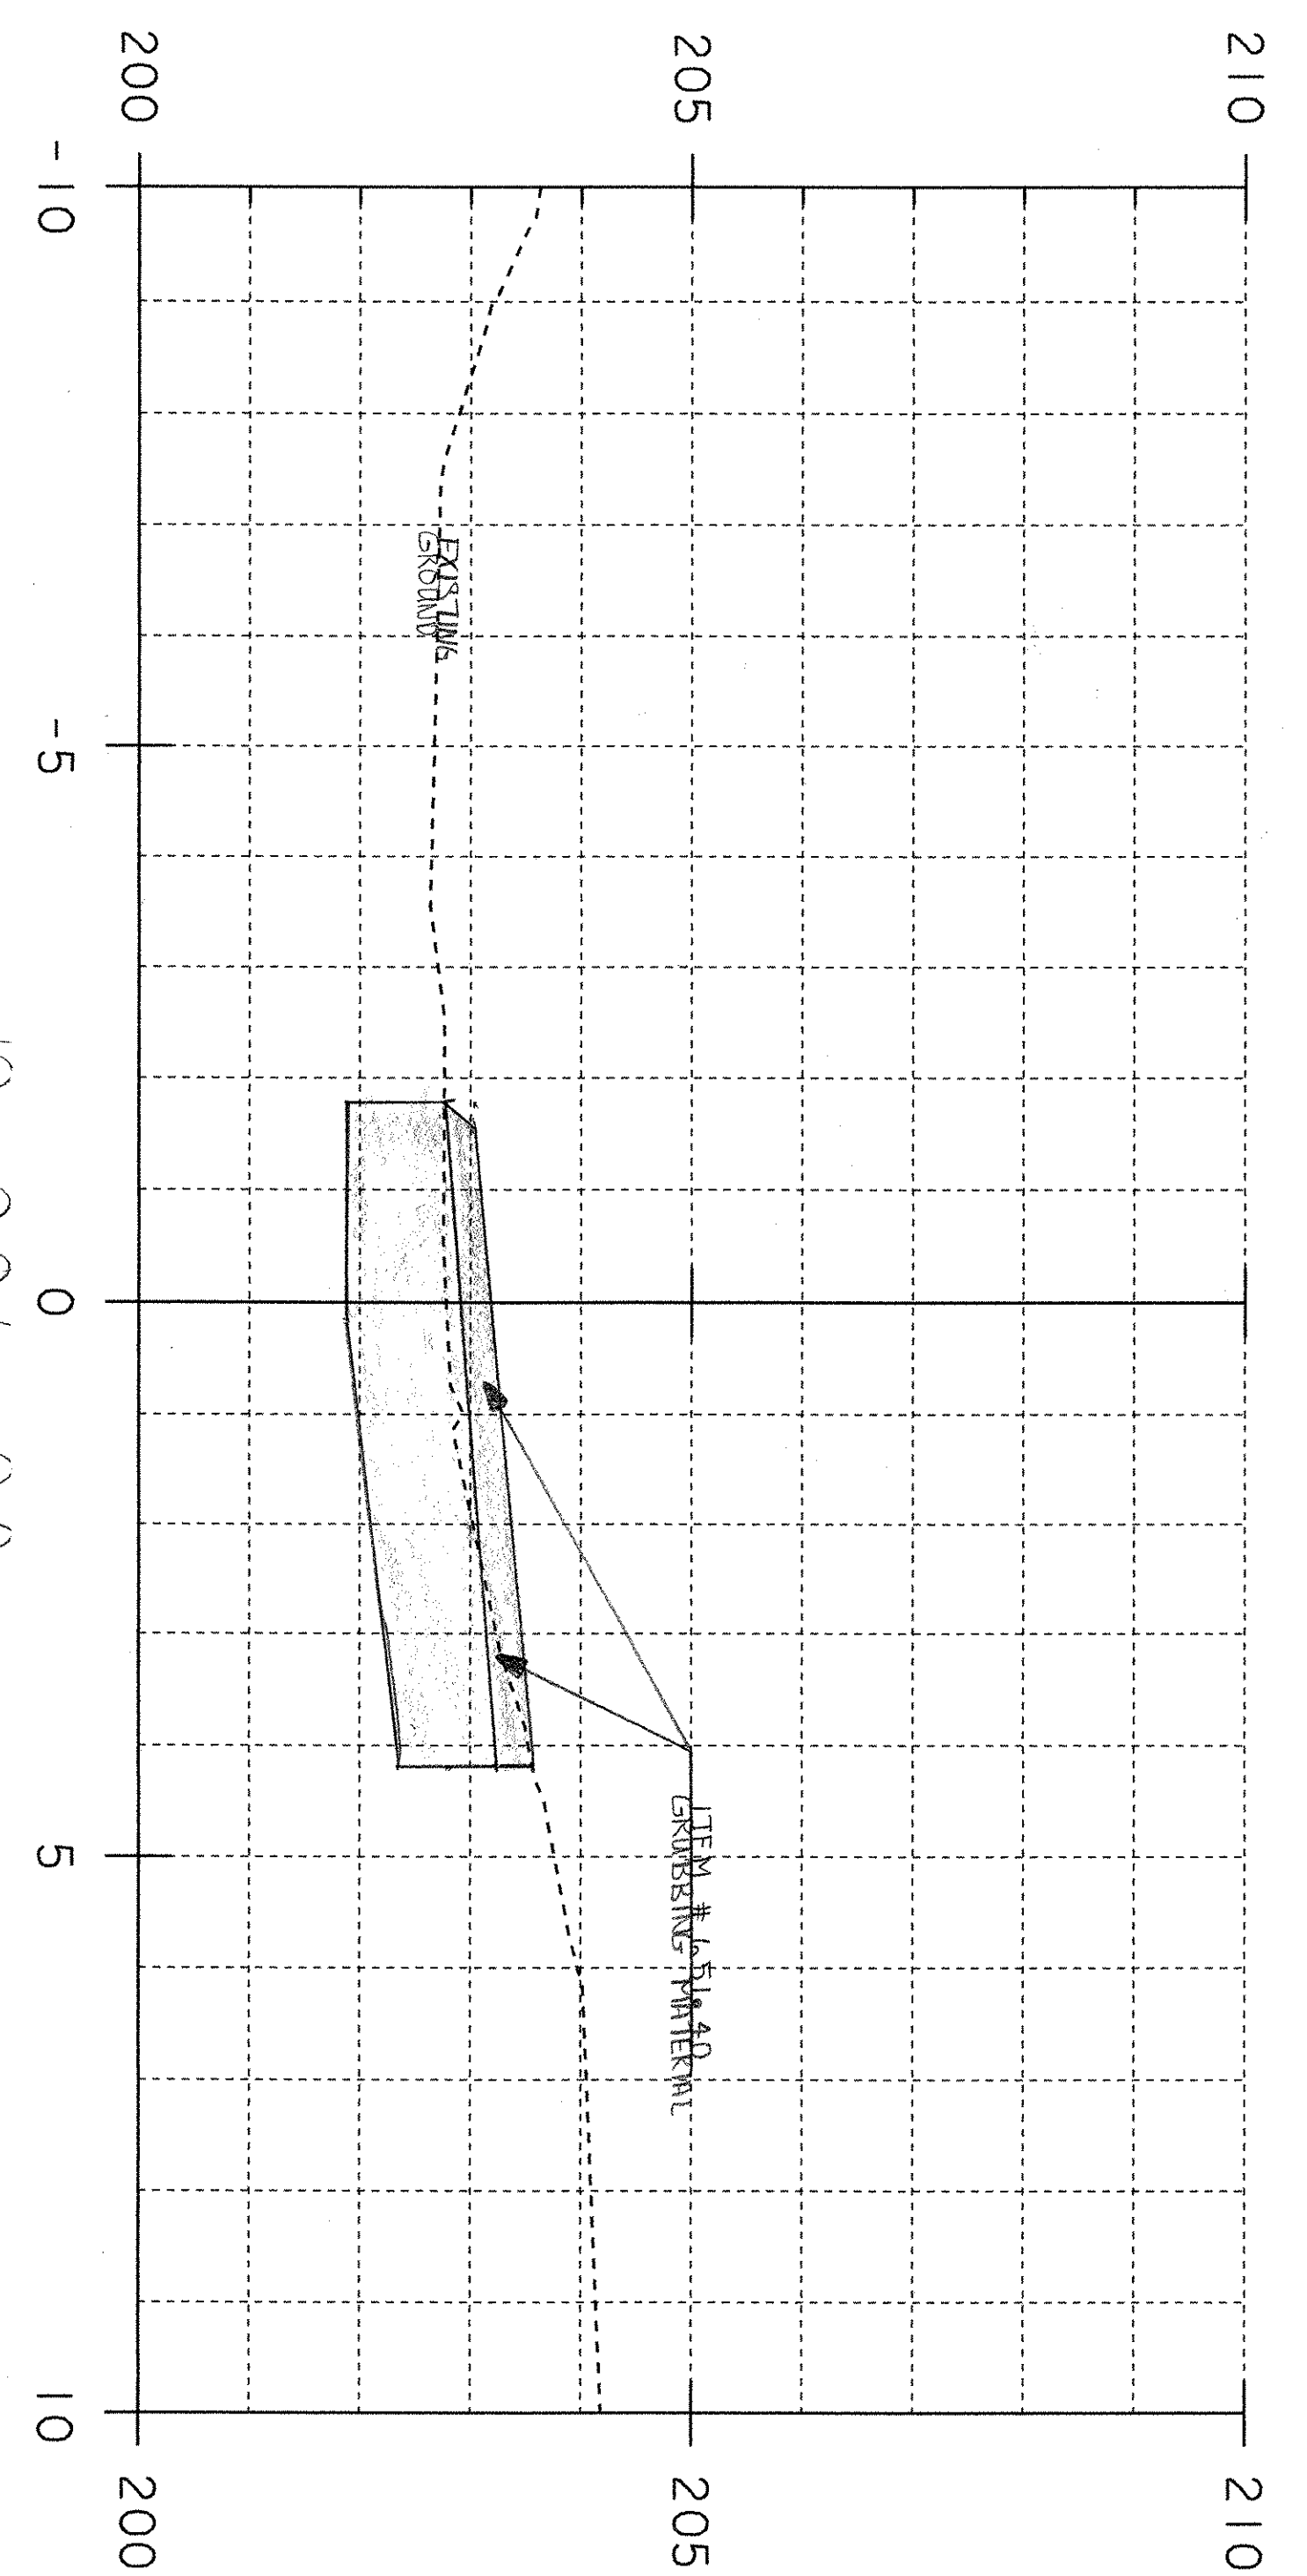

10+006.00  
9+992.00

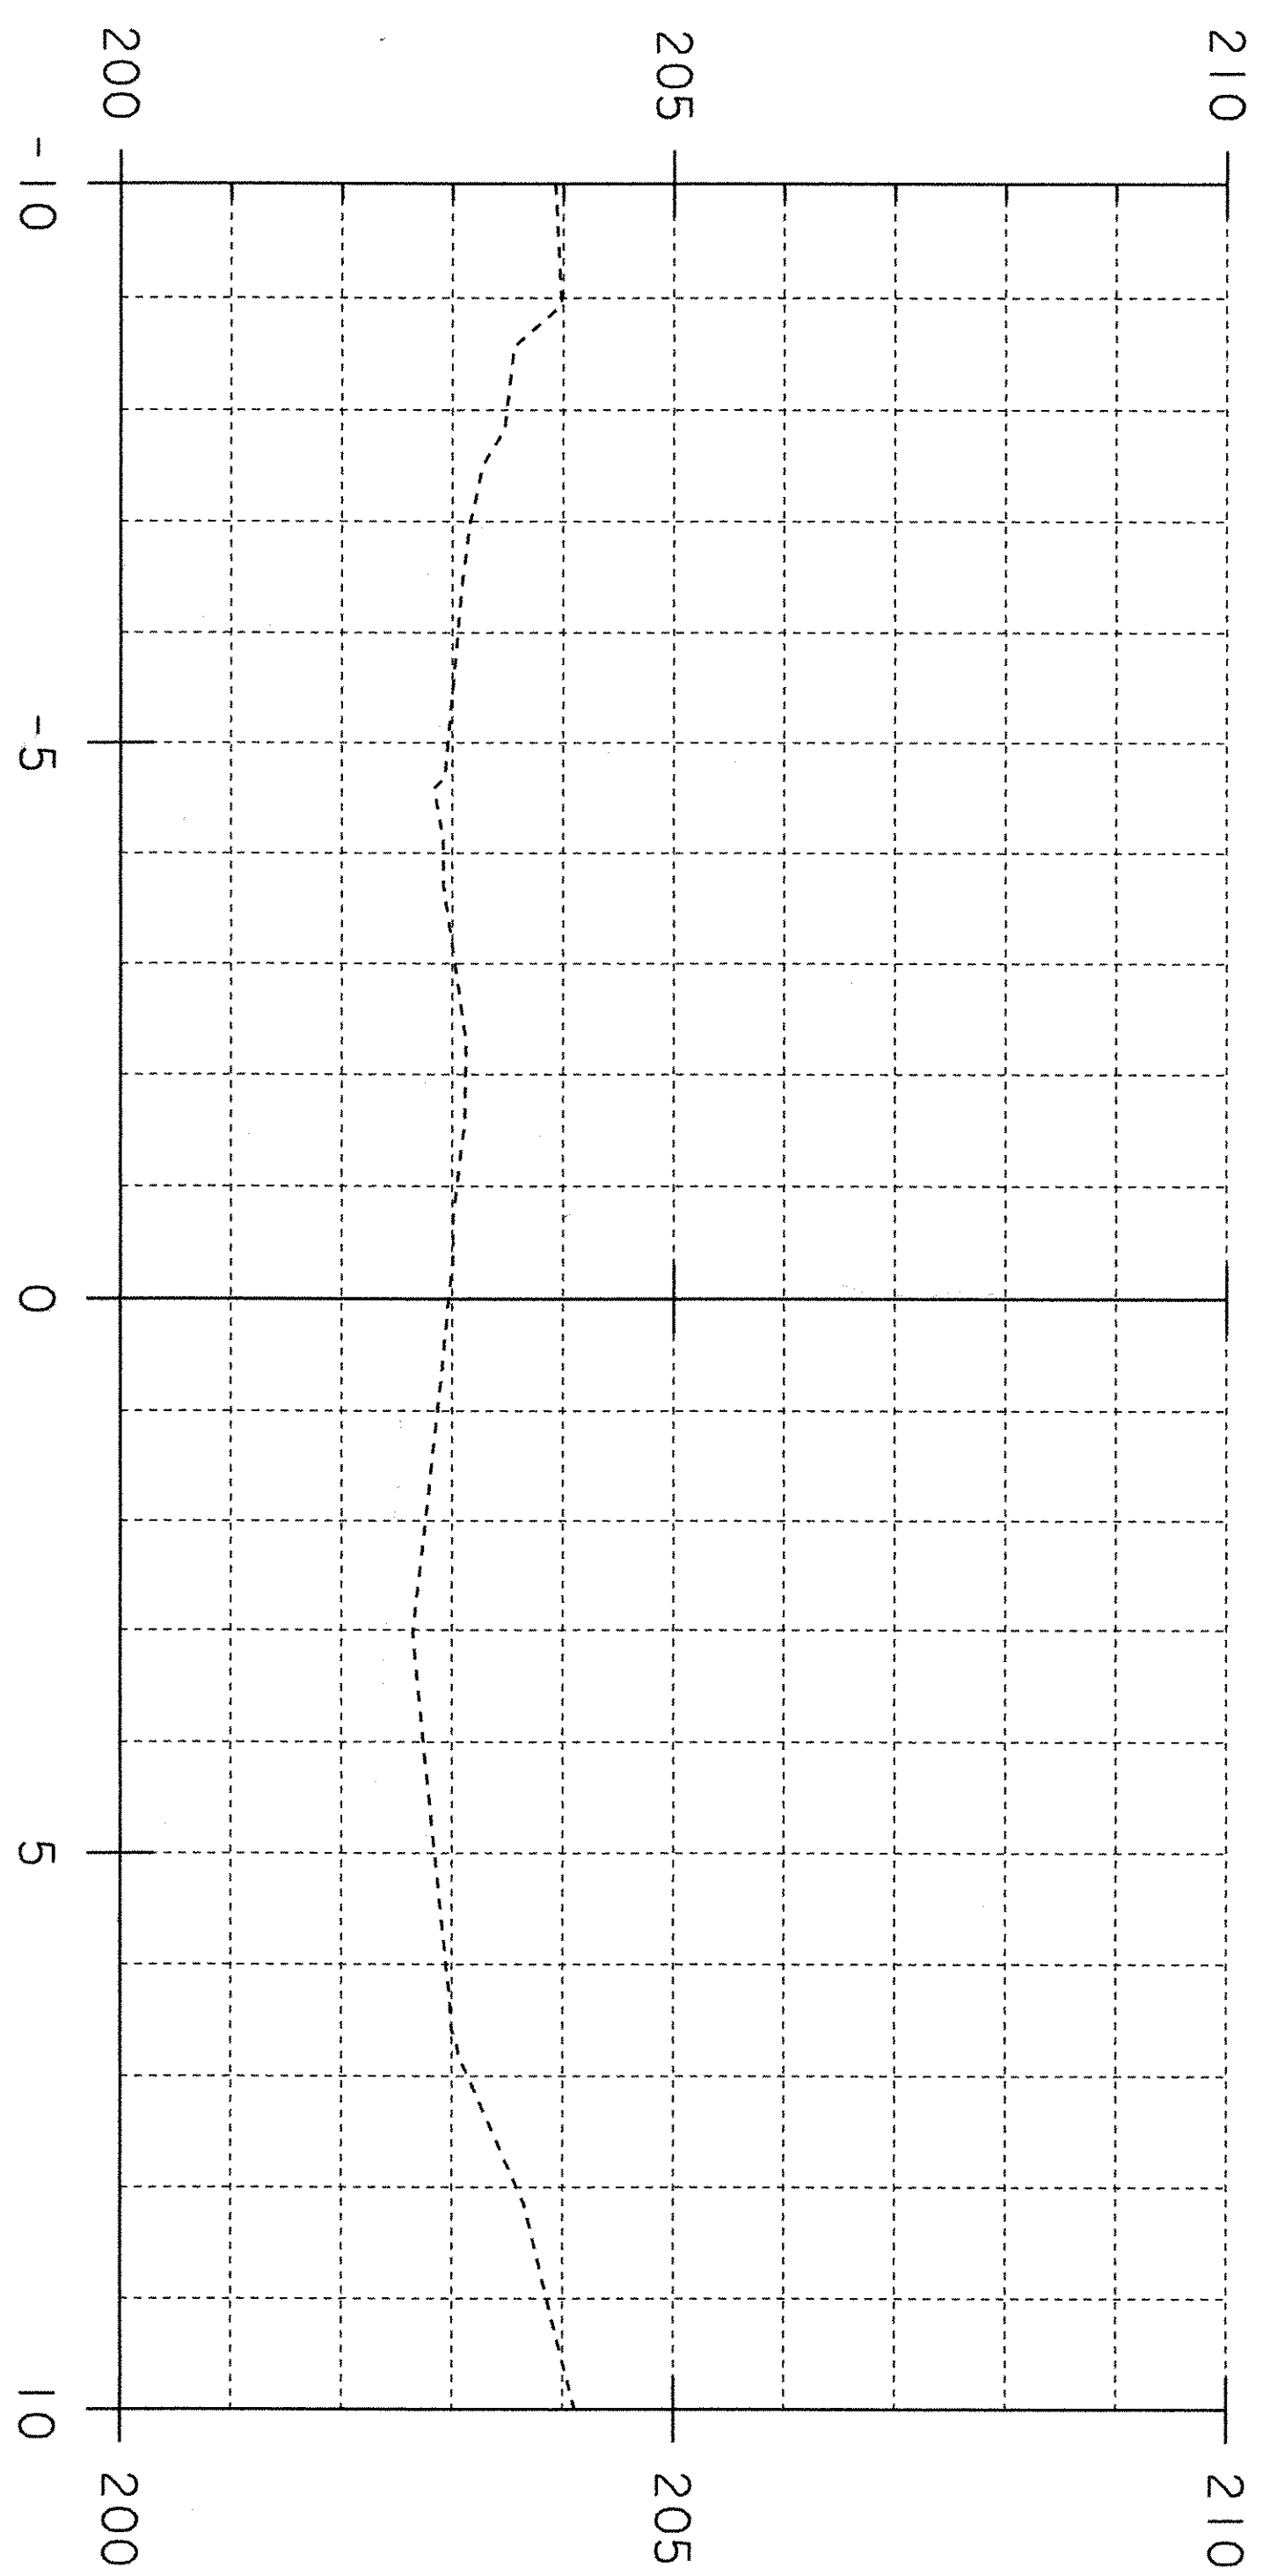

10+007.85  
9+990.00  
OUTSIDE WORK LIMITS

PROJECT NAME:	Clarendon	FILE NAME:	95J286\survey\work.dgn	PLOT DATE:	05-APR-2006
PROJECT NUMBER:	BRO 1443(34)	PROJECT LEADER:		DRAWN BY:	R. Bullock
		DESIGNED BY:		CHECKED BY:	
				SHEET	5 OF 8