



9+998.00

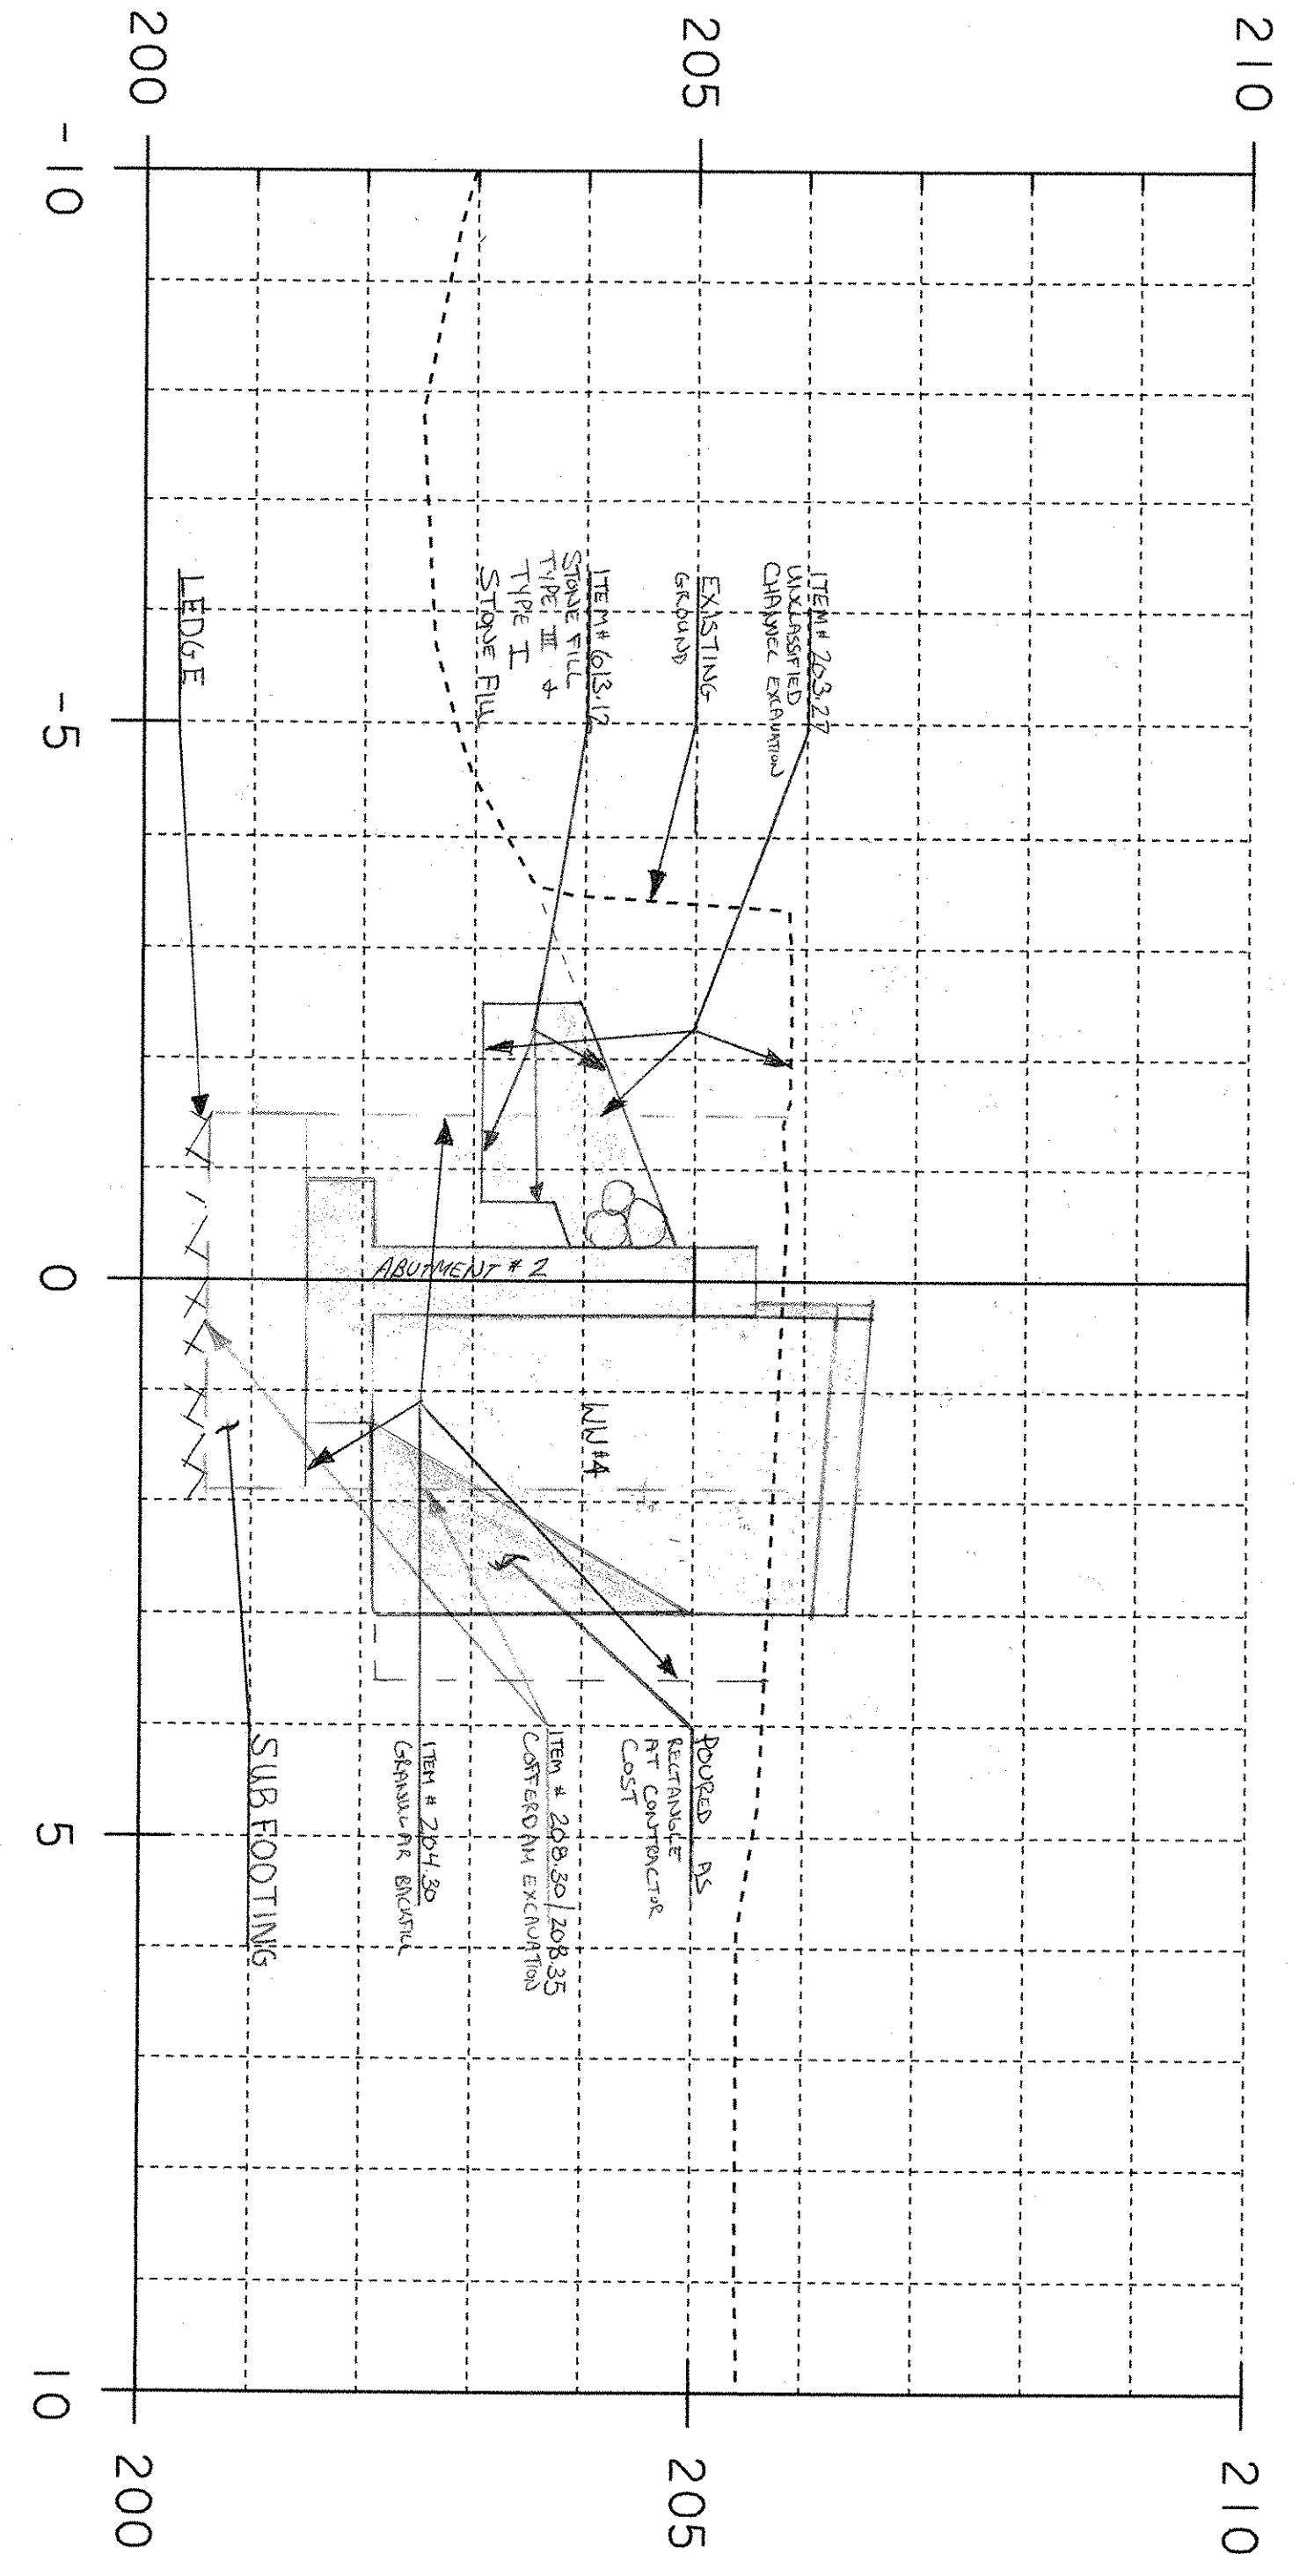

9+997.10

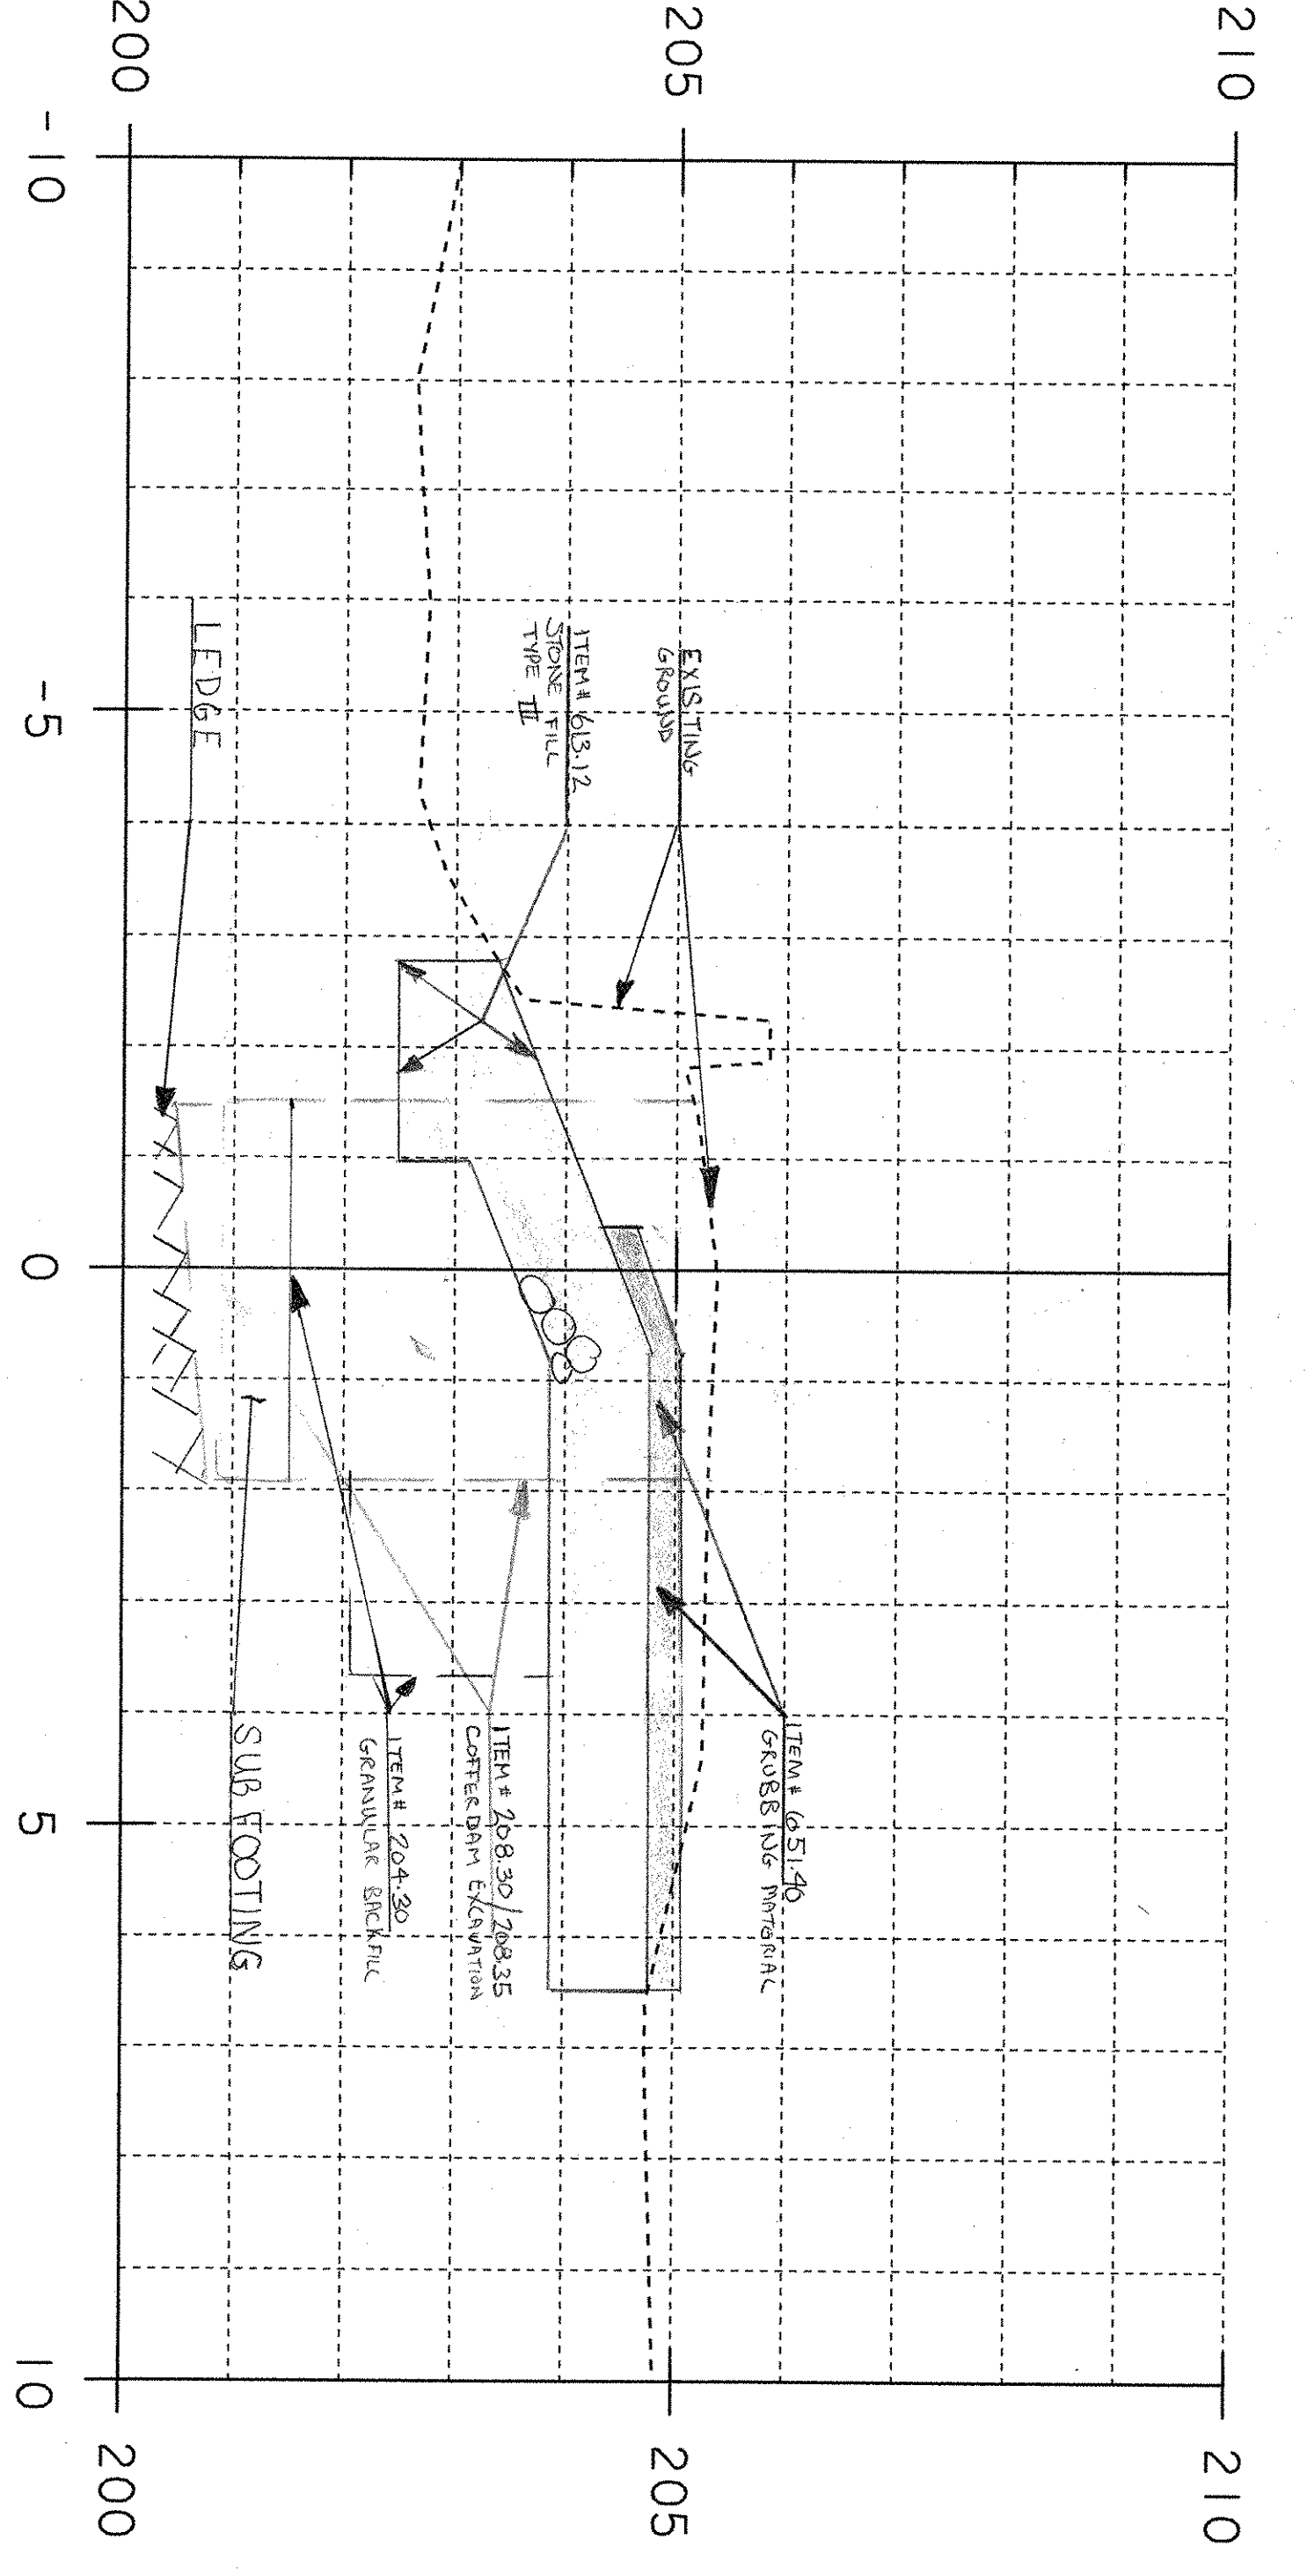

9+996.00

PROJECT NAME:	Clarendon	FILE NAME:	95J286\survey\work.dgn	PLOT DATE:	05-APR-2006
PROJECT NUMBER:	BRO 1443(34)	PROJECT LEADER:		DRAWN BY:	R. Bullock
		DESIGNED BY:		CHECKED BY:	
				SHEET 6	OF 8