



10+002.80

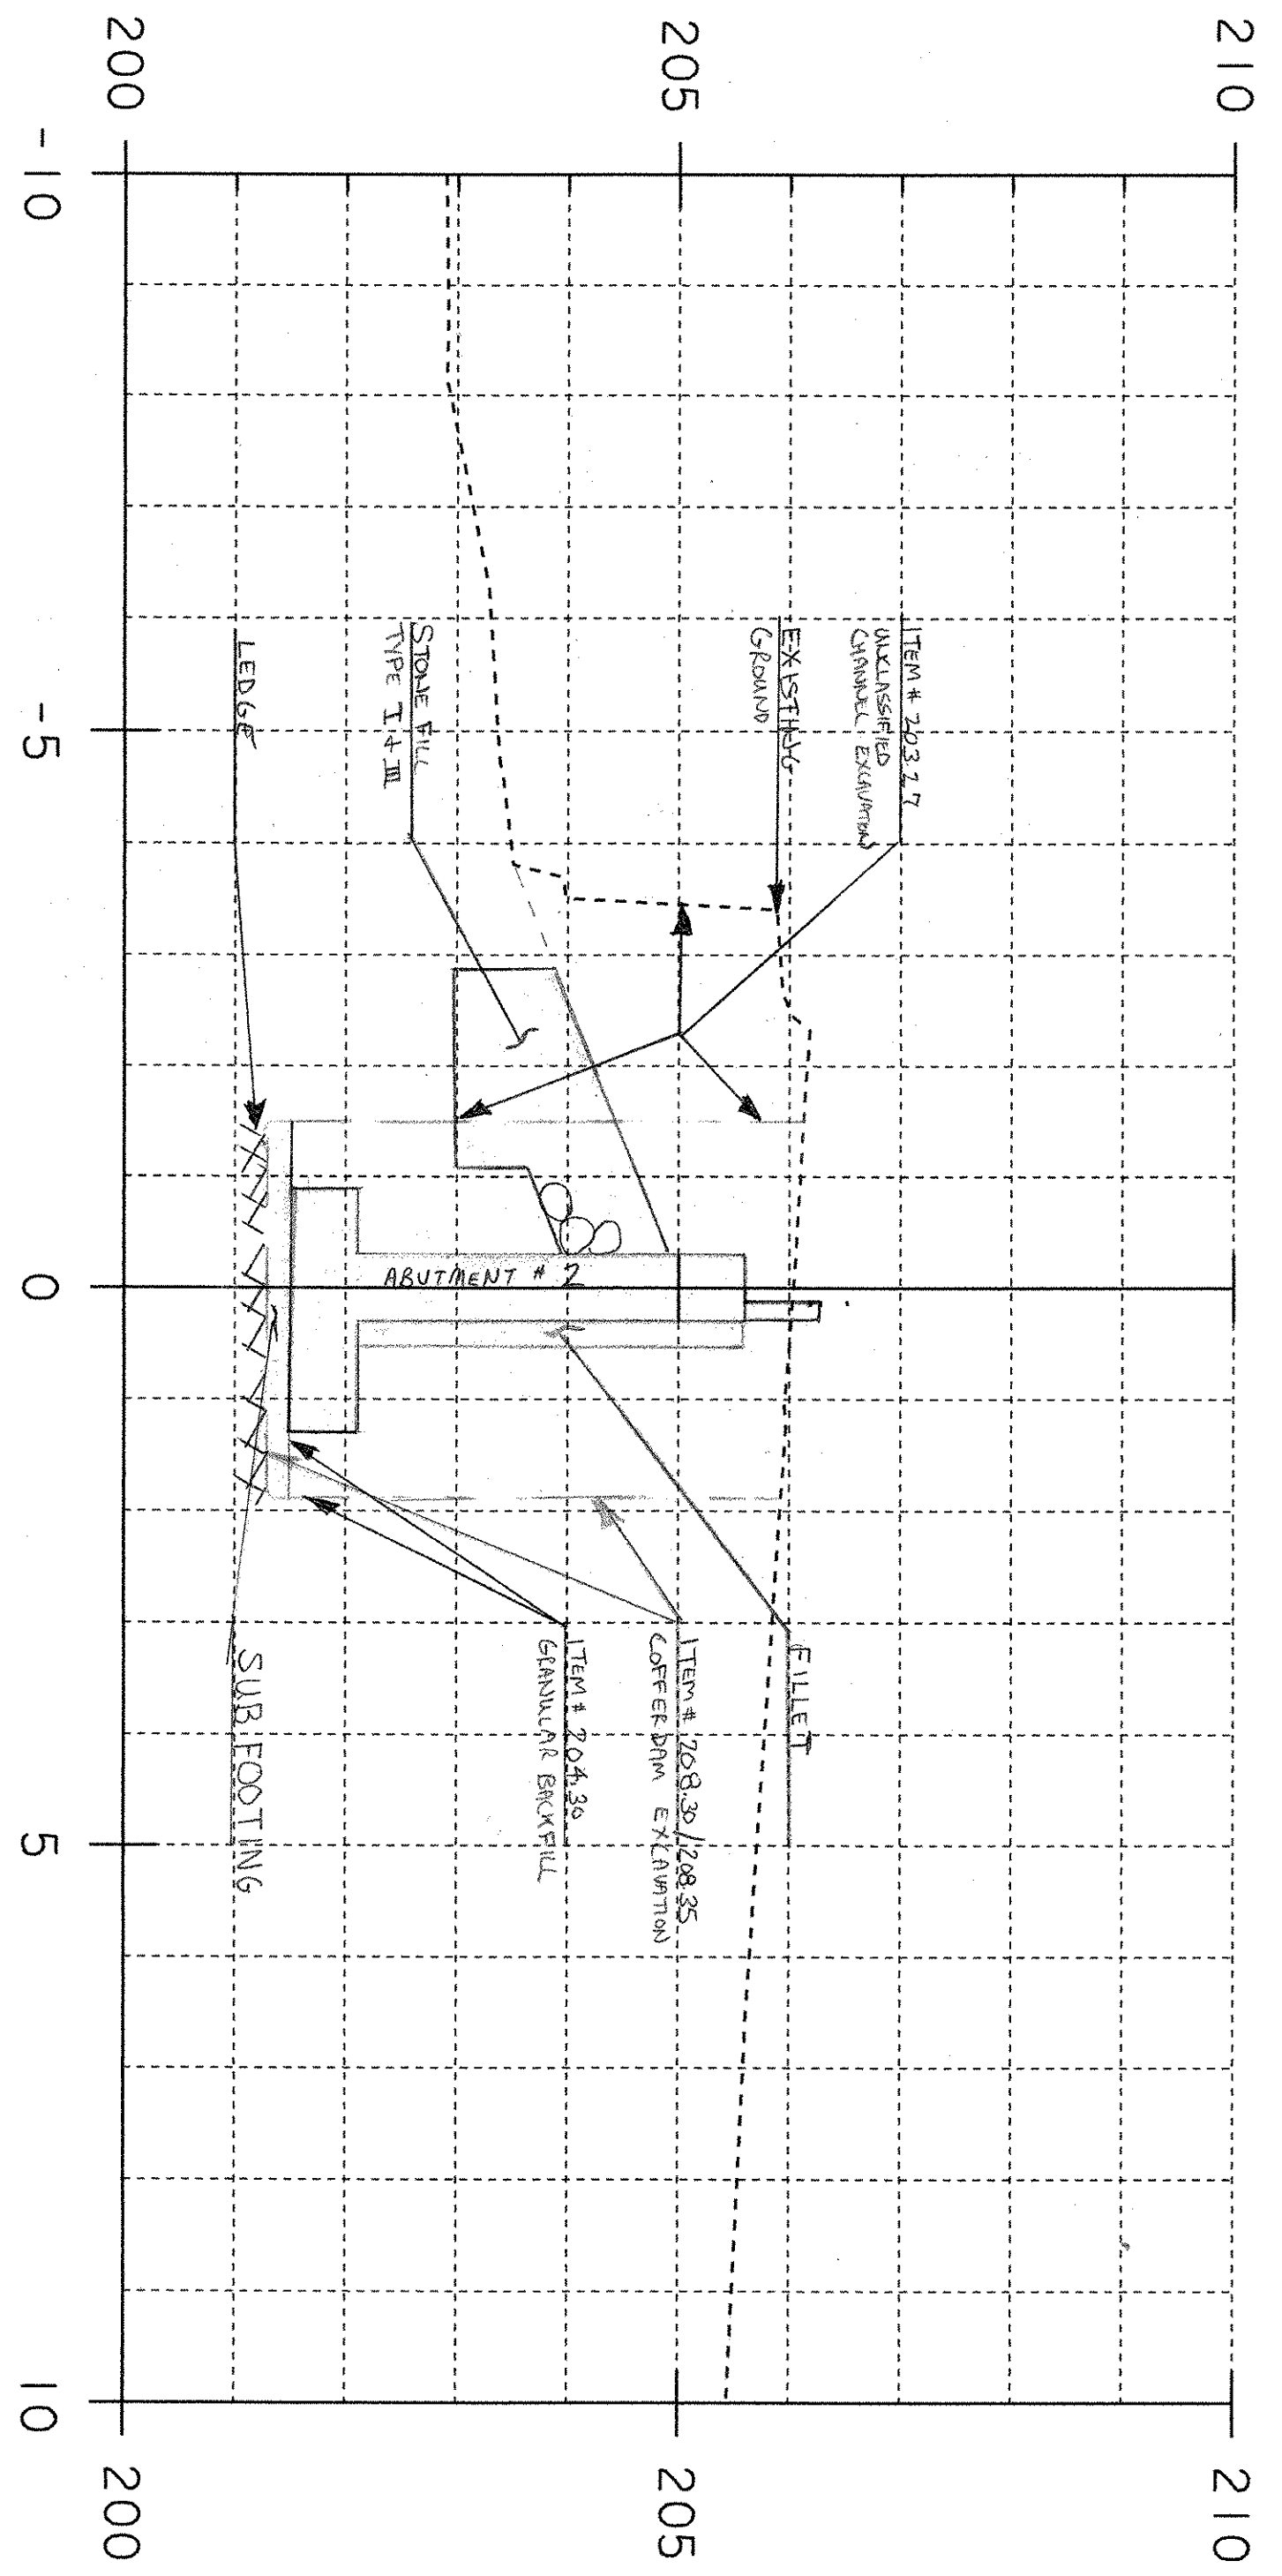

10+002.00

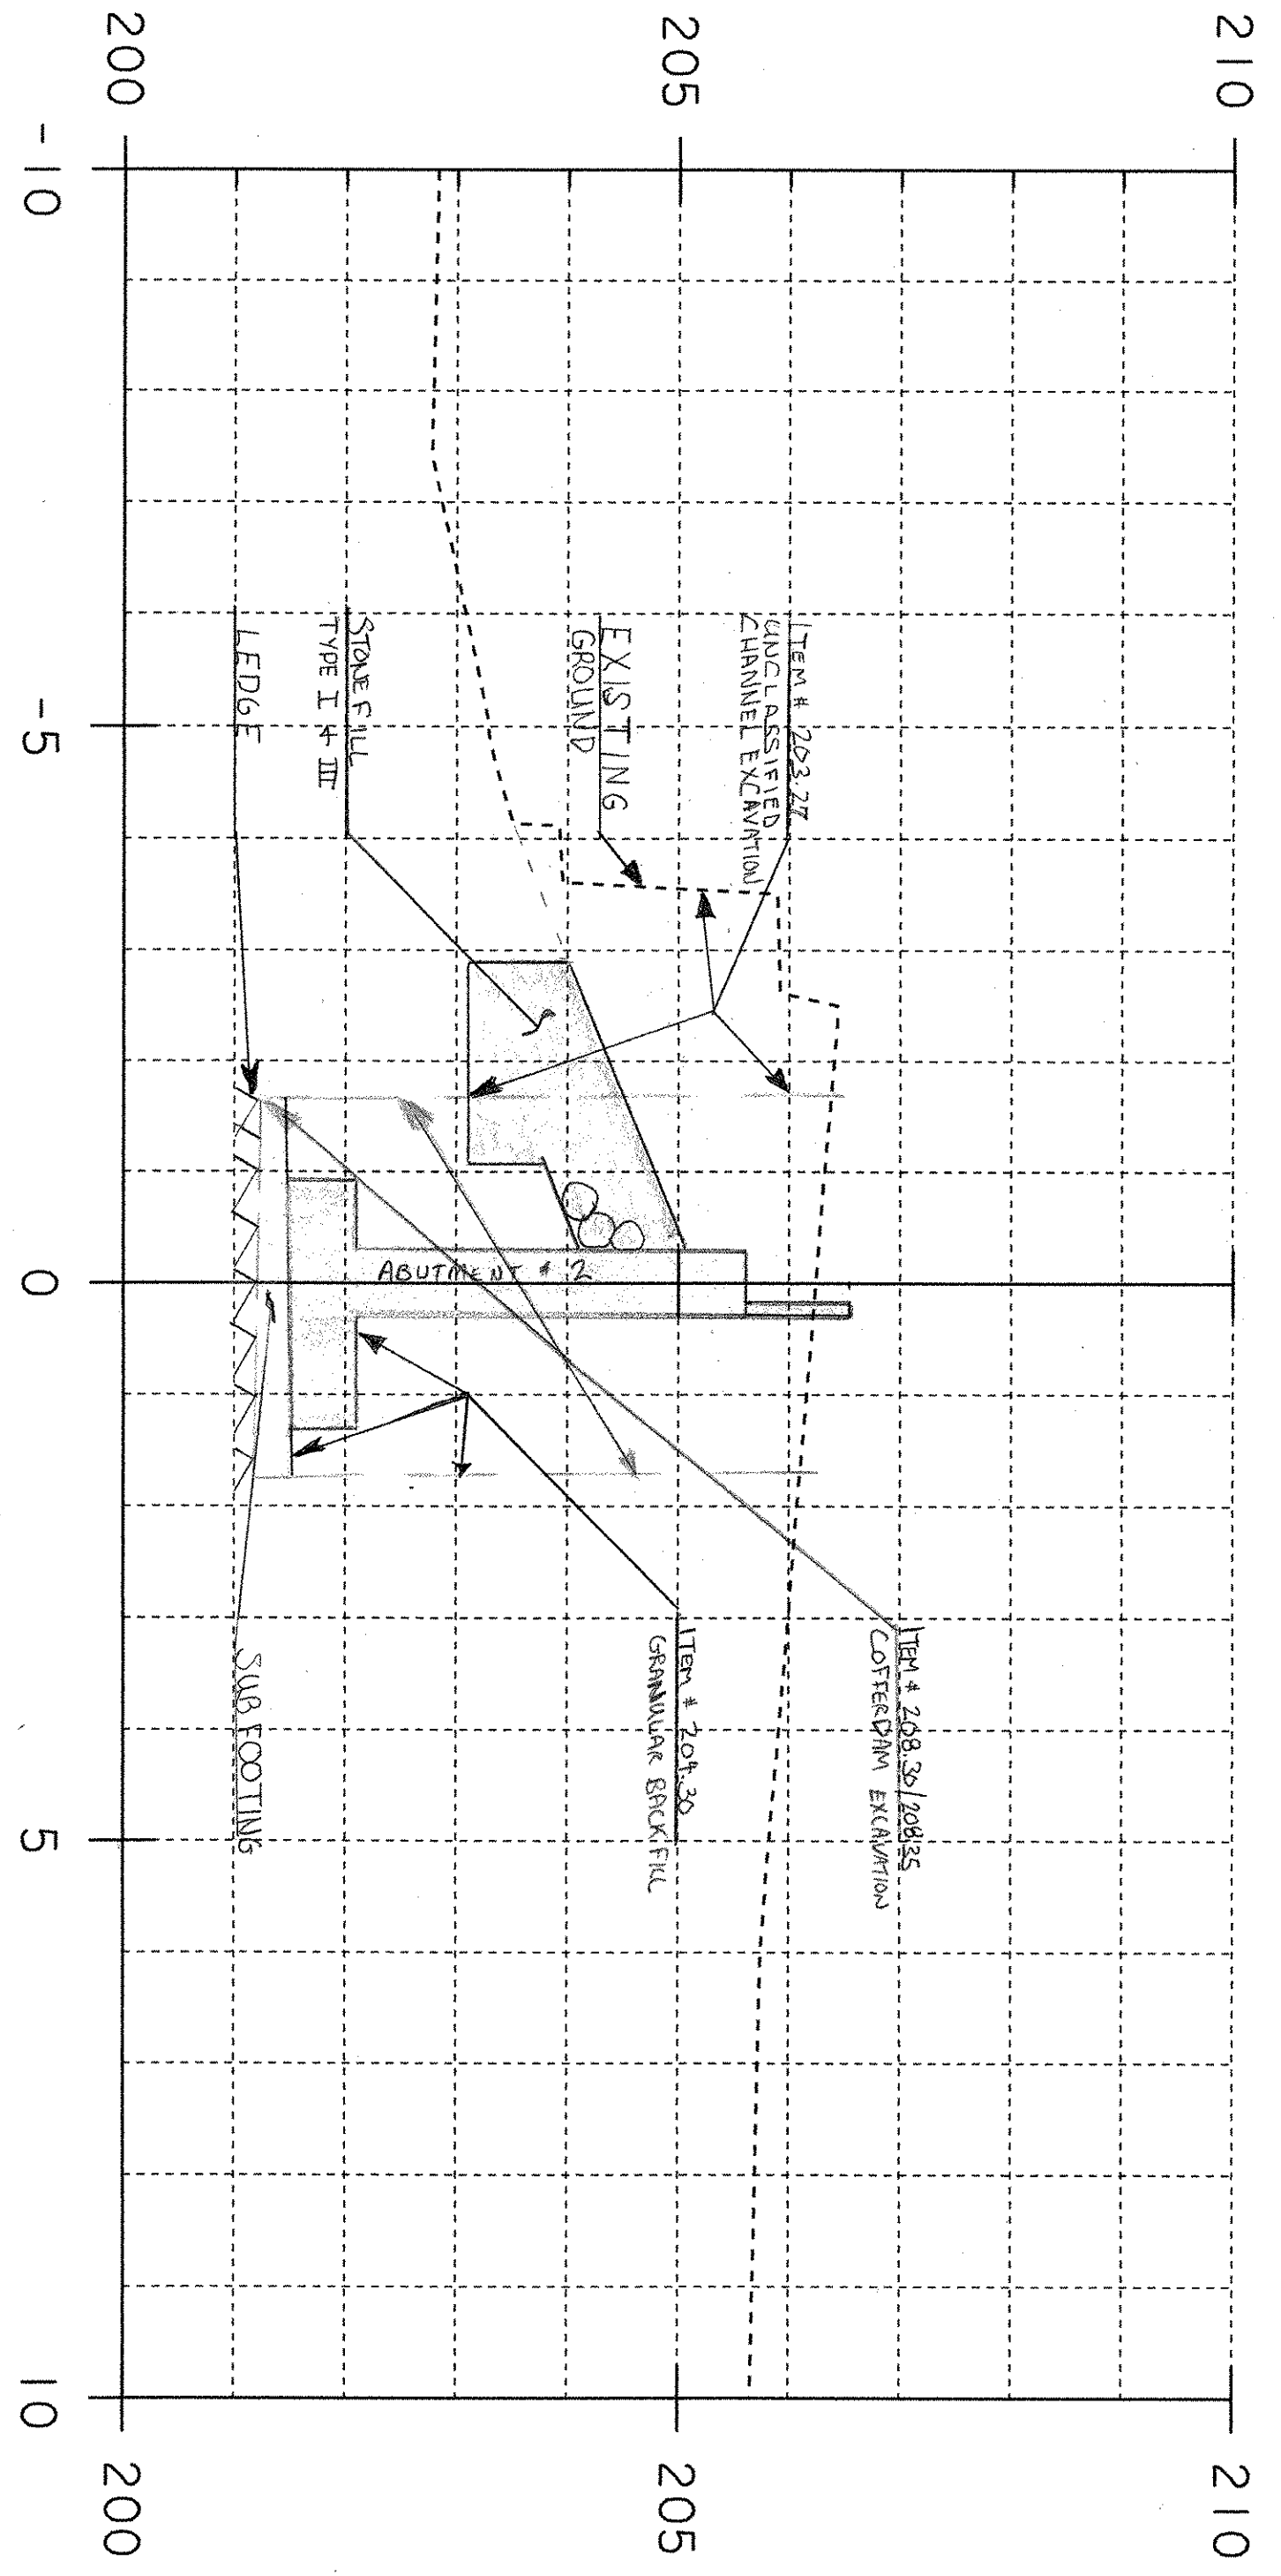

10+000.00

PROJECT NAME:	Clarendon	FILE NAME:	95J286\survey\work.dgn	PLOT DATE:	05-APR-2006
PROJECT NUMBER:	BRO 1443(34)	PROJECT LEADER:		DRAWN BY:	R. Bullock
DESIGNED BY:		CHECKED BY:		SHEET 7	OF 8