



SEE SHEET 2 FOR INDEX OF SHEETS
AND LIST OF STANDARDS.

| RECORD PLANS | |
|--|-------------------------------|
| CONTRACTOR: | BLOW & COTE - MORRISVILLE, VT |
| RESIDENT ENGINEER: | DAVID HOSKING |
| CONSTRUCTION BEGAN: | OCTOBER 31, 2005 |
| CONSTRUCTION COMPLETE: | JUNE 29, 2007 |
| RECORD PLANS BY: | DAVID HOSKING & JUDY GILMORE |
| I HEREBY CERTIFY THAT ALL THE CONSTRUCTION REQUIRED BY THIS SET OF DRAWINGS HAS BEEN ACCOMPLISHED AS INDICATED HEREIN. | |
| BY <i>David Hosking</i> | RESIDENT ENGINEER |
| DATE <i>JUNE 23, 2008</i> | |
| NOTE: Any further information concerning final quantities, amounts or other details relative to this project may be found at Central Files in the electronic archives. | |

STATE OF VERMONT AGENCY OF TRANSPORTATION

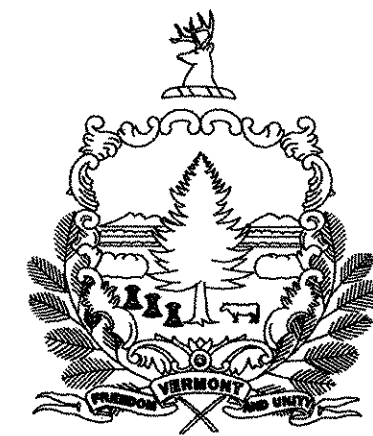

PROPOSED IMPROVEMENT BRIDGE PROJECT

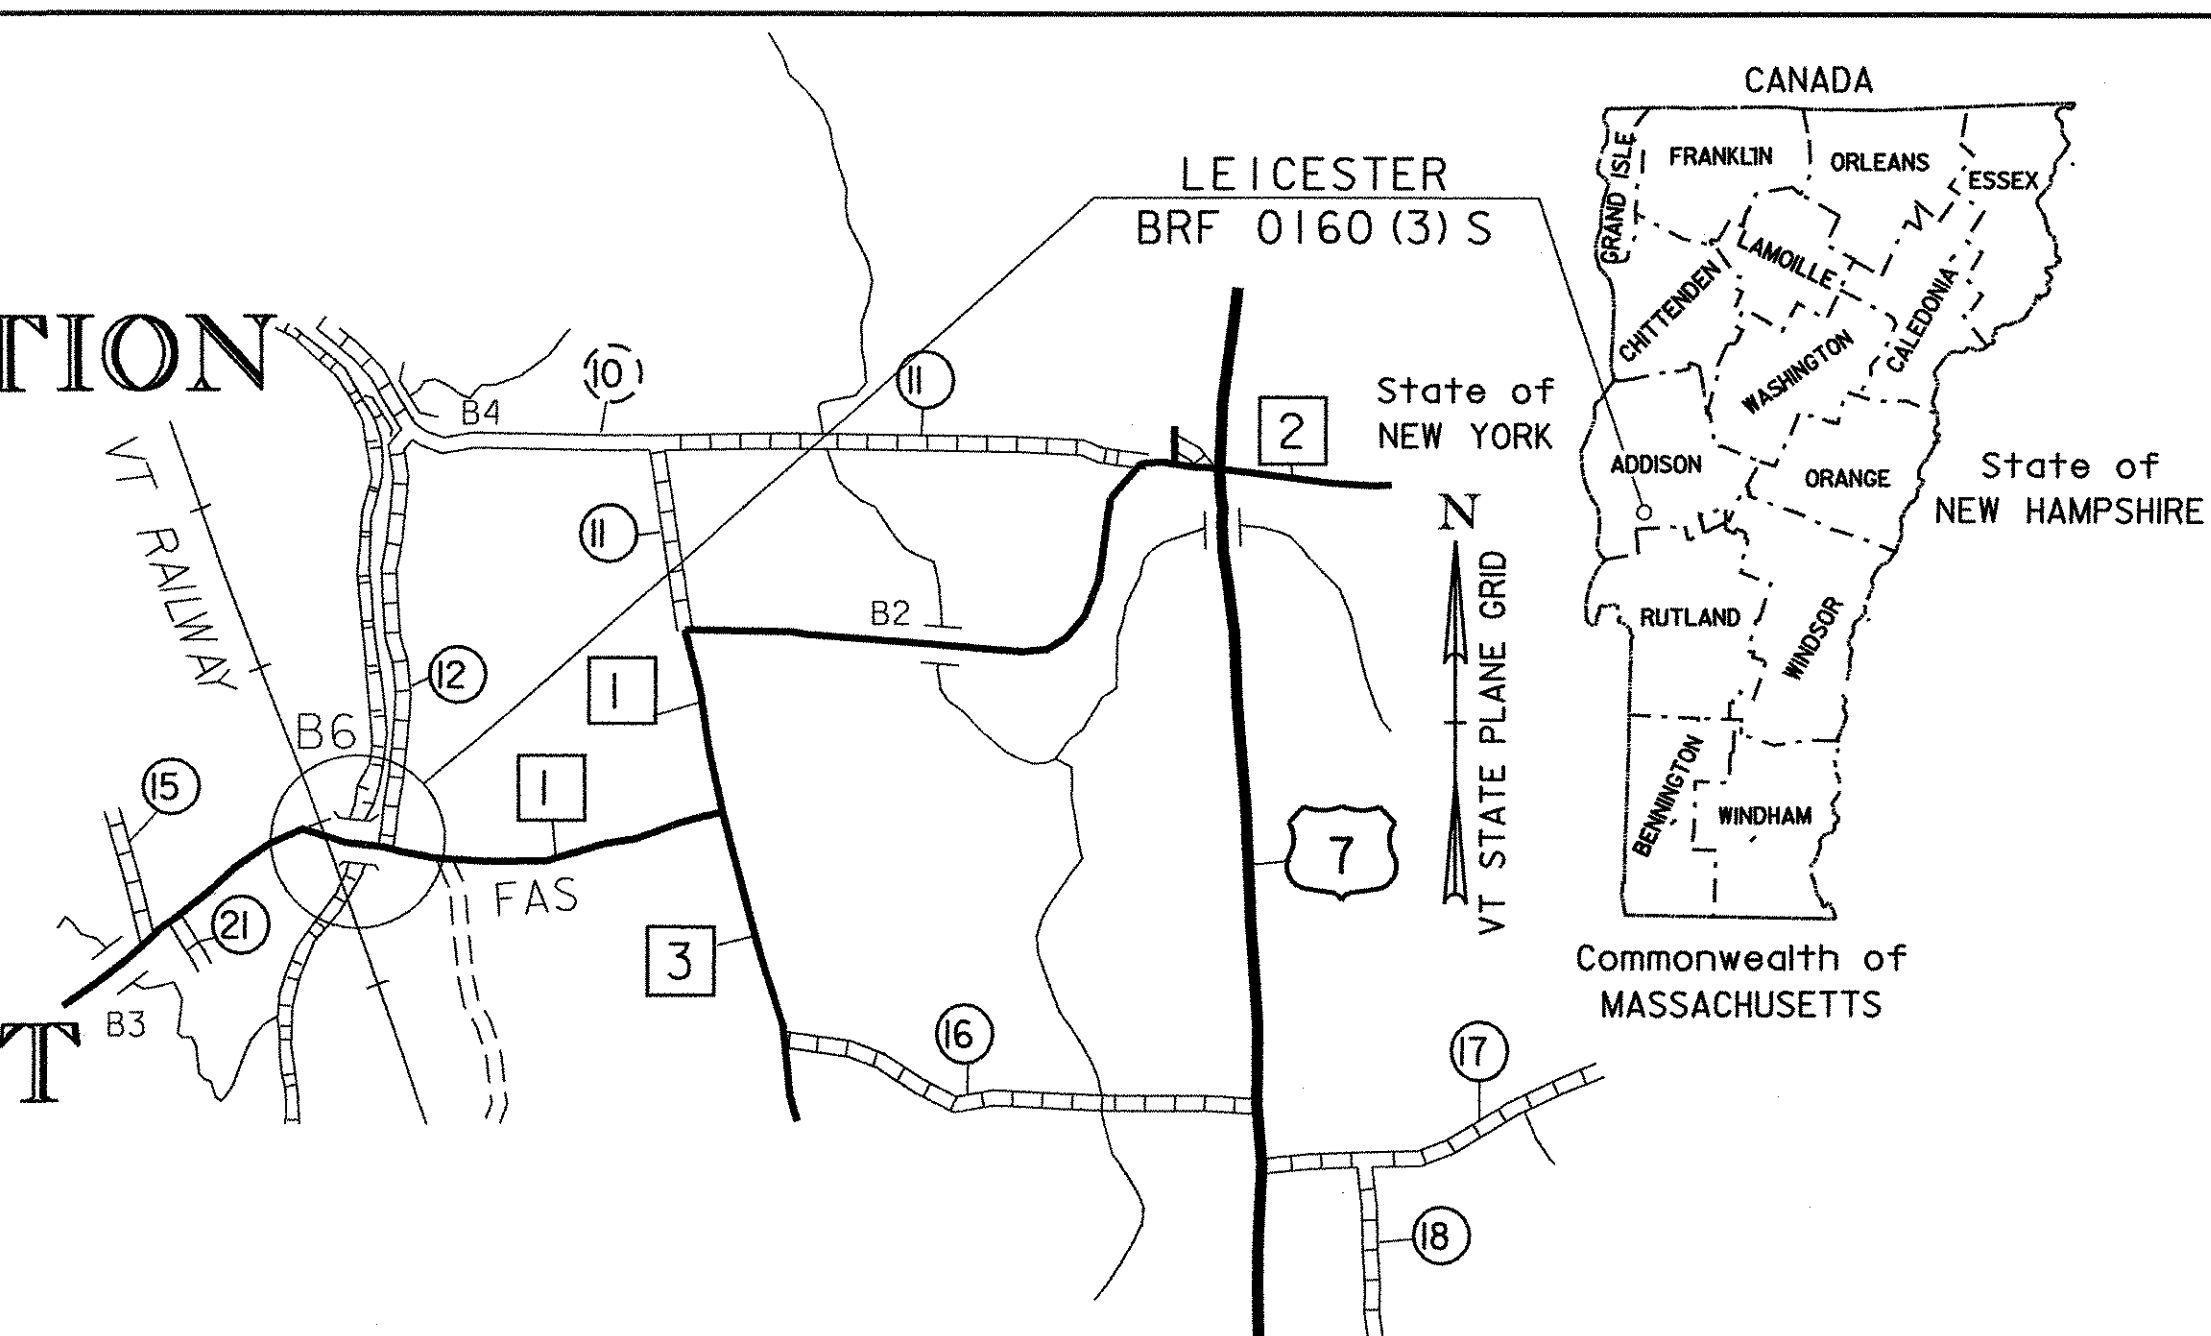

TOWN OF LEICESTER COUNTY OF ADDISON

ROUTE NO : TH 1 (FAS 160) MAJOR COLLECTOR

BRIDGE NO : 6


PROJECT LOCATION : APPROXIMATELY 1.61KM WESTERLY OF THE INTERSECTION OF TH 1 AND TH 3.

PROJECT DESCRIPTION : REPLACEMENT OF THE EXISTING STRUCTURE, INCLUDING NECESSARY ROADWAY AND CHANNEL WORK.

LENGTH OF STRUCTURE : 34.782 METERS.

LENGTH OF ROADWAY : 220.218 METERS.


LENGTH OF PROJECT : 255.000 METERS.

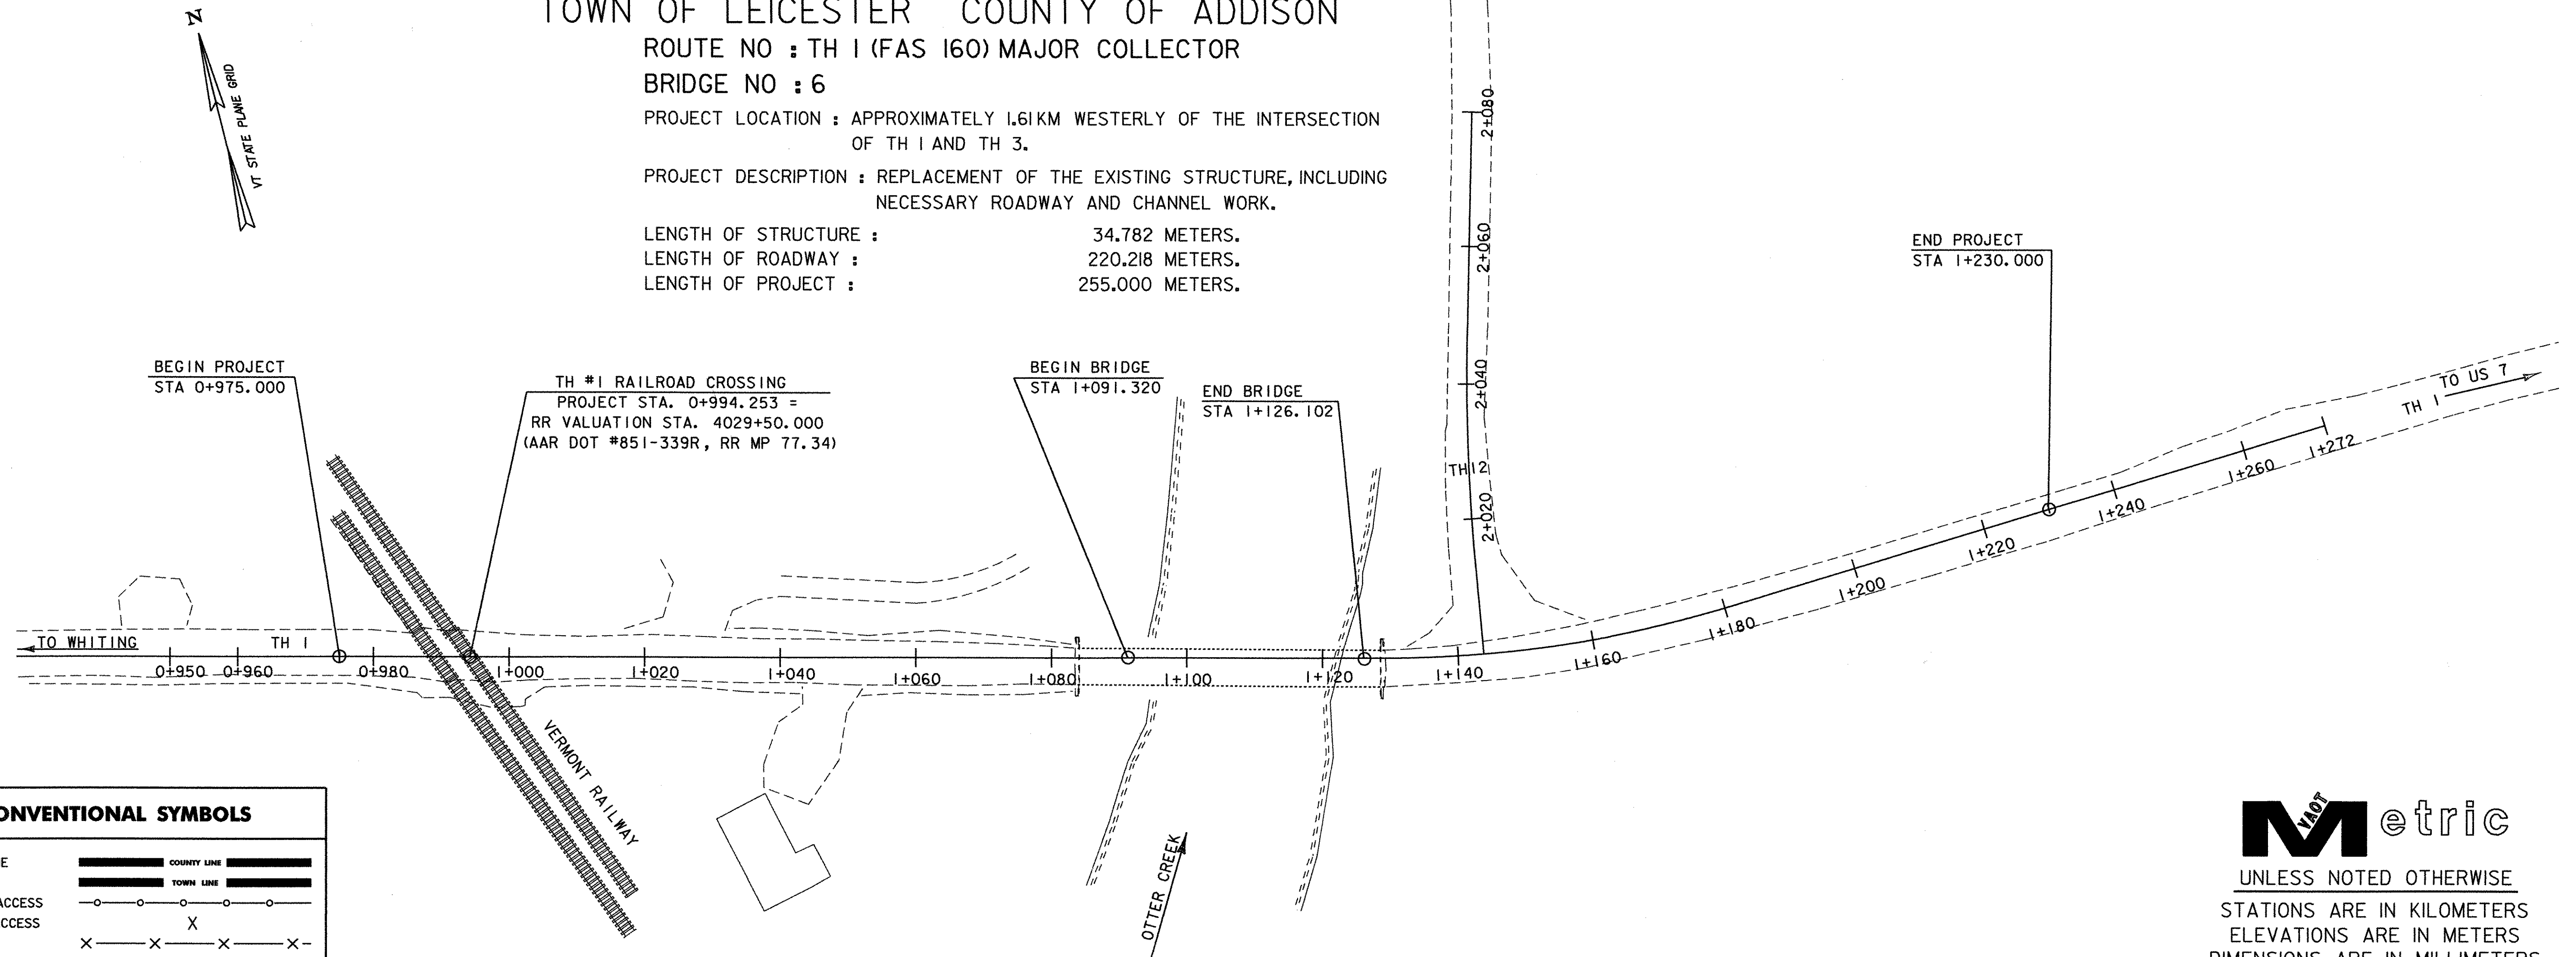

| CONVENTIONAL SYMBOLS | |
|----------------------|--|
| COUNTY LINE | |
| TOWN LINE | |
| LIMITS OF ACCESS | |
| POINT OF ACCESS | |
| FENCE LINE | |
| STONE WALL | |
| TRAVELED WAY | |
| GUARD RAIL | |
| RAILROAD | |
| SURVEY LINE | |
| CULVERT | |
| POWER POLE | |
| TELEPHONE POLE | |
| TREES | |
| CONTROL OF ACCESS | |
| PROPERTY LINE | |
| R.O.W. TAKING LINE | |
| SLOPE RIGHTS | |
| TOP OF CUT | |
| TOE OF SLOPE | |

SURVEYED BY : L. ORVIS
SURVEYED DATE : JUNE 1996

DATUM
VERTICAL NAVD88
HORIZONTAL NAD83 (92)

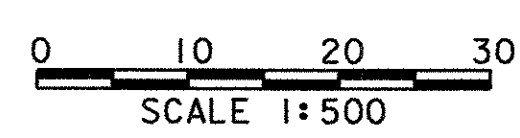

UNLESS NOTED OTHERWISE
STATIONS ARE IN KILOMETERS
ELEVATIONS ARE IN METERS
DIMENSIONS ARE IN MILLIMETERS

THESE PLANS ARE SUBJECT TO SUCH ENGINEERING CHANGES AS MAY BE REQUIRED BY THE FEDERAL HIGHWAY ADMINISTRATION OR THE DIRECTOR OF PROGRAM DEVELOPMENT.

CONSTRUCTION IS TO BE CARRIED ON IN ACCORDANCE WITH THESE PLANS AND THE STANDARD SPECIFICATIONS FOR CONSTRUCTION DATED 2001, AS APPROVED BY THE FEDERAL HIGHWAY ADMINISTRATION ON JANUARY 4, 2001 FOR USE ON THIS PROJECT, INCLUDING ALL SUBSEQUENT REVISIONS AND SUCH REVISED SPECIFICATIONS AND SPECIAL PROVISIONS AS ARE INCORPORATED IN THESE PLANS.

| | |
|-------------------------------------|--------------|
| DIRECTOR OF PROGRAM DEVELOPMENT | |
| APPROVED <i>Richard Tetreault</i> | DATE 7-15-05 |
| PROJECT MANAGER : ROGER R. WHITCOMB | |
| PROJECT NAME : LEICESTER | |
| PROJECT NUMBER : AC BRF 0160 (3) S | |
| SHEET 1 OF 90 SHEETS | |