



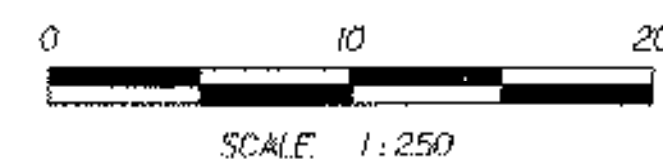

ANCHOR FOR STEEL BEAM RAIL
 ++243.900 RT
 1+245.168

GUARD RAIL HEAVY DUTY STEEL BEAM
 STA 1+160.000 - STA 1+245.420 RT
 1+247.298

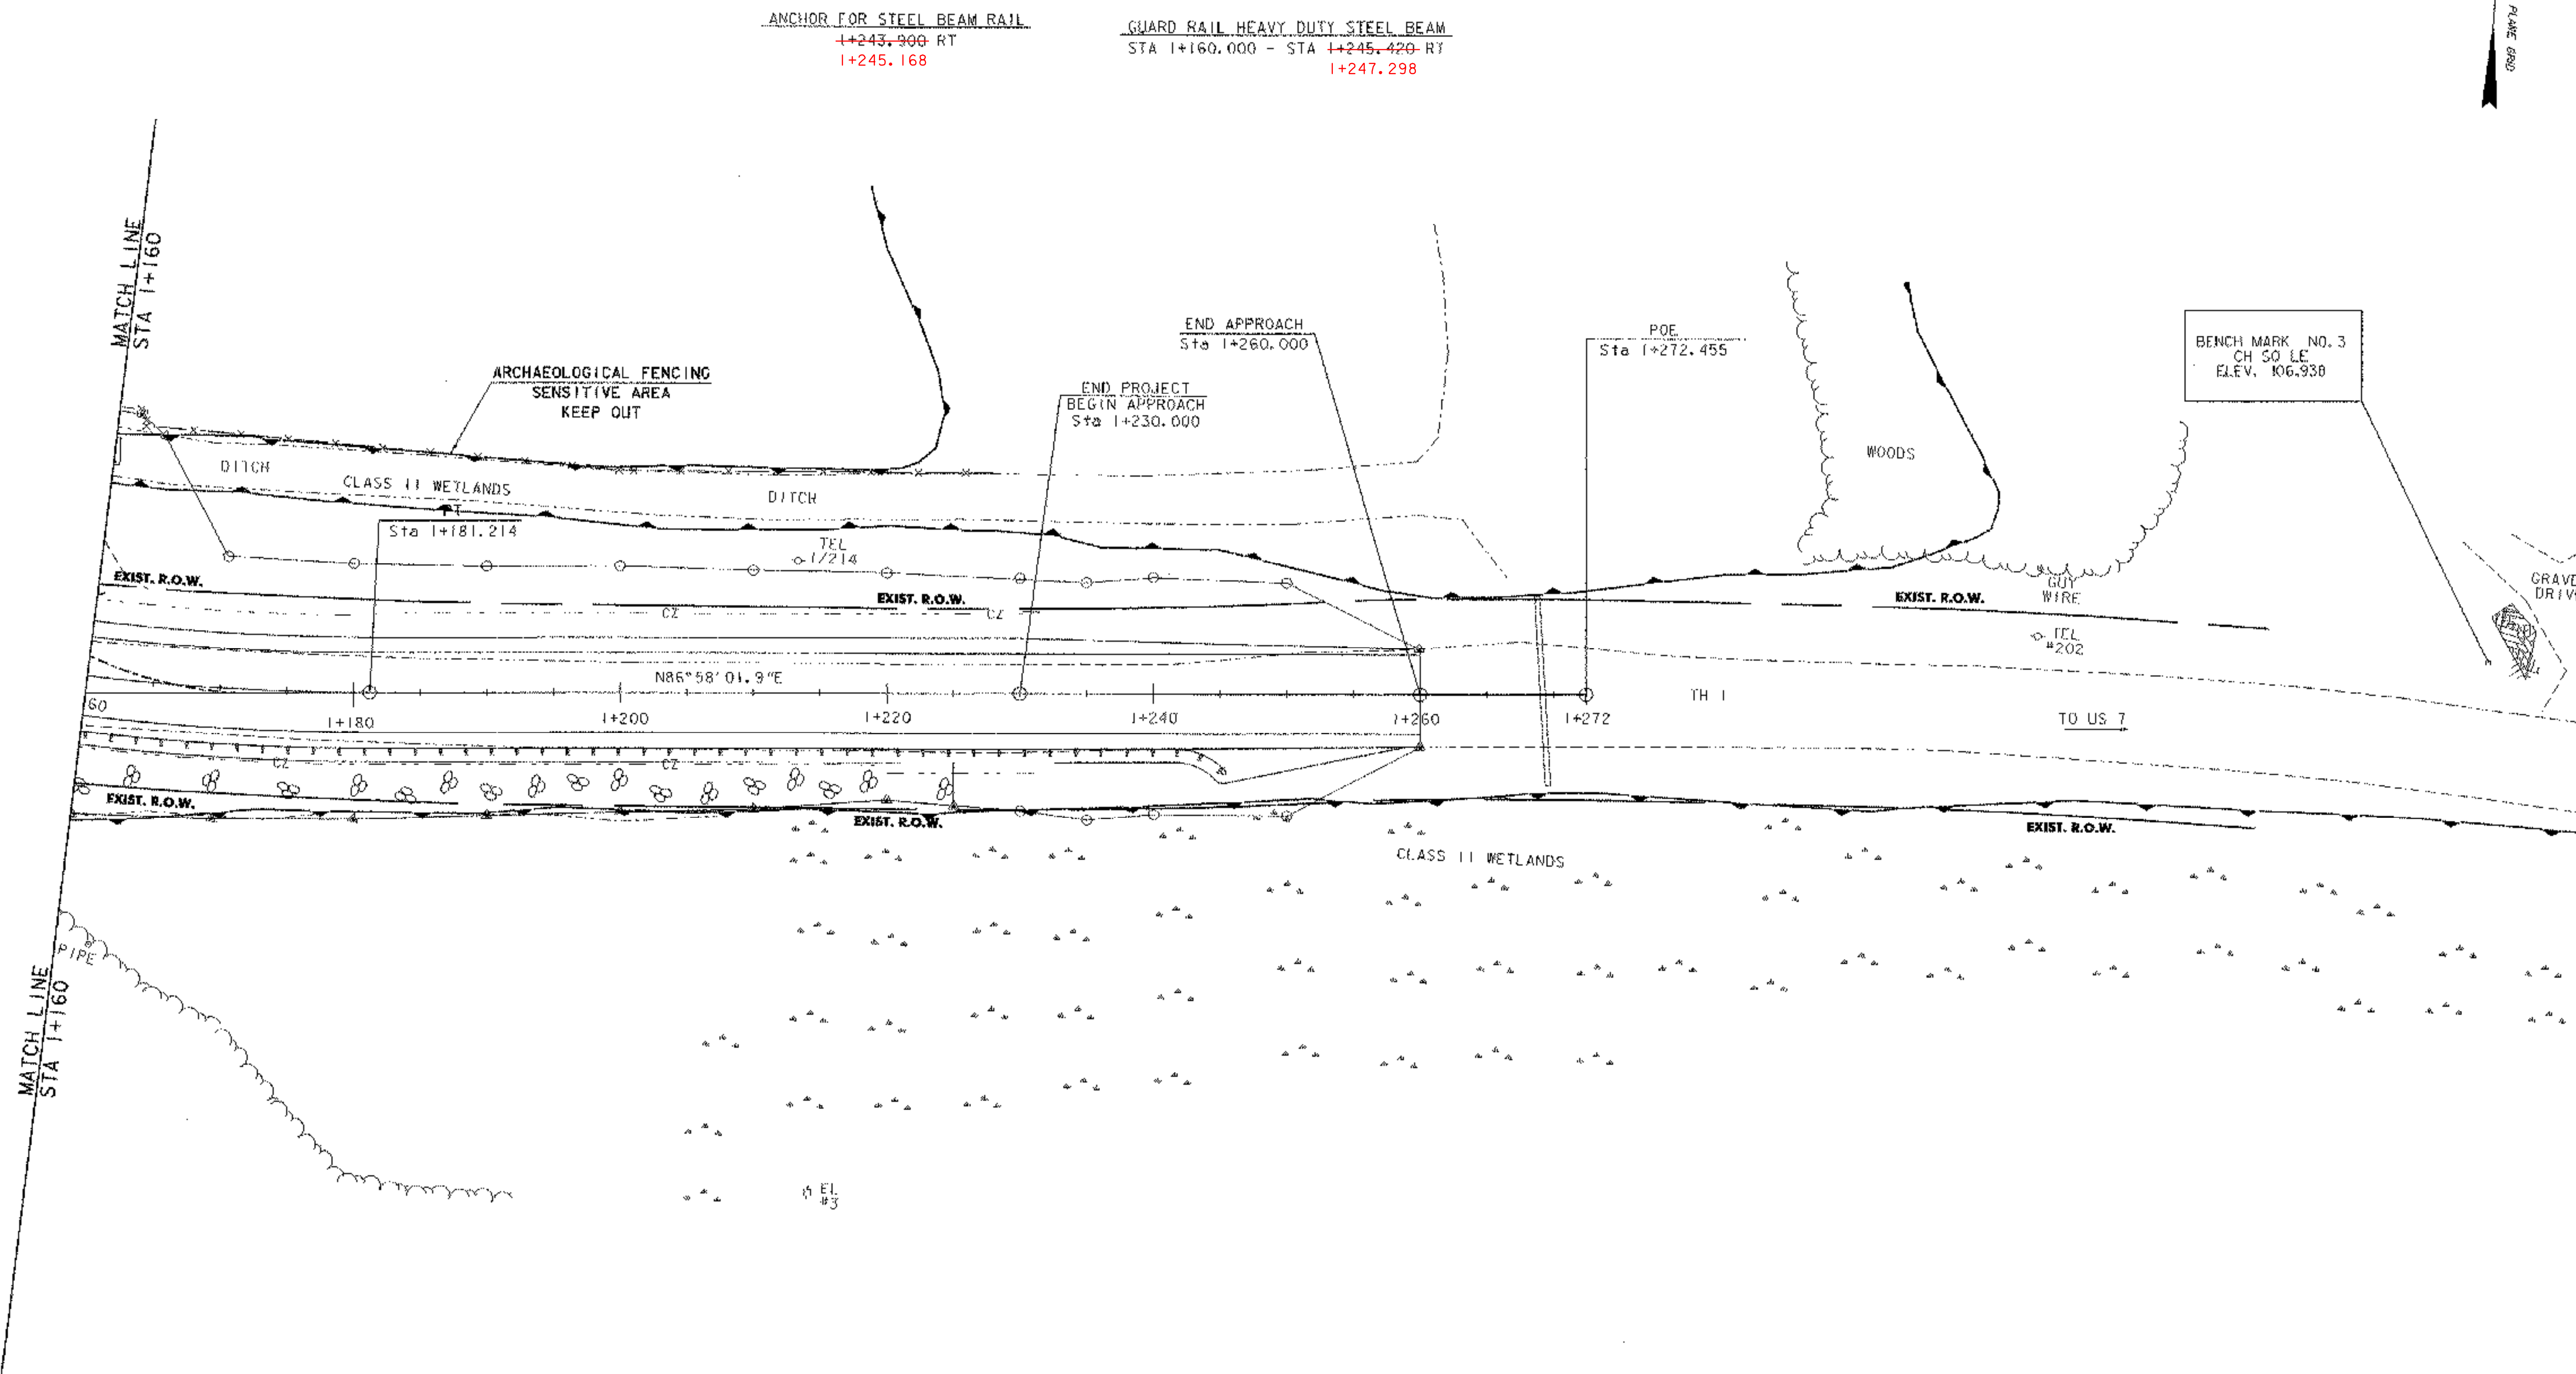

SHEET NAME: PLAN LAYOUT #3	
PROJECT NAME: LEICESTER	HIGHWAY NO.: FAS 0160
PROJECT NUMBER: BRF 0160(3)S	BRIDGE NO.: 6
	OVER: OTTER CREEK
FILE NAME: 95j288\Structures\sj288bdr.dgn	PLOT DATE: 17-AUG-2005
PROJECT MANAGER: R. R. WHITCOMB	DRAWN BY: J. GILMORE
DESIGNED BY: C. CARLSON	IPARM NAME: sj088ps3.1
BRIDGE SHEET NUMBER:	SHEET 13 OF 90