


Profile TH 1

NOTE:

GRADES SHOWN TO THE NEAREST HUNDREDTH ARE THE EXISTING GROUND ALONG THE CENTERLINE. GRADES SHOWN TO THE NEAREST THOUSANDTH ARE THE PROPOSED FINISHED GRADE ALONG THE CENTERLINE.

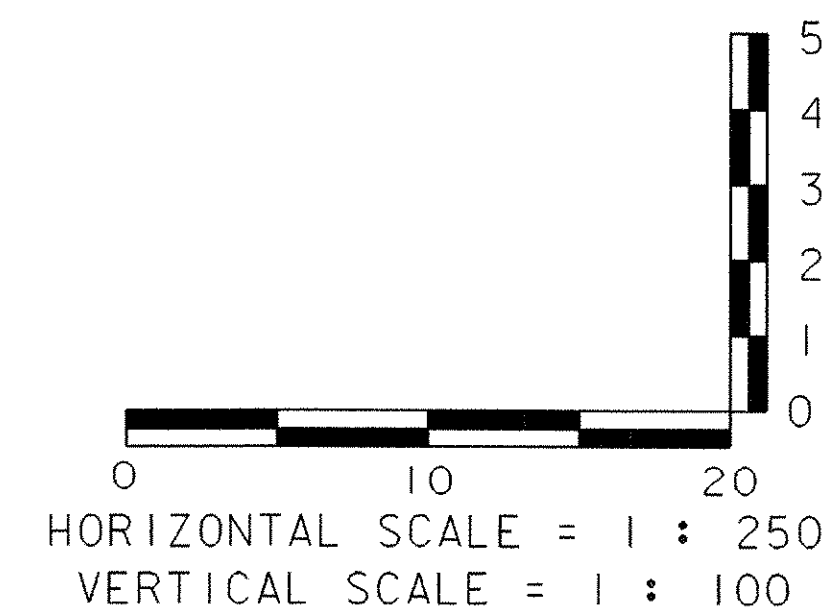

SHEET NAME: MAINLINE PROFILE SHEET 2	
PROJECT NAME: LEICESTER	HIGHWAY NO.: FAS 0160
PROJECT NUMBER: BRF 0160(3)S	BRIDGE NO.: 6
	OVER: OTTER CREEK
FILE NAME: 95j288\Structures\sj288xsl.dgn	PLOT DATE: 17-AUG-2005
PROJECT MANAGER: R. R. WHITCOMB	DRAWN BY: J. GILMORE
DESIGNED BY: C. CARLSON	IPARM NAME: sj088pr2.1
	SHEET 15 OF 90